


111 Tribeca Cir, South Fallsburg, NY 12779

- A1, A2, A3, A4 & A5 THESE DOCUMENTS ARE THE PROPERTY OF THE DESIGNER AND SHALL NOT BE COPIED, DUPLICATED, ALTERED, MODIFIED OR REVISED IN ANY WAY WITHOUT THE WRITTEN APPROVAL OF THE DESIGNER.
- CONTRACTOR SHALL VERIFY ALL CONDITIONS AND DIMENSIONS AT THE SITE AND ALL INCONSISTENCIES SHALL BE BROUGHT TO THE ATTENTION OF THE DEVELOPER AND THE DESIGNER BEFORE PROCEEDING WITH THE WORK.
- ANY ERRORS OR OMISSIONS FOUND IN THESE DRAWINGS SHALL BE BROUGHT TO DEVELOPERS AND DESIGNERS ATTENTION IMMEDIATELY.
- DO NOT SCALE DRAWINGS. WRITTEN DIMENSIONS TAKE PRECEDENCE OVER SCALED DIMENSIONS.
- ALL DIMENSIONS ARE TO FACE OF STUD OR TO FACE OF FRAMING UNLESS OTHERWISE NOTED.
- ALL TRUSS DRAWINGS TO BE REVIEWED AND APPROVED BY THE STRUCTURAL ENGINEER PRIOR TO ISSUANCE OF BUILDING PERMIT.
- ALL OR EQUAL SUBSTITUTIONS MUST BE SUBMITTED TO AND APPROVED BY CITY BUILDING OFFICIAL PRIOR TO INSTALLATION.
- ALL ELECTRICAL AND MECHANICAL EQUIPMENT AND METERS ARE SUBJECT TO RELOCATION DUE TO FIELD CONDITIONS, CONTRACTOR TO VERIFY.
- DAMP PROOFING - ONE COAT CONTINUOUS ELASTOMERIC WATERPROOFING FROM GRADE LEVEL TO BOTTOM OF FOUNDATION.
- SHOP DRAWING REVIEW AND DISTRIBUTION, ALONG WITH PRODUCT SUBMITTALS, REQUESTED IN THE CONSTRUCTION DOCUMENTS, SHALL BE THE SOLE RESPONSIBILITY OF THE GENERAL CONTRACTOR, UNLESS DIRECTED OTHERWISE UNDER A SEPARATE AGREEMENT.
- DEVIATIONS FROM THESE DOCUMENTS IN THE CONSTRUCTION PHASE SHALL BE REVIEWED BY THE DESIGNER AND THE OWNER PRIOR TO THE START OF WORK IN QUESTION. ANY DEVIATIONS FROM THESE DOCUMENTS WITHOUT PRIOR REVIEW, SHALL BE THE SOLE RESPONSIBILITY OF THE GENERAL CONTRACTOR.
- THE GENERAL CONTRACTOR SHALL BE RESPONSIBLE FOR ALL WORK AND MATERIALS REPRESENTED ON THESE DOCUMENTS INCLUDING THE WORK AND MATERIALS FURNISHED BY SUBCONTRACTORS AND VENDORS.
- THE BUILDER SHALL FURNISH ART AND ALL REPORTS RECEIVED FROM THE GEOTECHNICAL ENGINEER (SOILS REPORT), ON THE STUDY OF THE PROPOSED SITE, TO THE DESIGNER, STRUCTURAL ENGINEER, AND GENERAL CONTRACTOR. IN THE EVENT THE GEOTECHNICAL REPORTS DO NOT EXIST, THE SOILS CONDITION SHALL BE ASSUMED TO BE A MINIMUM DESIGN SOIL PRESSURE STATED BY THE STRUCTURAL ENGINEER OF RECORD FOR THE PURPOSE OF STRUCTURAL DESIGN. GENERAL CONTRACTOR SHALL ASSURE THE SOIL CONDITIONS MEET OR EXCEED THE CRITERIA.
- ALL WORK PERFORMED BY THE GENERAL CONTRACTOR SHALL COMPLY AND CONFORM WITH LOCAL AND STATE BUILDING CODES, ORDINANCES AND REGULATIONS, ALONG WITH ALL OTHER AUTHORITIES HAVING JURISDICTION. THE GENERAL CONTRACTOR IS RESPONSIBLE TO BE AWARE OF THESE REQUIREMENTS AND GOVERNING REGULATIONS.
- WINDOW SUPPLIER TO VERIFY AT LEAST ONE WINDOW IN ALL BEDROOMS TO HAVE A CLEAR EGRESS OPENING OF 5.7 SQ FT WITH MIN. DIMENSION OF 24" IN HEIGHT AND 20" IN WIDTH.

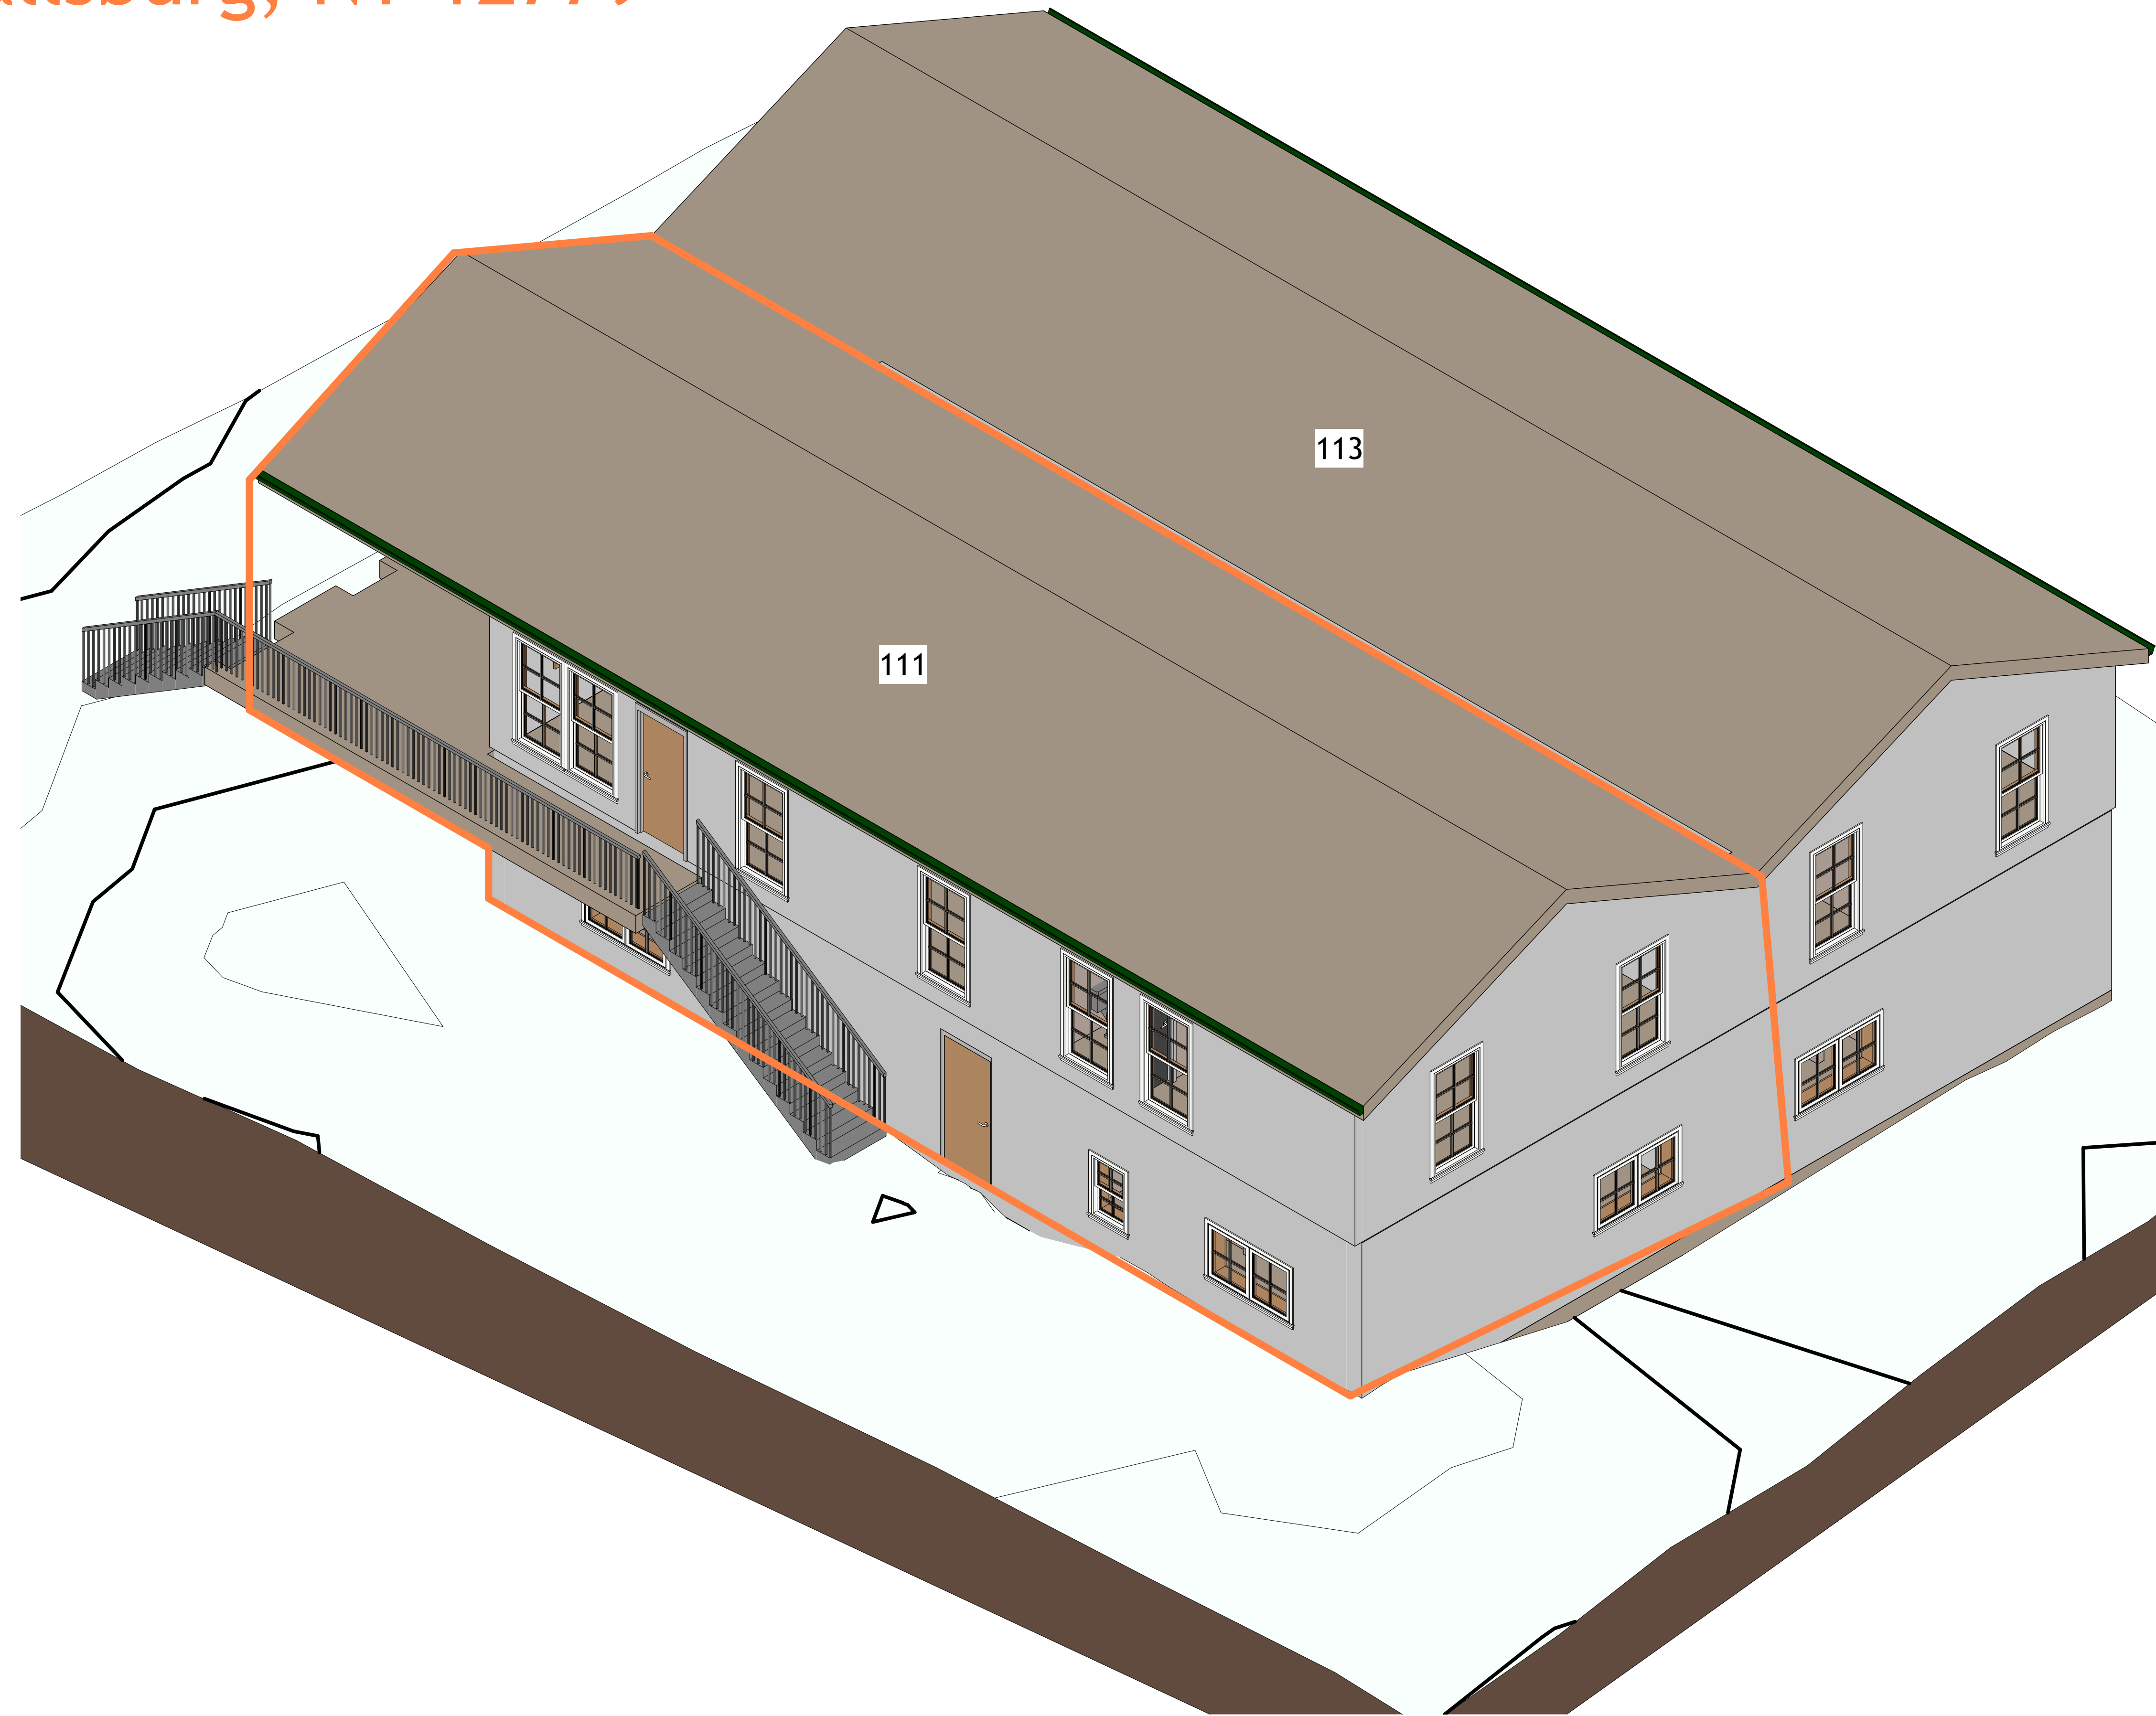



Sheet Index	
Sheet Number	Sheet Name
General	
A000	Cover
B000	Cover
Architectural	
A101	Architectural Floor Plans
A102	Architectural Floor Plans
A204	Architectural Building Elevations
A205	Architectural Building Elevations
A206	Architectural Building Elevations
A301	Architectural Building Elevations
A302	Architectural Building Elevations
A303	Architectural Building Elevations
A304	Architectural Building Elevations
A401	Architectural Enlarged Views
A402	Architectural Enlarged Views
A501	Architectural Details
B101	Architectural Floor Plans

Room Finish Schedule			
Room Number	Room Name	Area	Level
100	Local	Not Placed	Not Placed
101	Storage	Not Placed	Not Placed
102	Bath	Not Placed	Not Placed
103	Stairs	Not Placed	Not Placed
104	Hall	Not Placed	Not Placed
105	Bath	Not Placed	Not Placed
106	Table area	Not Placed	Not Placed
107	Kitchen	Not Placed	Not Placed
108	Table area	Not Placed	Not Placed
109	Storage	Not Placed	Not Placed
110	Storage	Not Placed	Not Placed
111	Kitchen	Not Placed	Not Placed
112	Fridge	Not Placed	Not Placed
113	Machine Room	Not Placed	Not Placed
114	Bath	Not Placed	Not Placed
115	Room	Not Placed	Not Placed
116	Room	Not Placed	Not Placed
117	Room	Not Placed	Not Placed
118	Room Name	Not Placed	Not Placed
119	Room Name	Not Placed	Not Placed
120	Room	Not Placed	Not Placed

Working Sheet List			
Sheet Number	Sheet Name	Sheet Sort	Sheet Group
A000	Cover	000	General
B000	Cover	000	General
A101	Architectural Floor Plans	070	Architectural
A102	Architectural Floor Plans	070	Architectural
A204	Architectural Building Elevations	070	Architectural
A205	Architectural Building Elevations	070	Architectural
A206	Architectural Building Elevations	070	Architectural
A301	Architectural Building Elevations	070	Architectural
A302	Architectural Building Elevations	070	Architectural
A303	Architectural Building Elevations	070	Architectural
A304	Architectural Building Elevations	070	Architectural
A401	Architectural Enlarged Views	070	Architectural
A402	Architectural Enlarged Views	070	Architectural
A501	Architectural Details	070	Architectural
B101	Architectural Floor Plans	070	Architectural
B102	Architectural Floor Plans	070	Architectural
B204	Architectural Building Elevations	070	Architectural
B205	Architectural Building Elevations	070	Architectural
B206	Architectural Building Elevations	070	Architectural
B301	Architectural Building Elevations	070	Architectural
B302	Architectural Building Elevations	070	Architectural
B303	Architectural Building Elevations	070	Architectural
B304	Architectural Building Elevations	070	Architectural
B401	Architectural Enlarged Views	070	Architectural
B402	Architectural Enlarged Views	070	Architectural
B501	Architectural Details	070	Architectural

Level Schedule				
Name	Elevation Base	Elevation	Structural	Story Above
L1 ARQ	Project Base Point	-8.74	No	Default
L2 ARQ	Project Base Point	1.26	No	Default
L2 Ceiling ARQ	Project Base Point	10.26	No	Default
Cover ARQ	Project Base Point	15.76	No	Default

1 3D 111

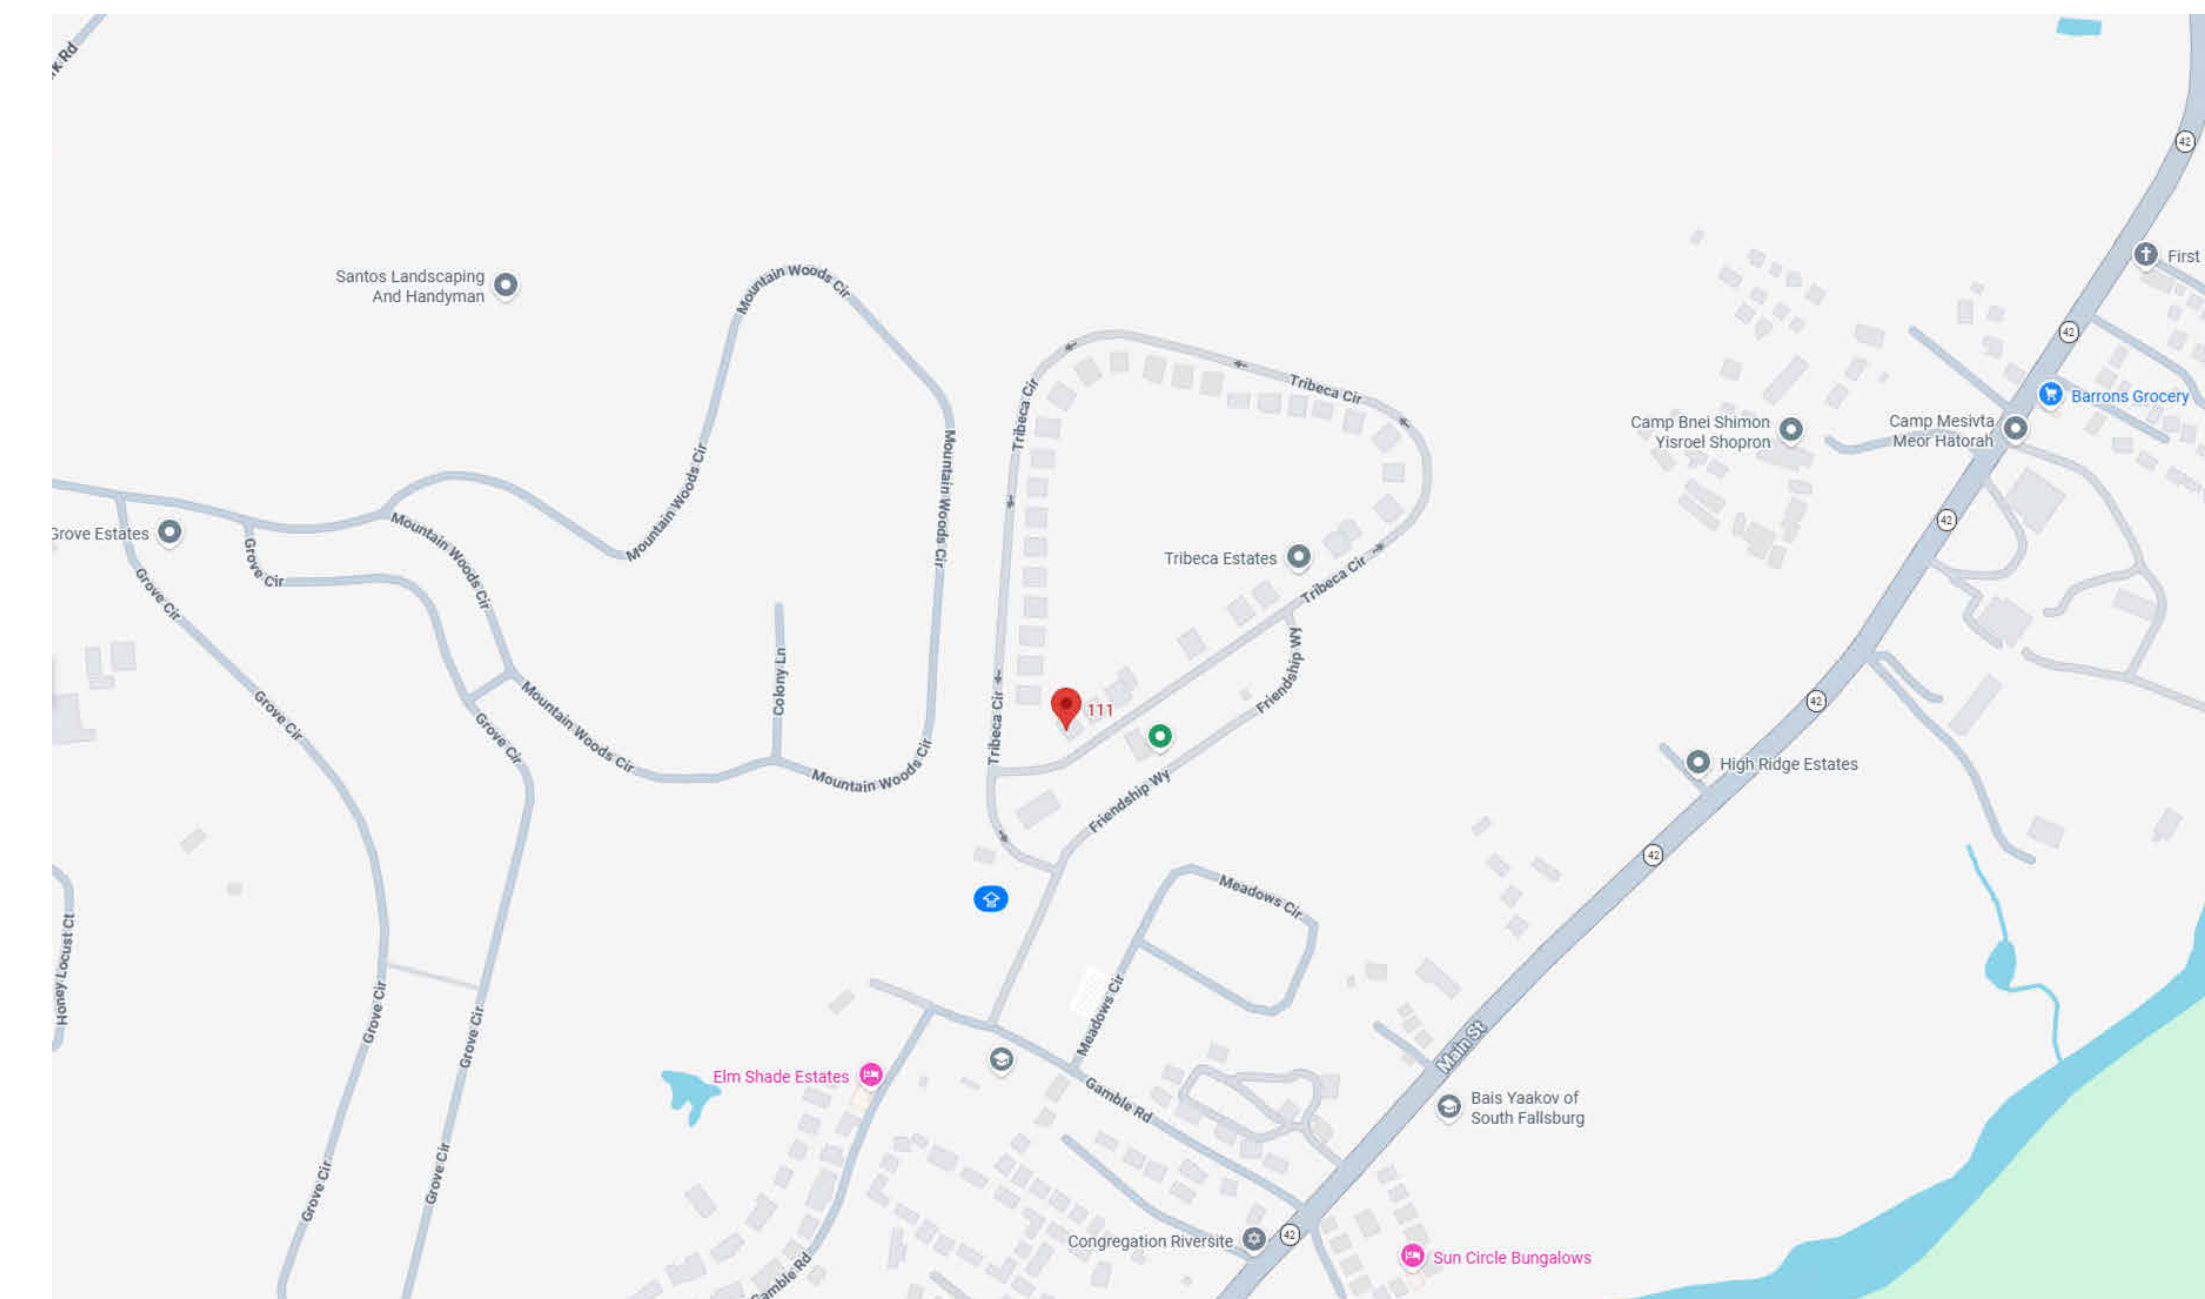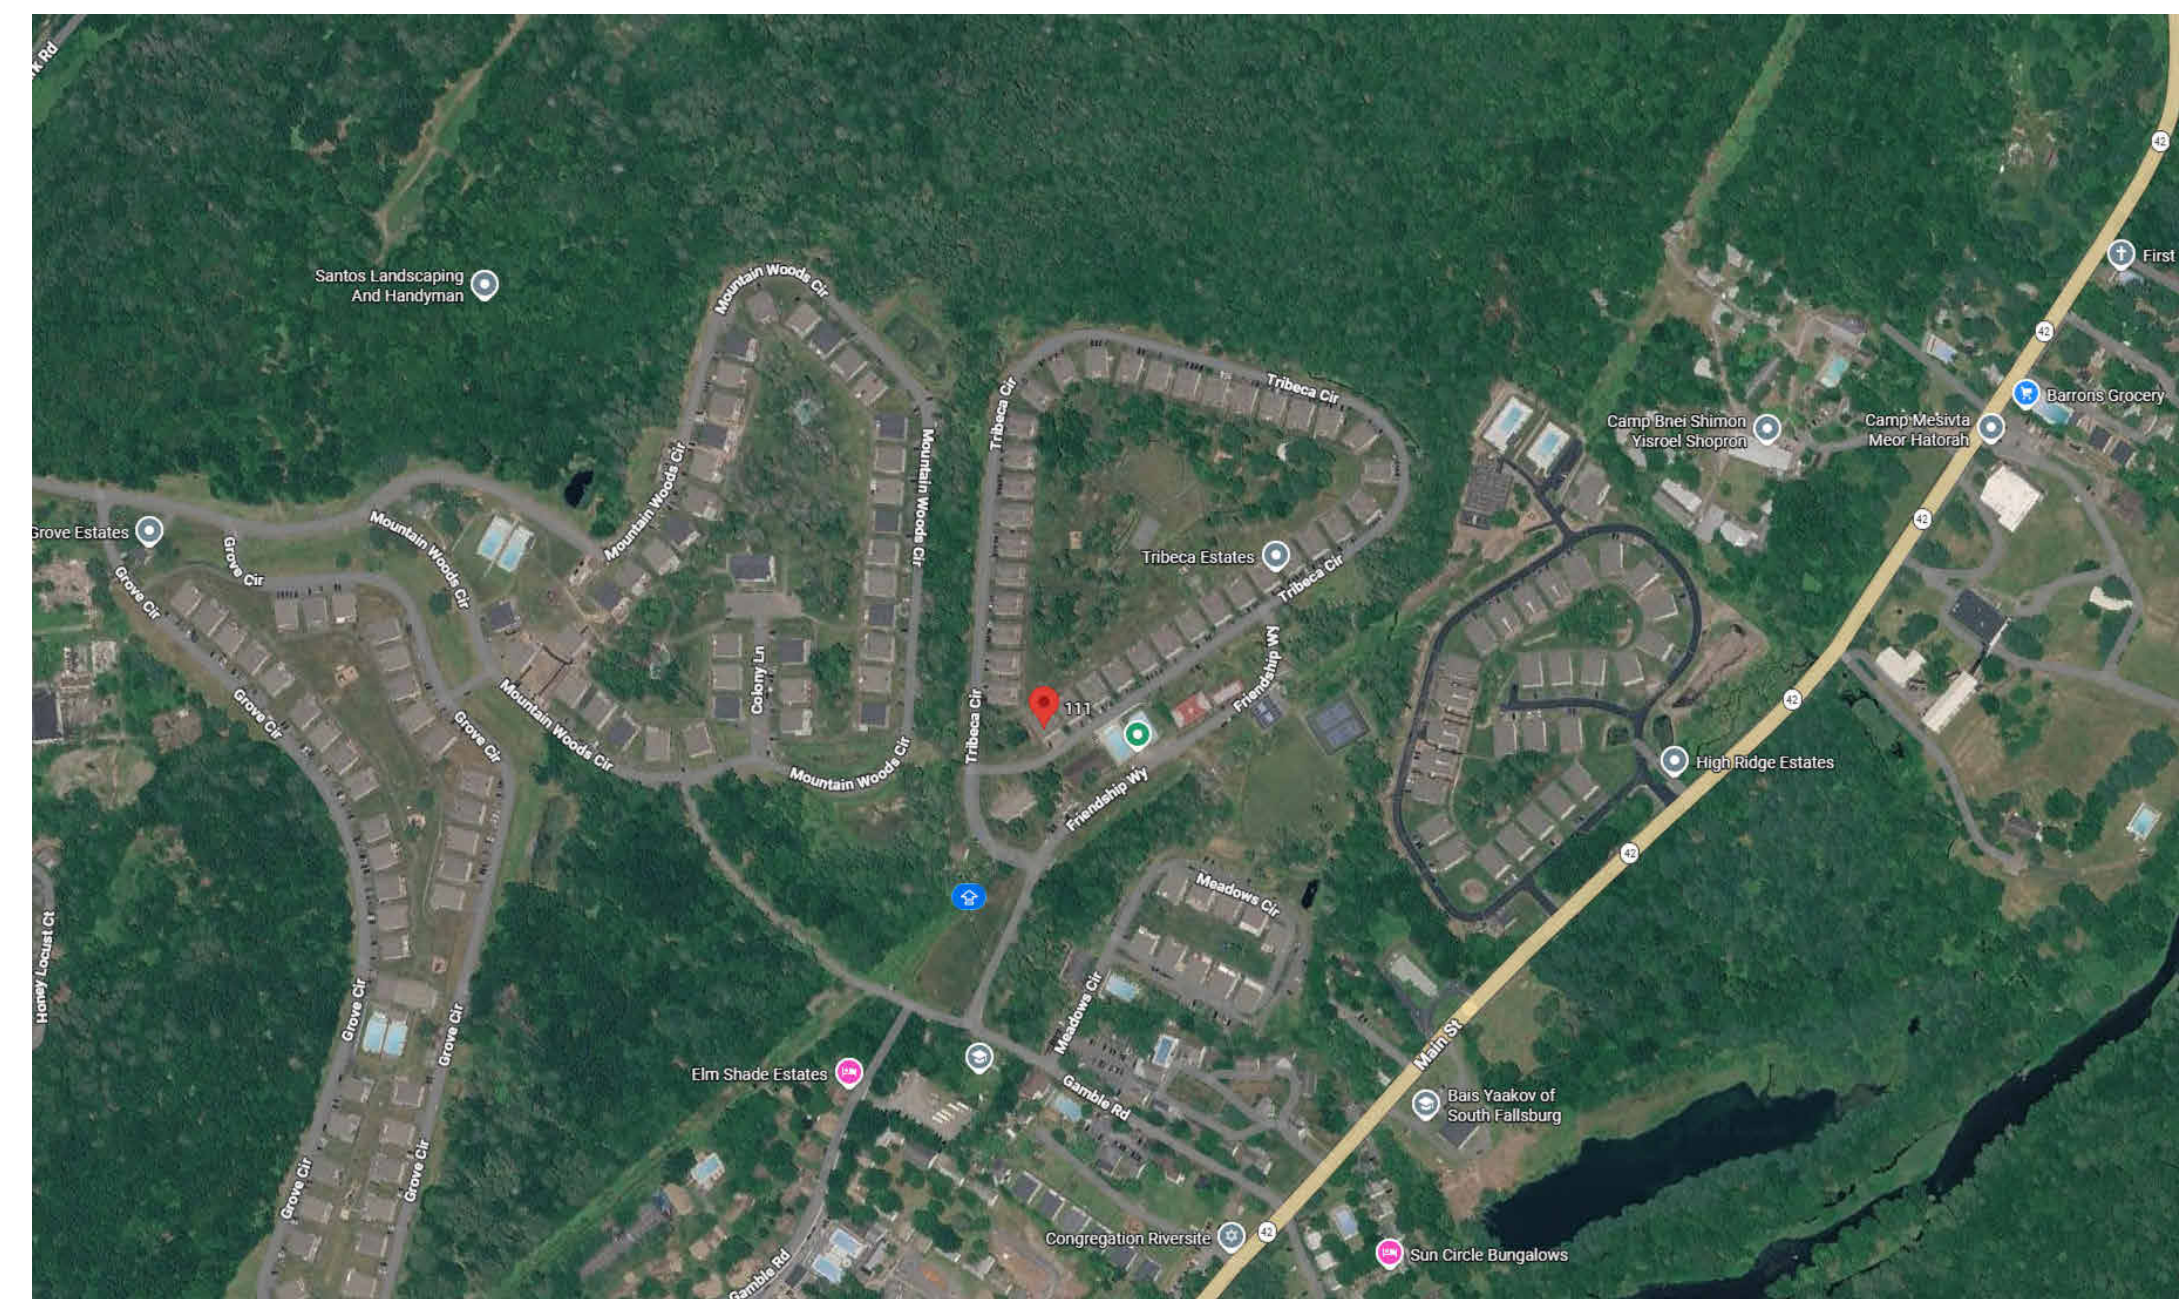

TECHSCAN
Surveying As Built and Geospatial Solutions

Project Name

Cover

Project number Project Number

Date Issue Date

Checked by Checker

A000


Scale



18 Spencer St, Brooklyn, NY 11205
info@techscanusa.com
TechScanusa.com
(929) 484-9098



1 West Architectural Building
Elevation
1:50

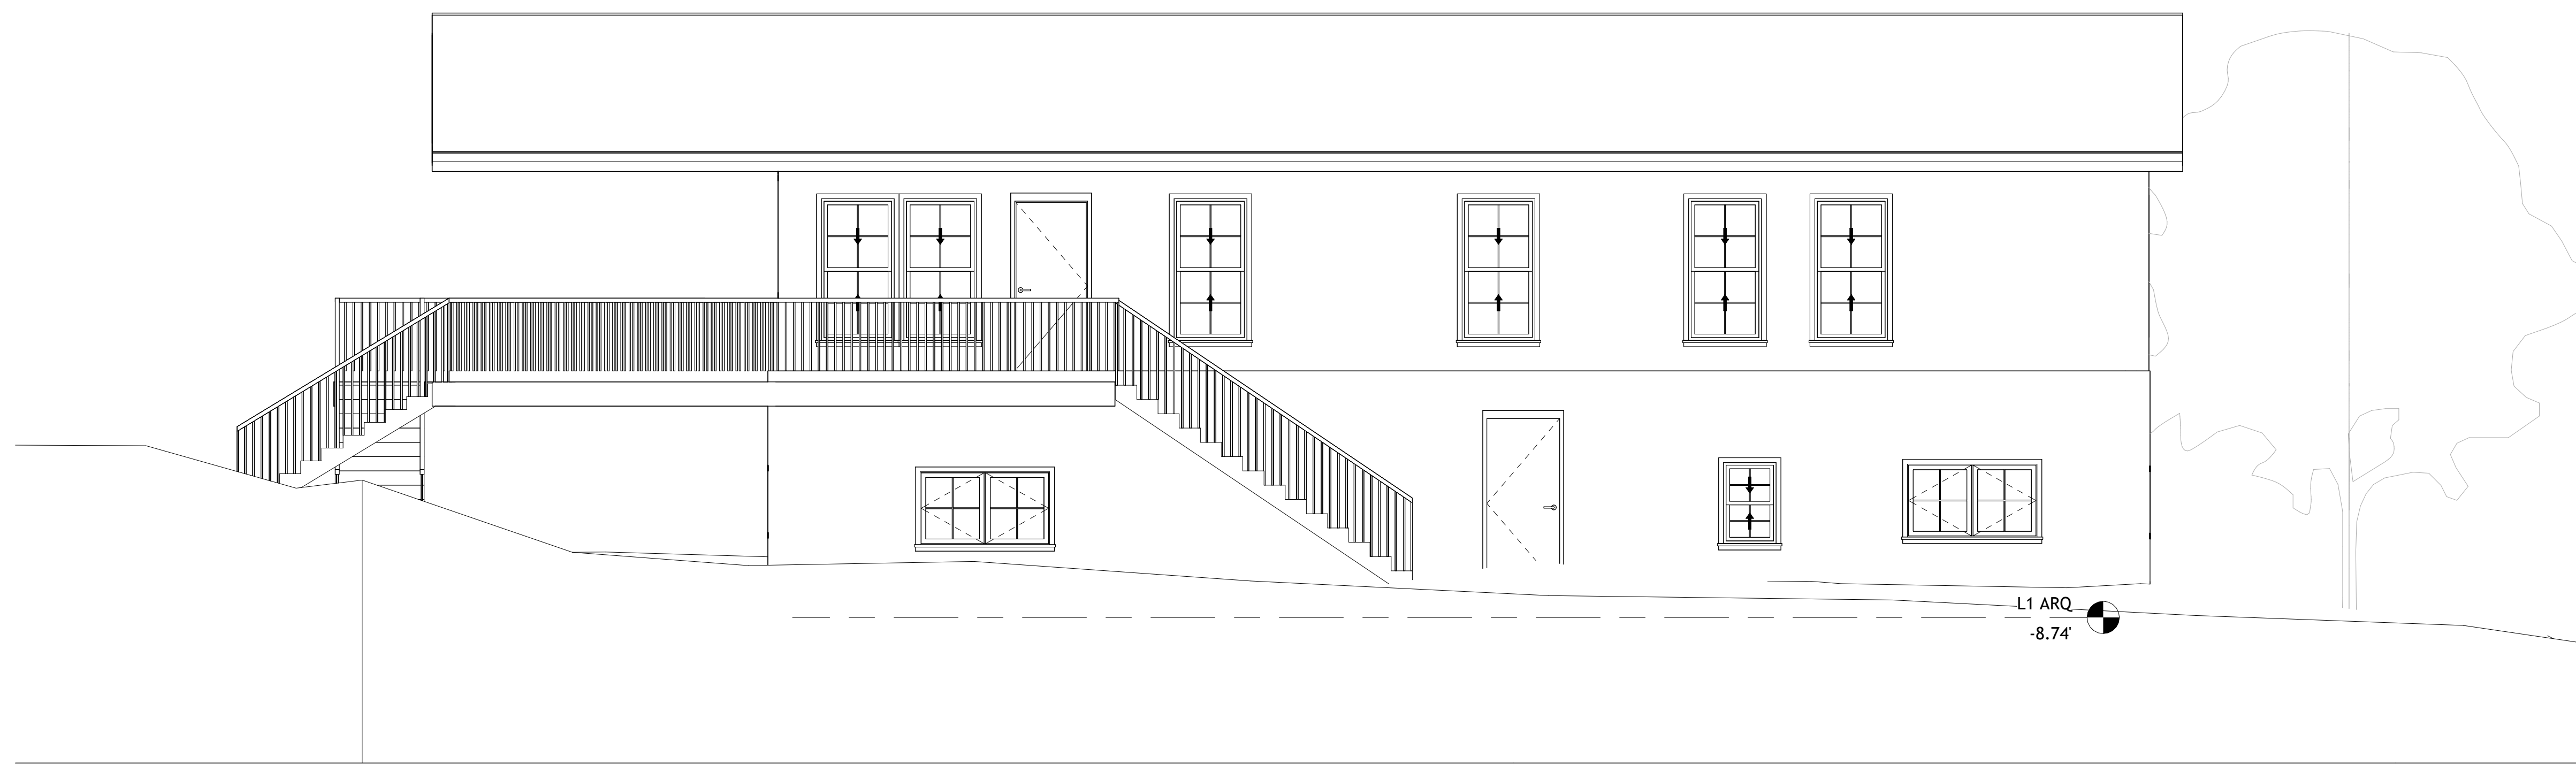

2 West Architectural Building
Elevation
1:50




TECHSCAN
Surveying As Builds and Geospatial Solutions


Project Name	Architectural Building Elevations
Project number	Project Number
Date	Issue Date
Checked by	Checker
A204	
Scale	1 : 50



18 Spencer St, Brooklyn,
NY 11205
info@techscanusa.com
TechScanusa.com
(929) 486-9038

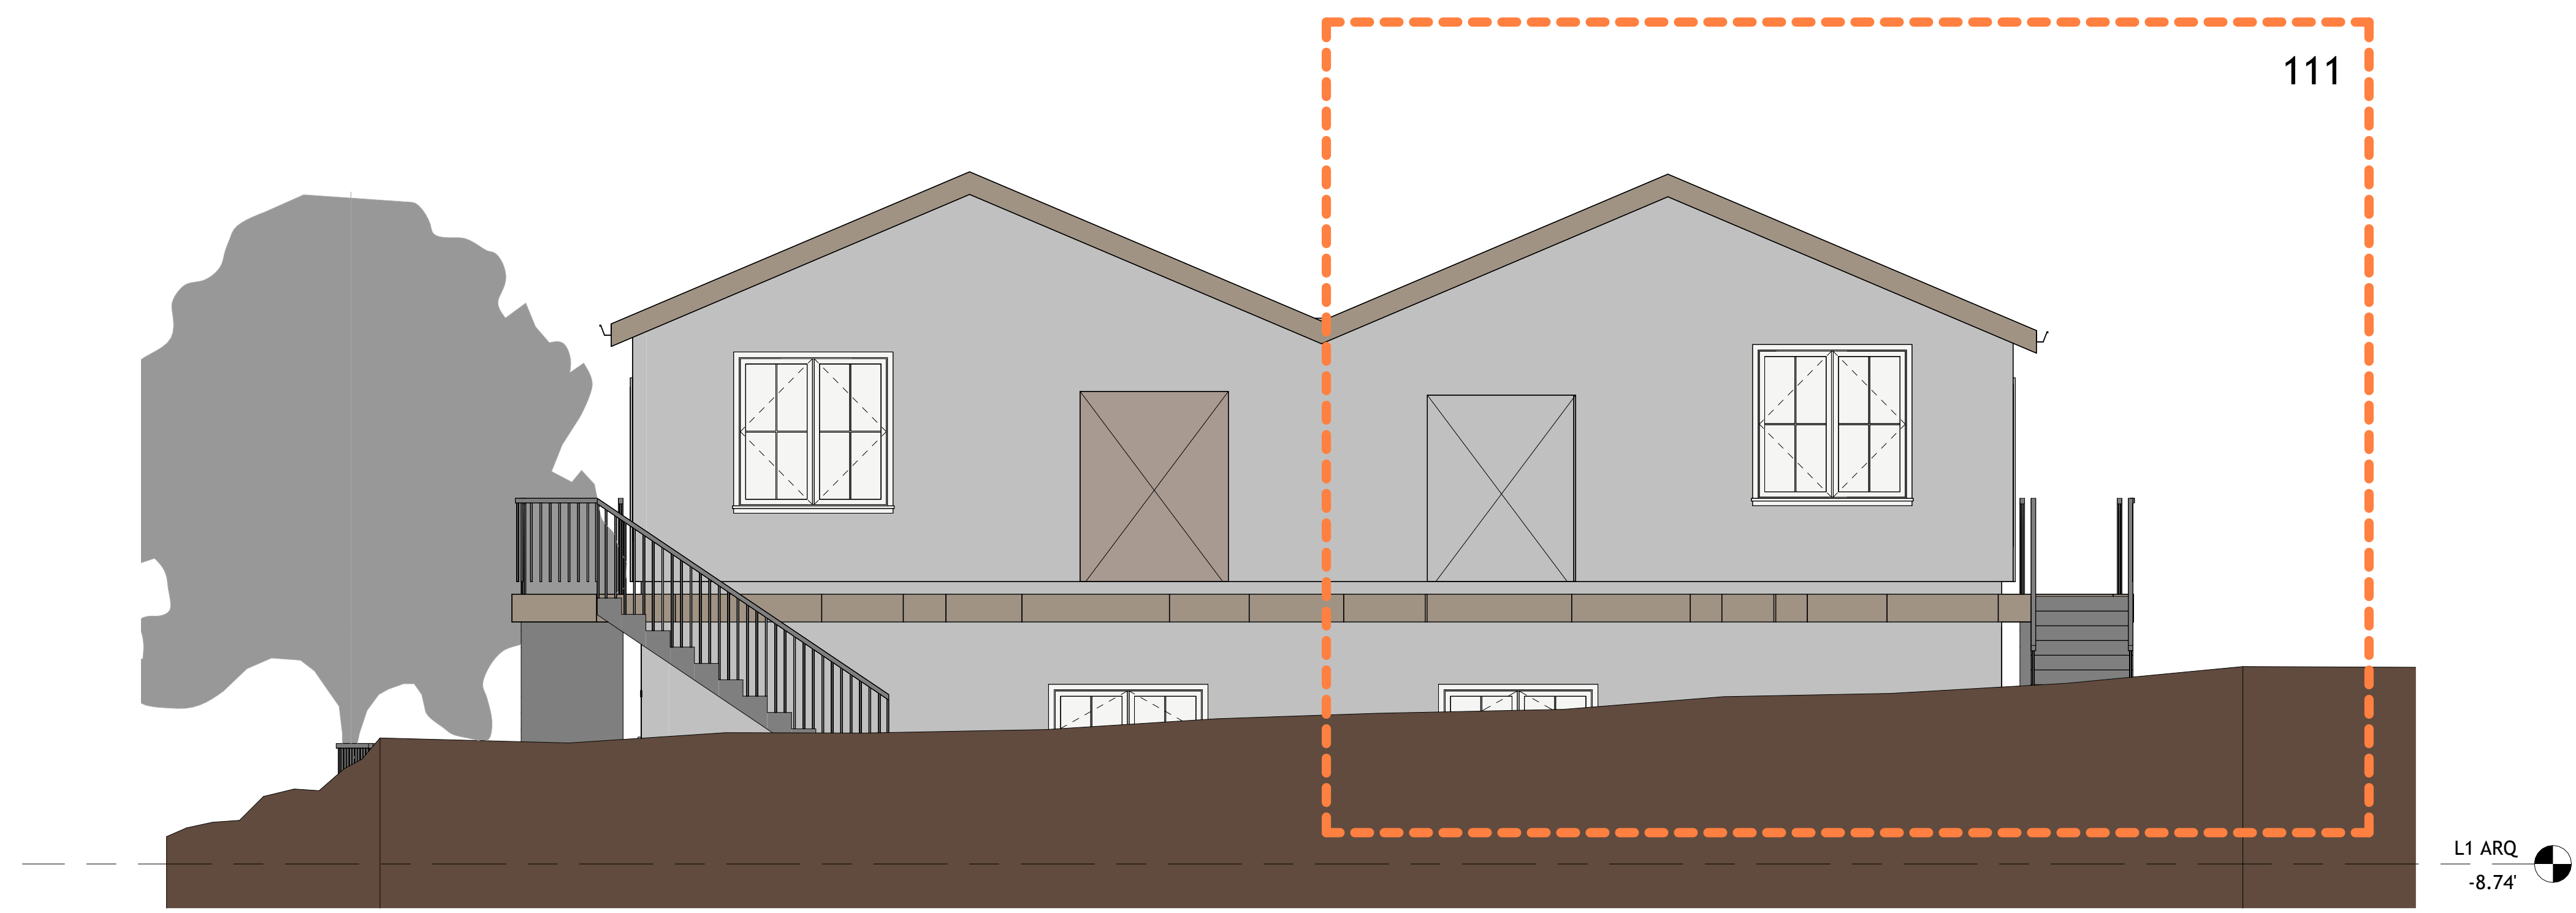

① North Architectural Building
Elevation
1:50

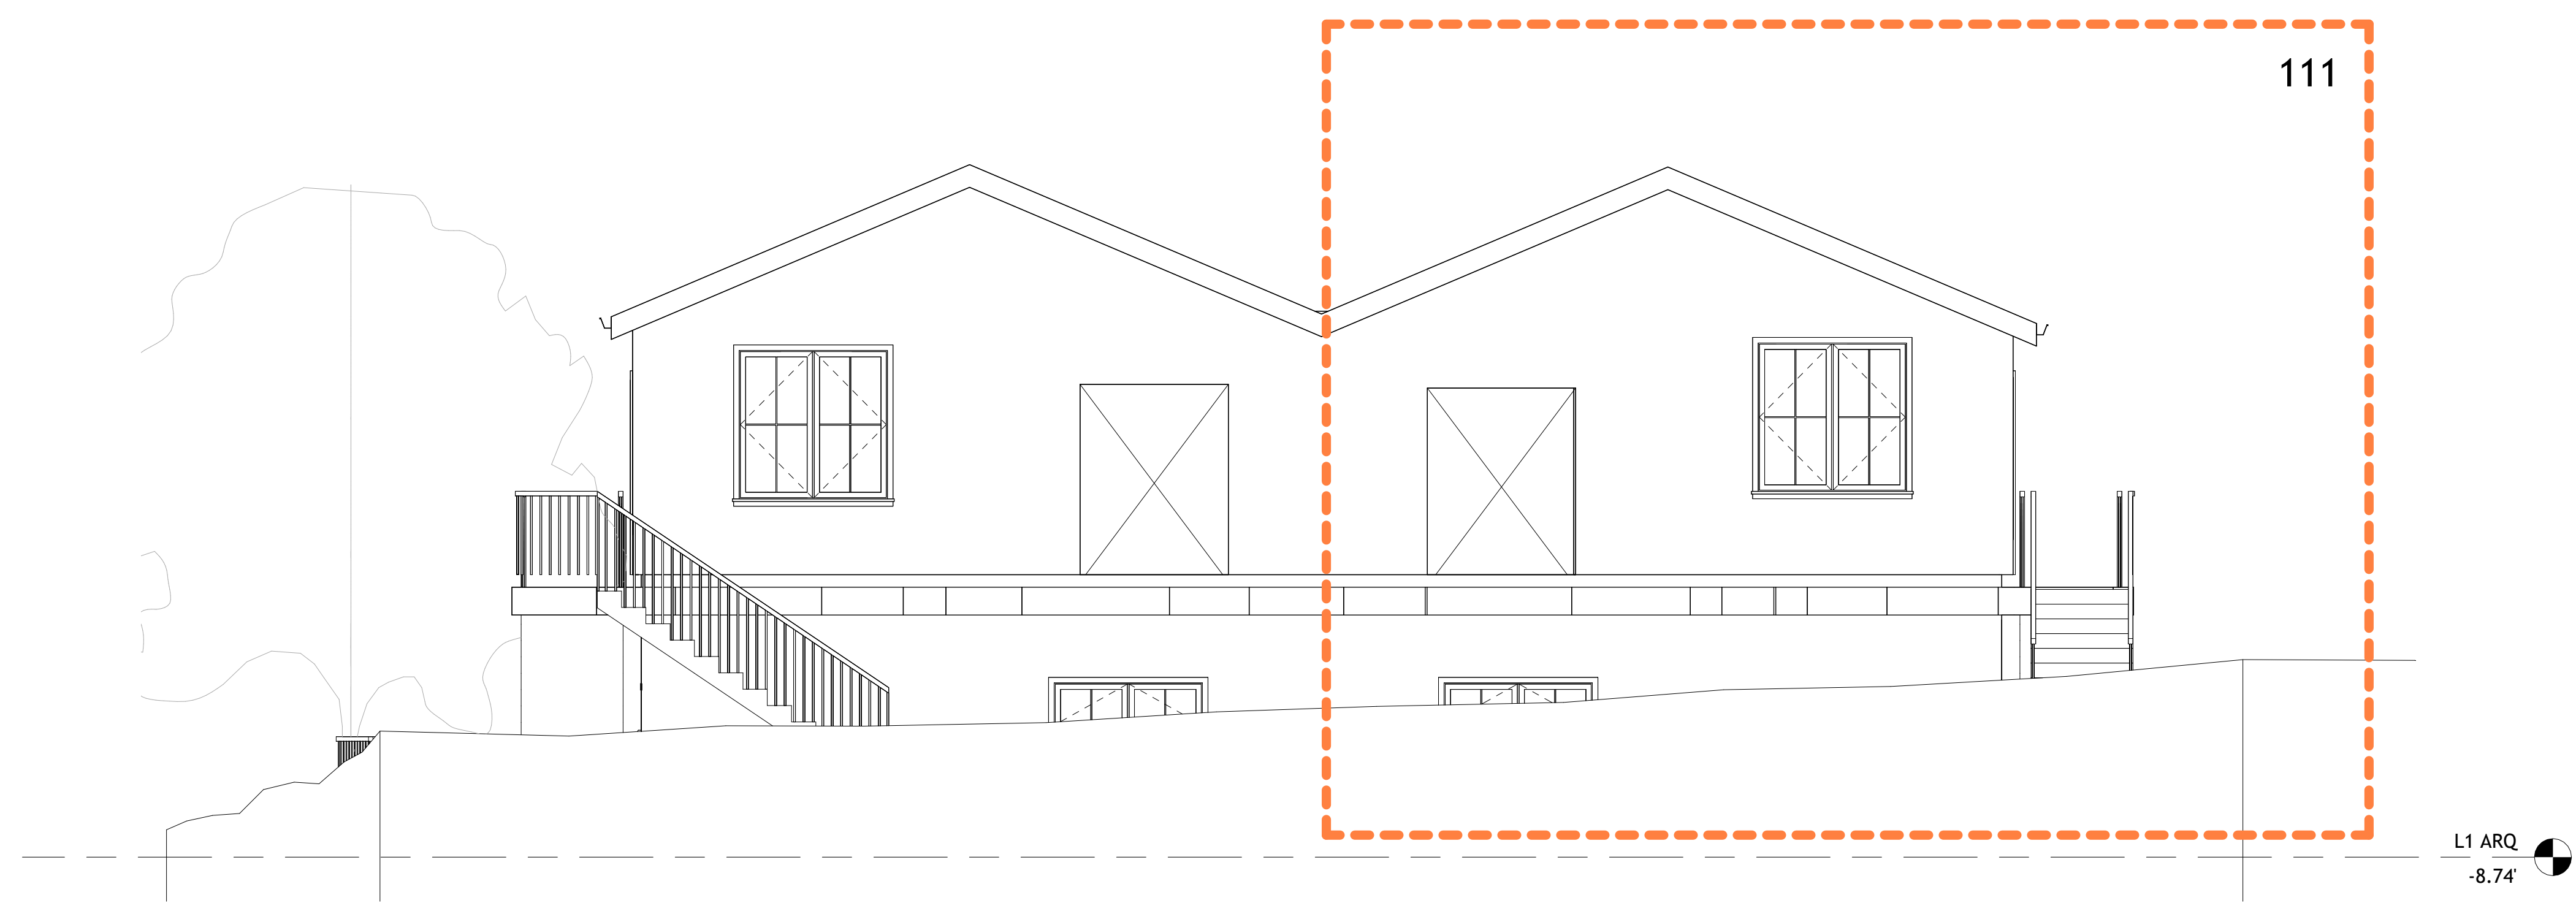

② North Architectural Building
Elevation
1:50



TECHSCAN
Surveying As Builds and Geospatial Solutions


Project Name	Architectural Building Elevations
Project number	Project Number
Date	Issue Date
Checked by	Checker
	A205
Scale	1 : 50



18 Spencer St, Brooklyn,
NY 11205
info@techscanusa.com
TechScanusa.com
(929) 486-9031



South Architectural Building
 ① Elevation
 1:50

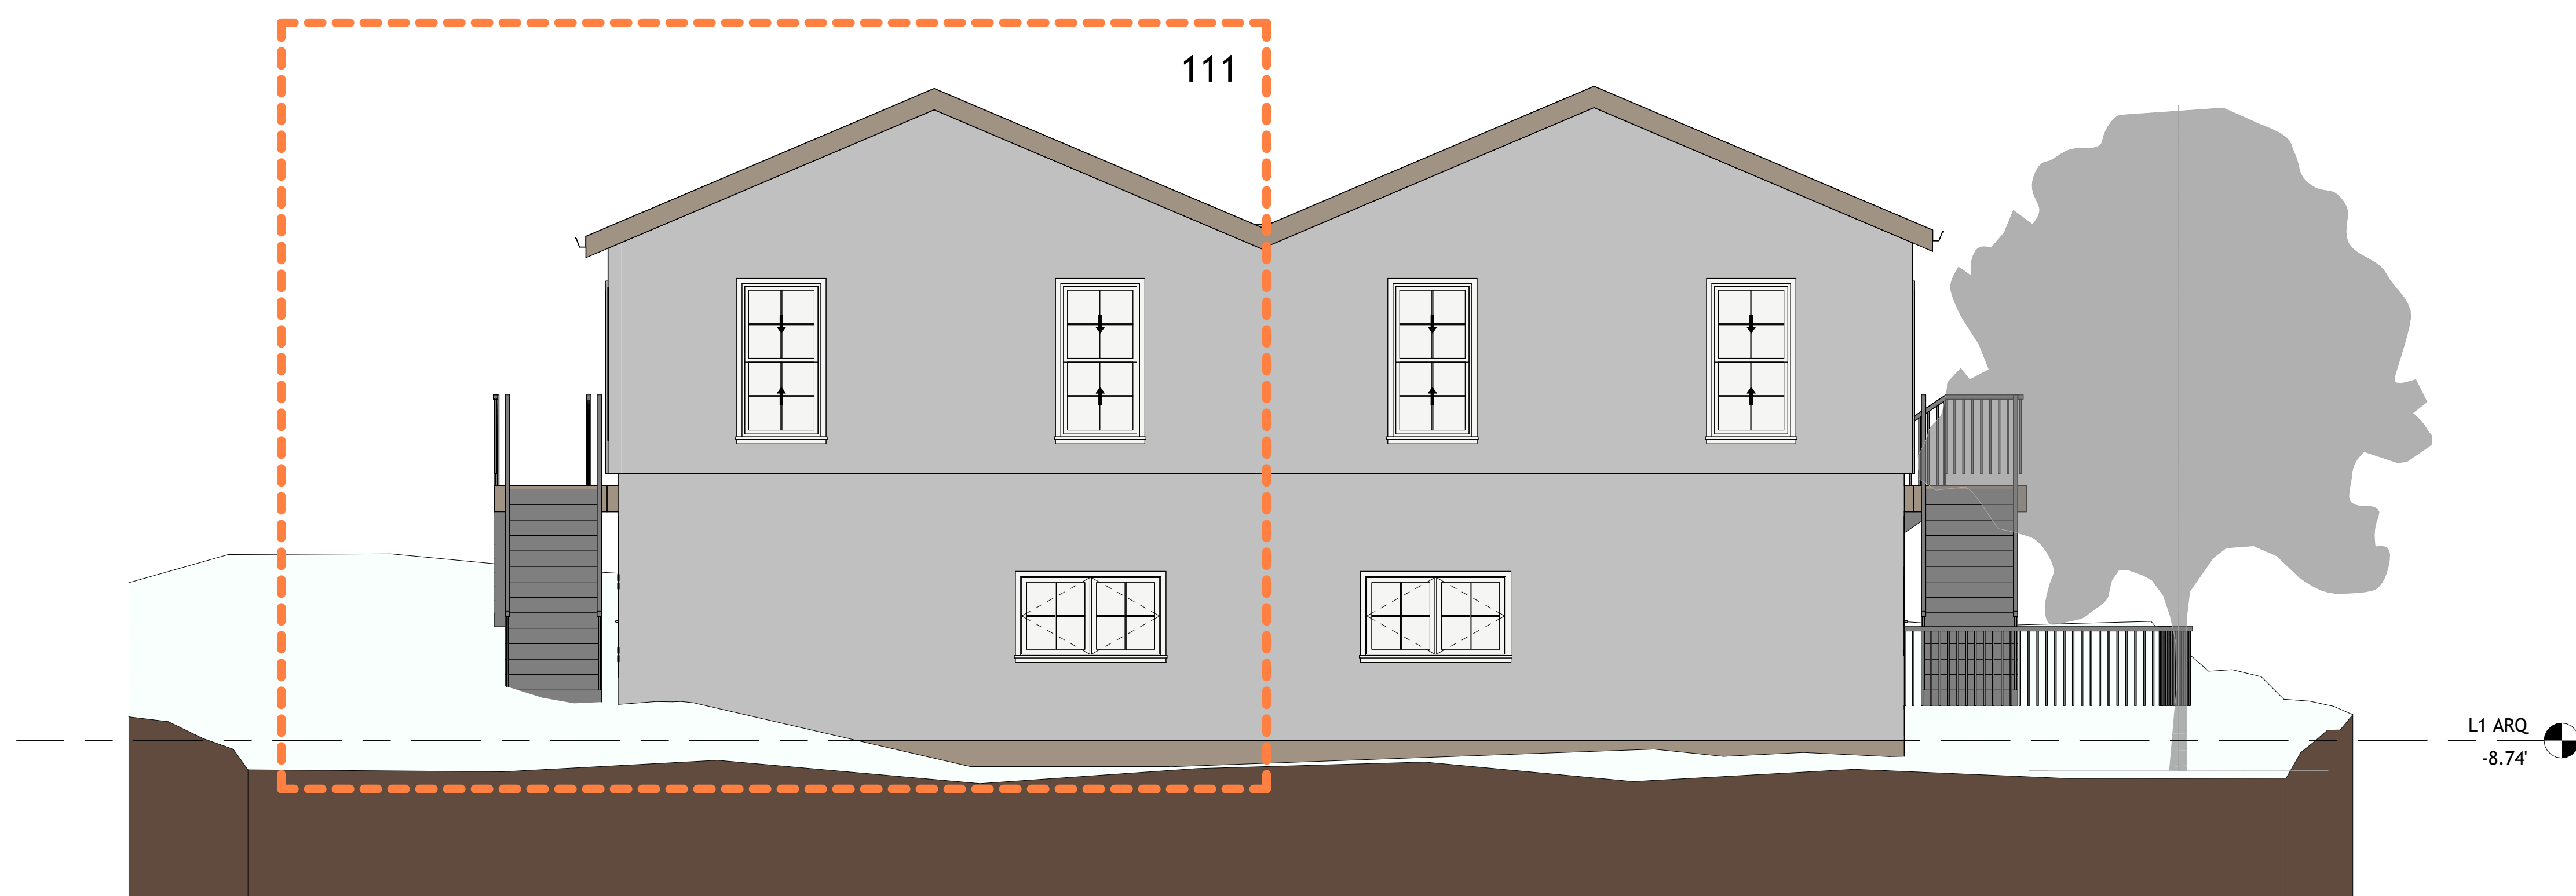

South Architectural Building
 ② Elevation
 1:50



TECHSCAN
 Surveying As Builds and Geospatial Solutions


Project Name	Architectural Building Elevations
Project number	Project Number
Date	Issue Date
Checked by	Checker
	A206
Scale	1 : 50



18 Spencer St, Brooklyn,
 NY 11205
info@techscanusa.com
TechScanusa.com
 (929) 486-9038



1 Section 6 111
1:50

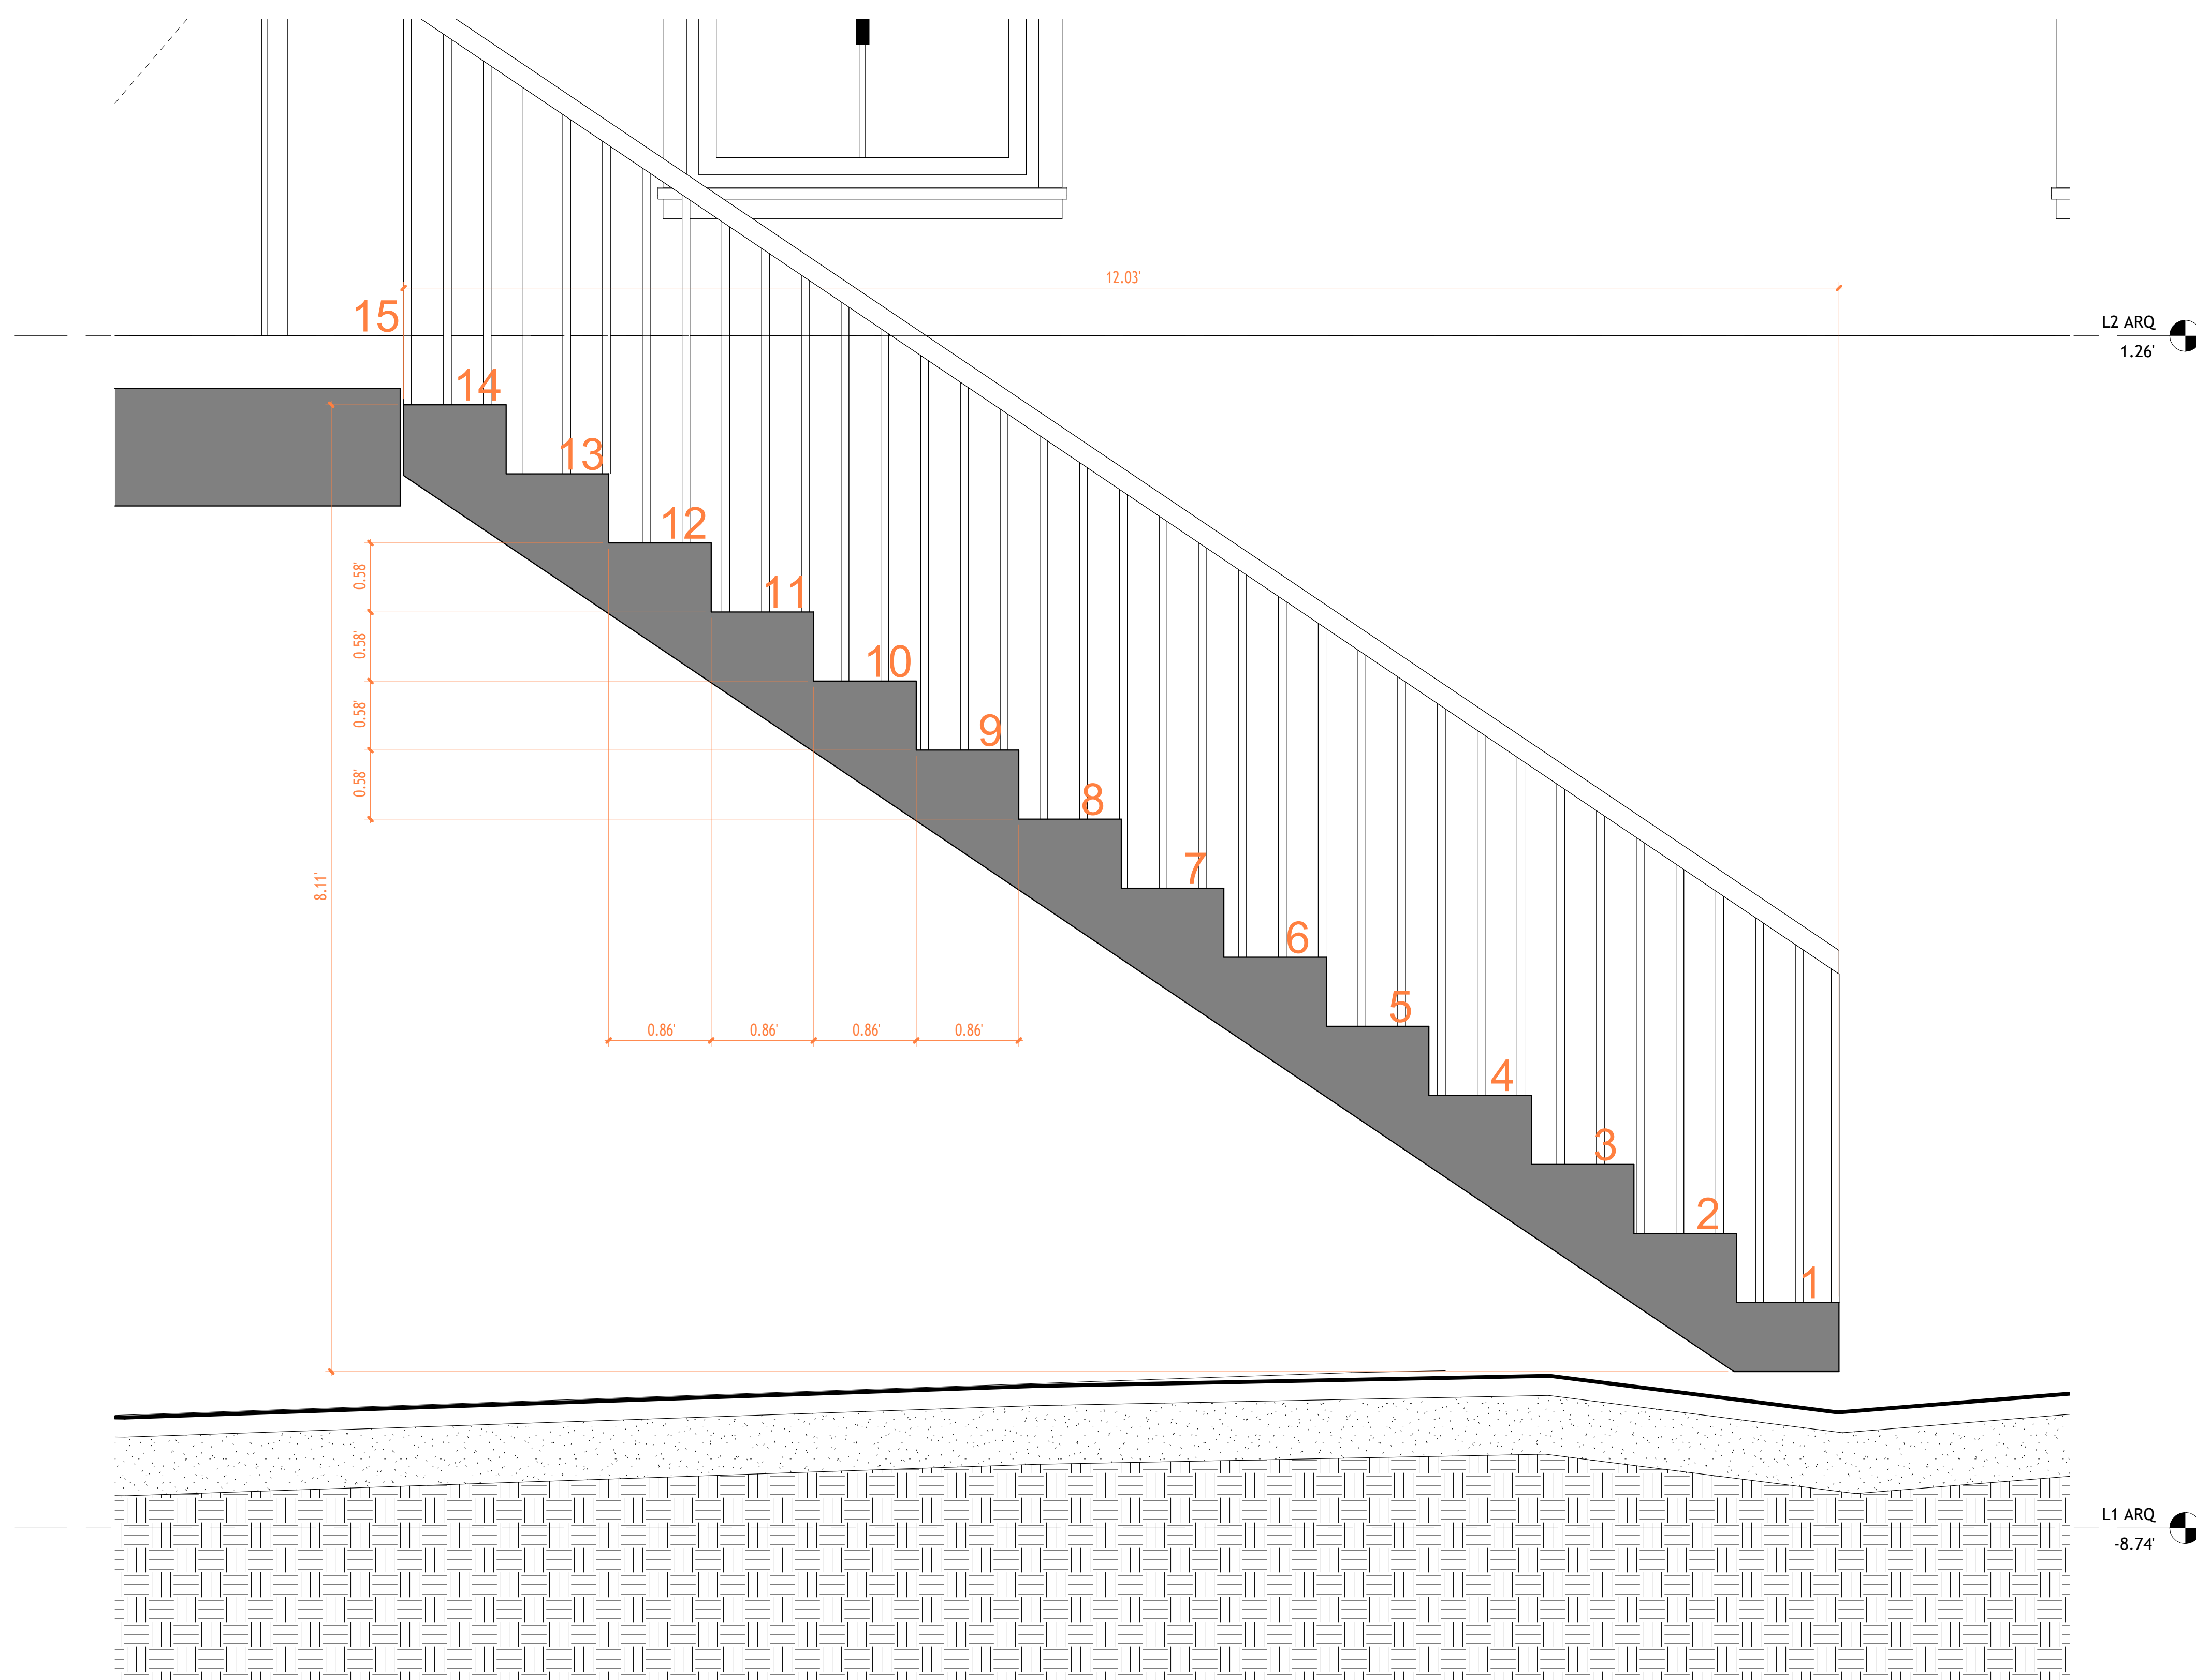

2 Section 6 Copy 111
1:10




TECHSCAN
Surveying As Builds and Geospatial Solutions

Project Name	
Architectural Building Elevations	
Project number	Project Number
Date	Issue Date
Checked by	Checker
	A301
Scale	As indicated



18 Spencer St, Brooklyn, NY 11205
info@techscanusa.com
TechScanusa.com
(929) 486-9091

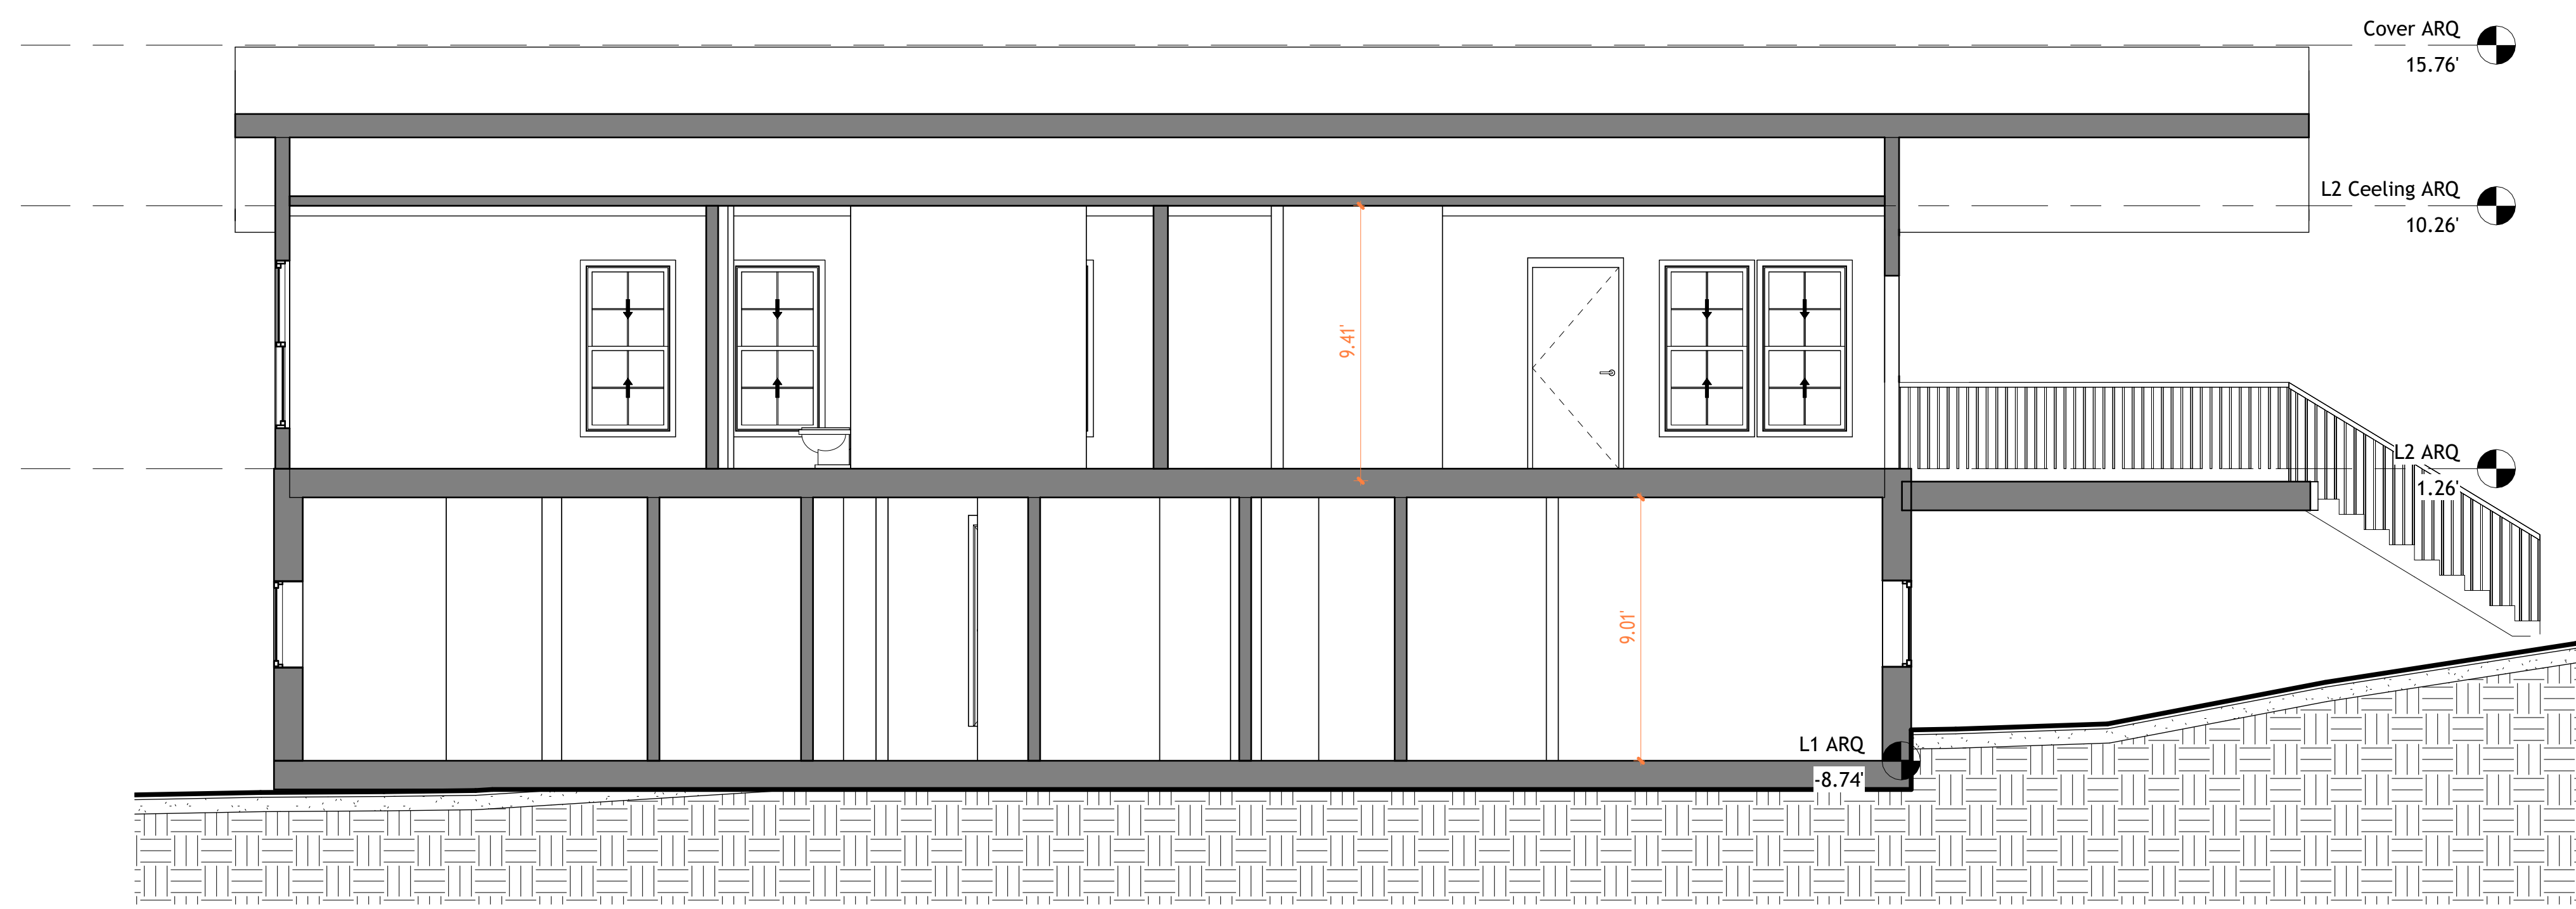

1 Section 7 111
1 : 50



TECHSCAN
Surveying As Builds and Geospatial Solutions



Project Name	Architectural Building Elevations
Project number	Project Number
Date	Issue Date
Checked by	Checker
	A302
Scale	1 : 50



18 Spencer St, Brooklyn, NY 11205
info@techscanusa.com
TechScanusa.com
 (929) 486-9031



TECHSCAN
Surveying As Builds and Geospatial Solutions

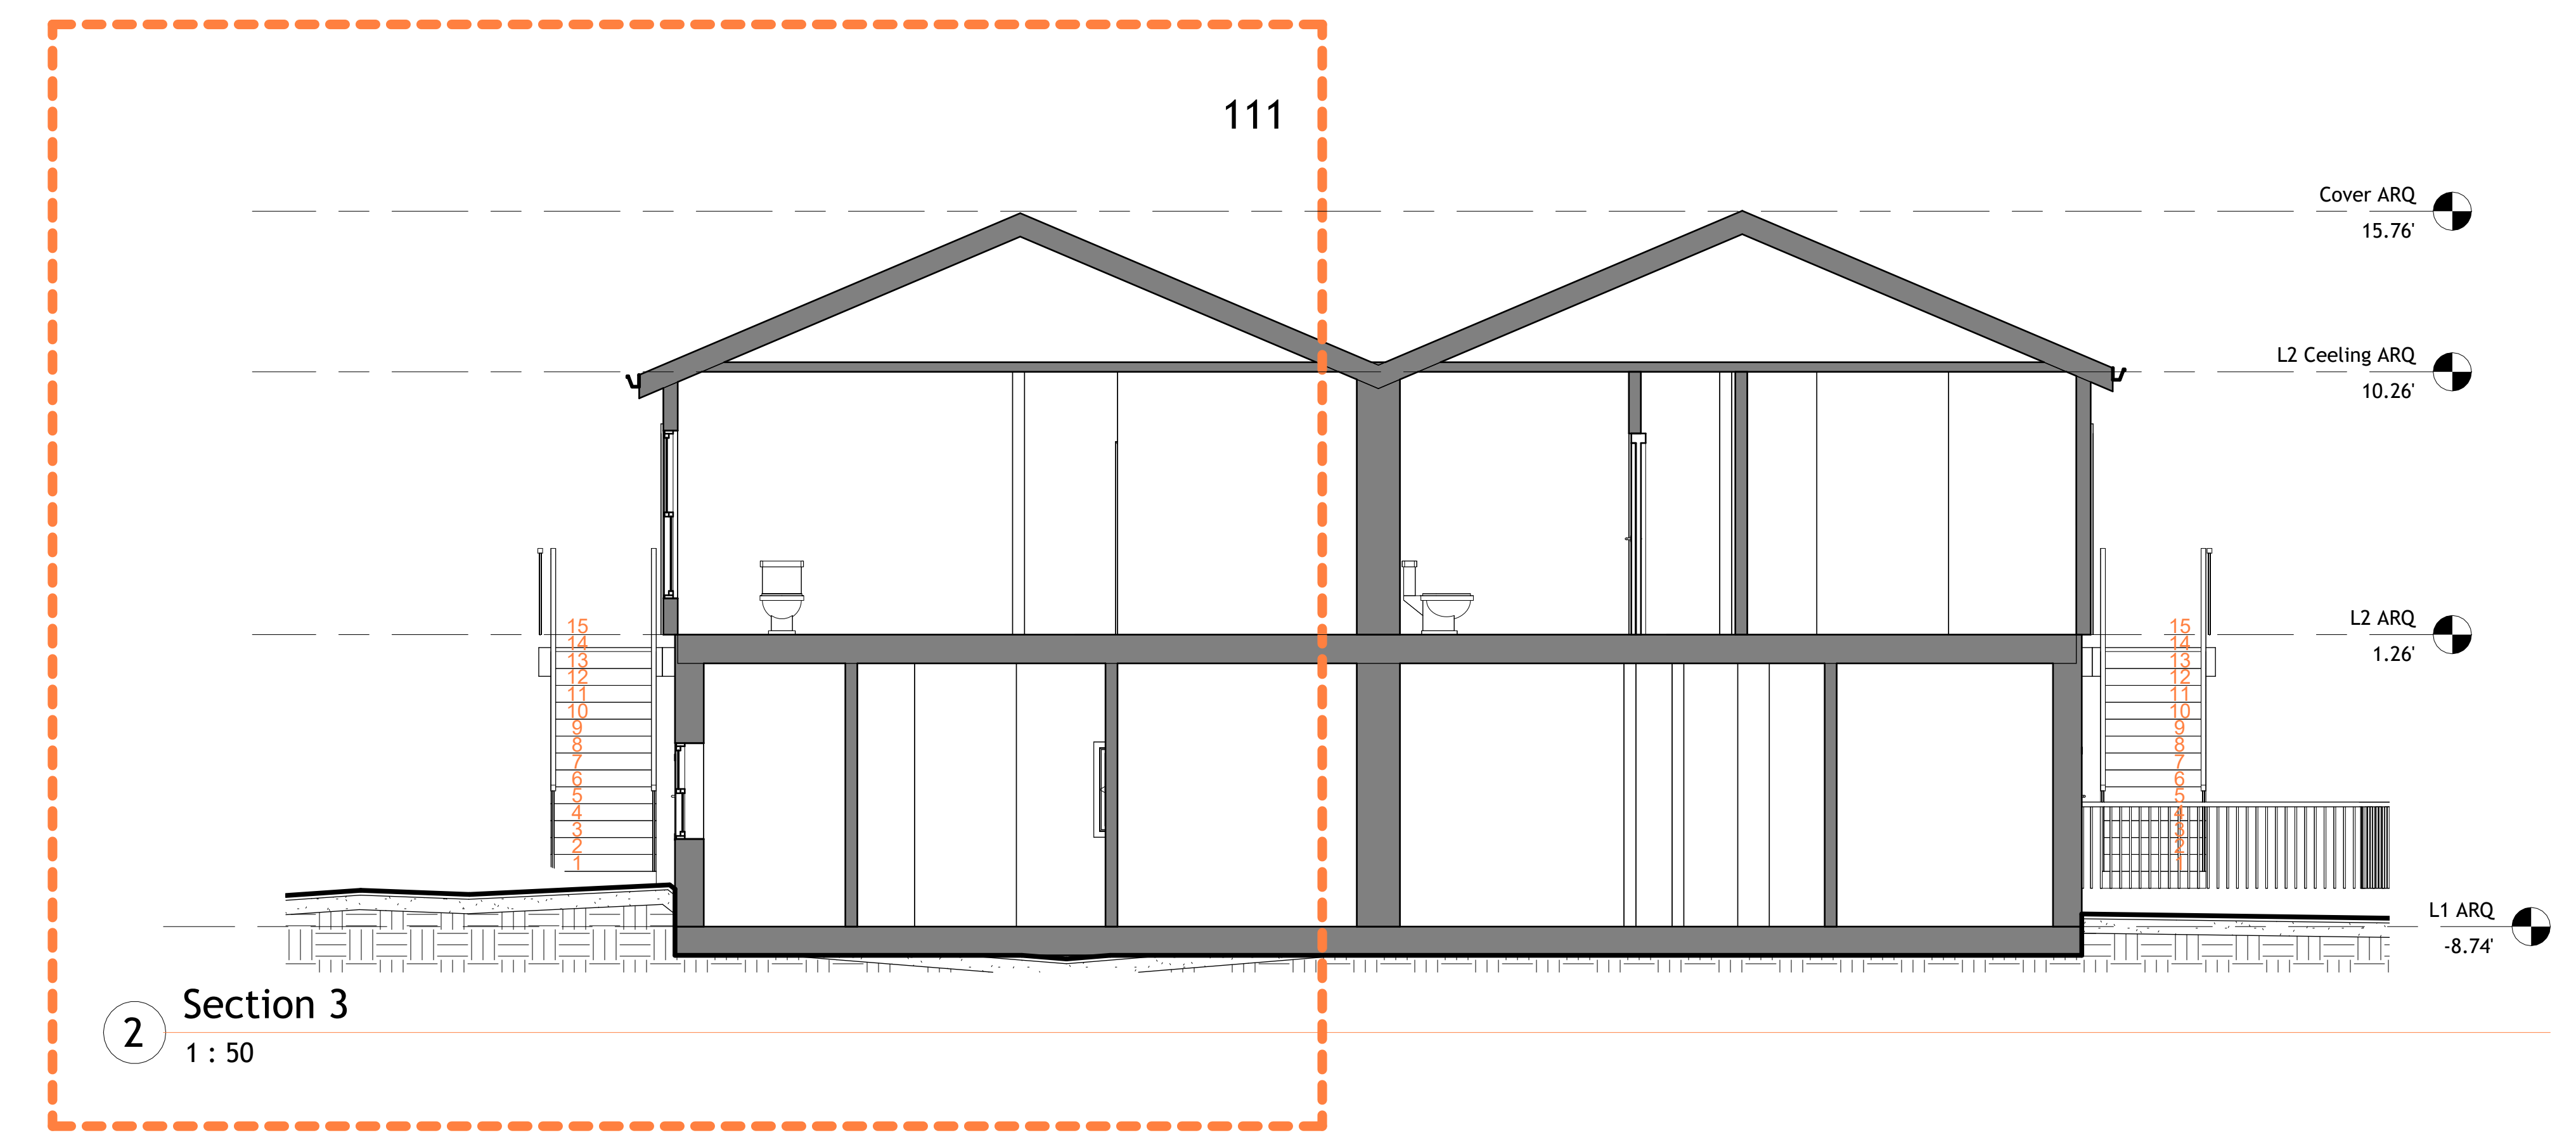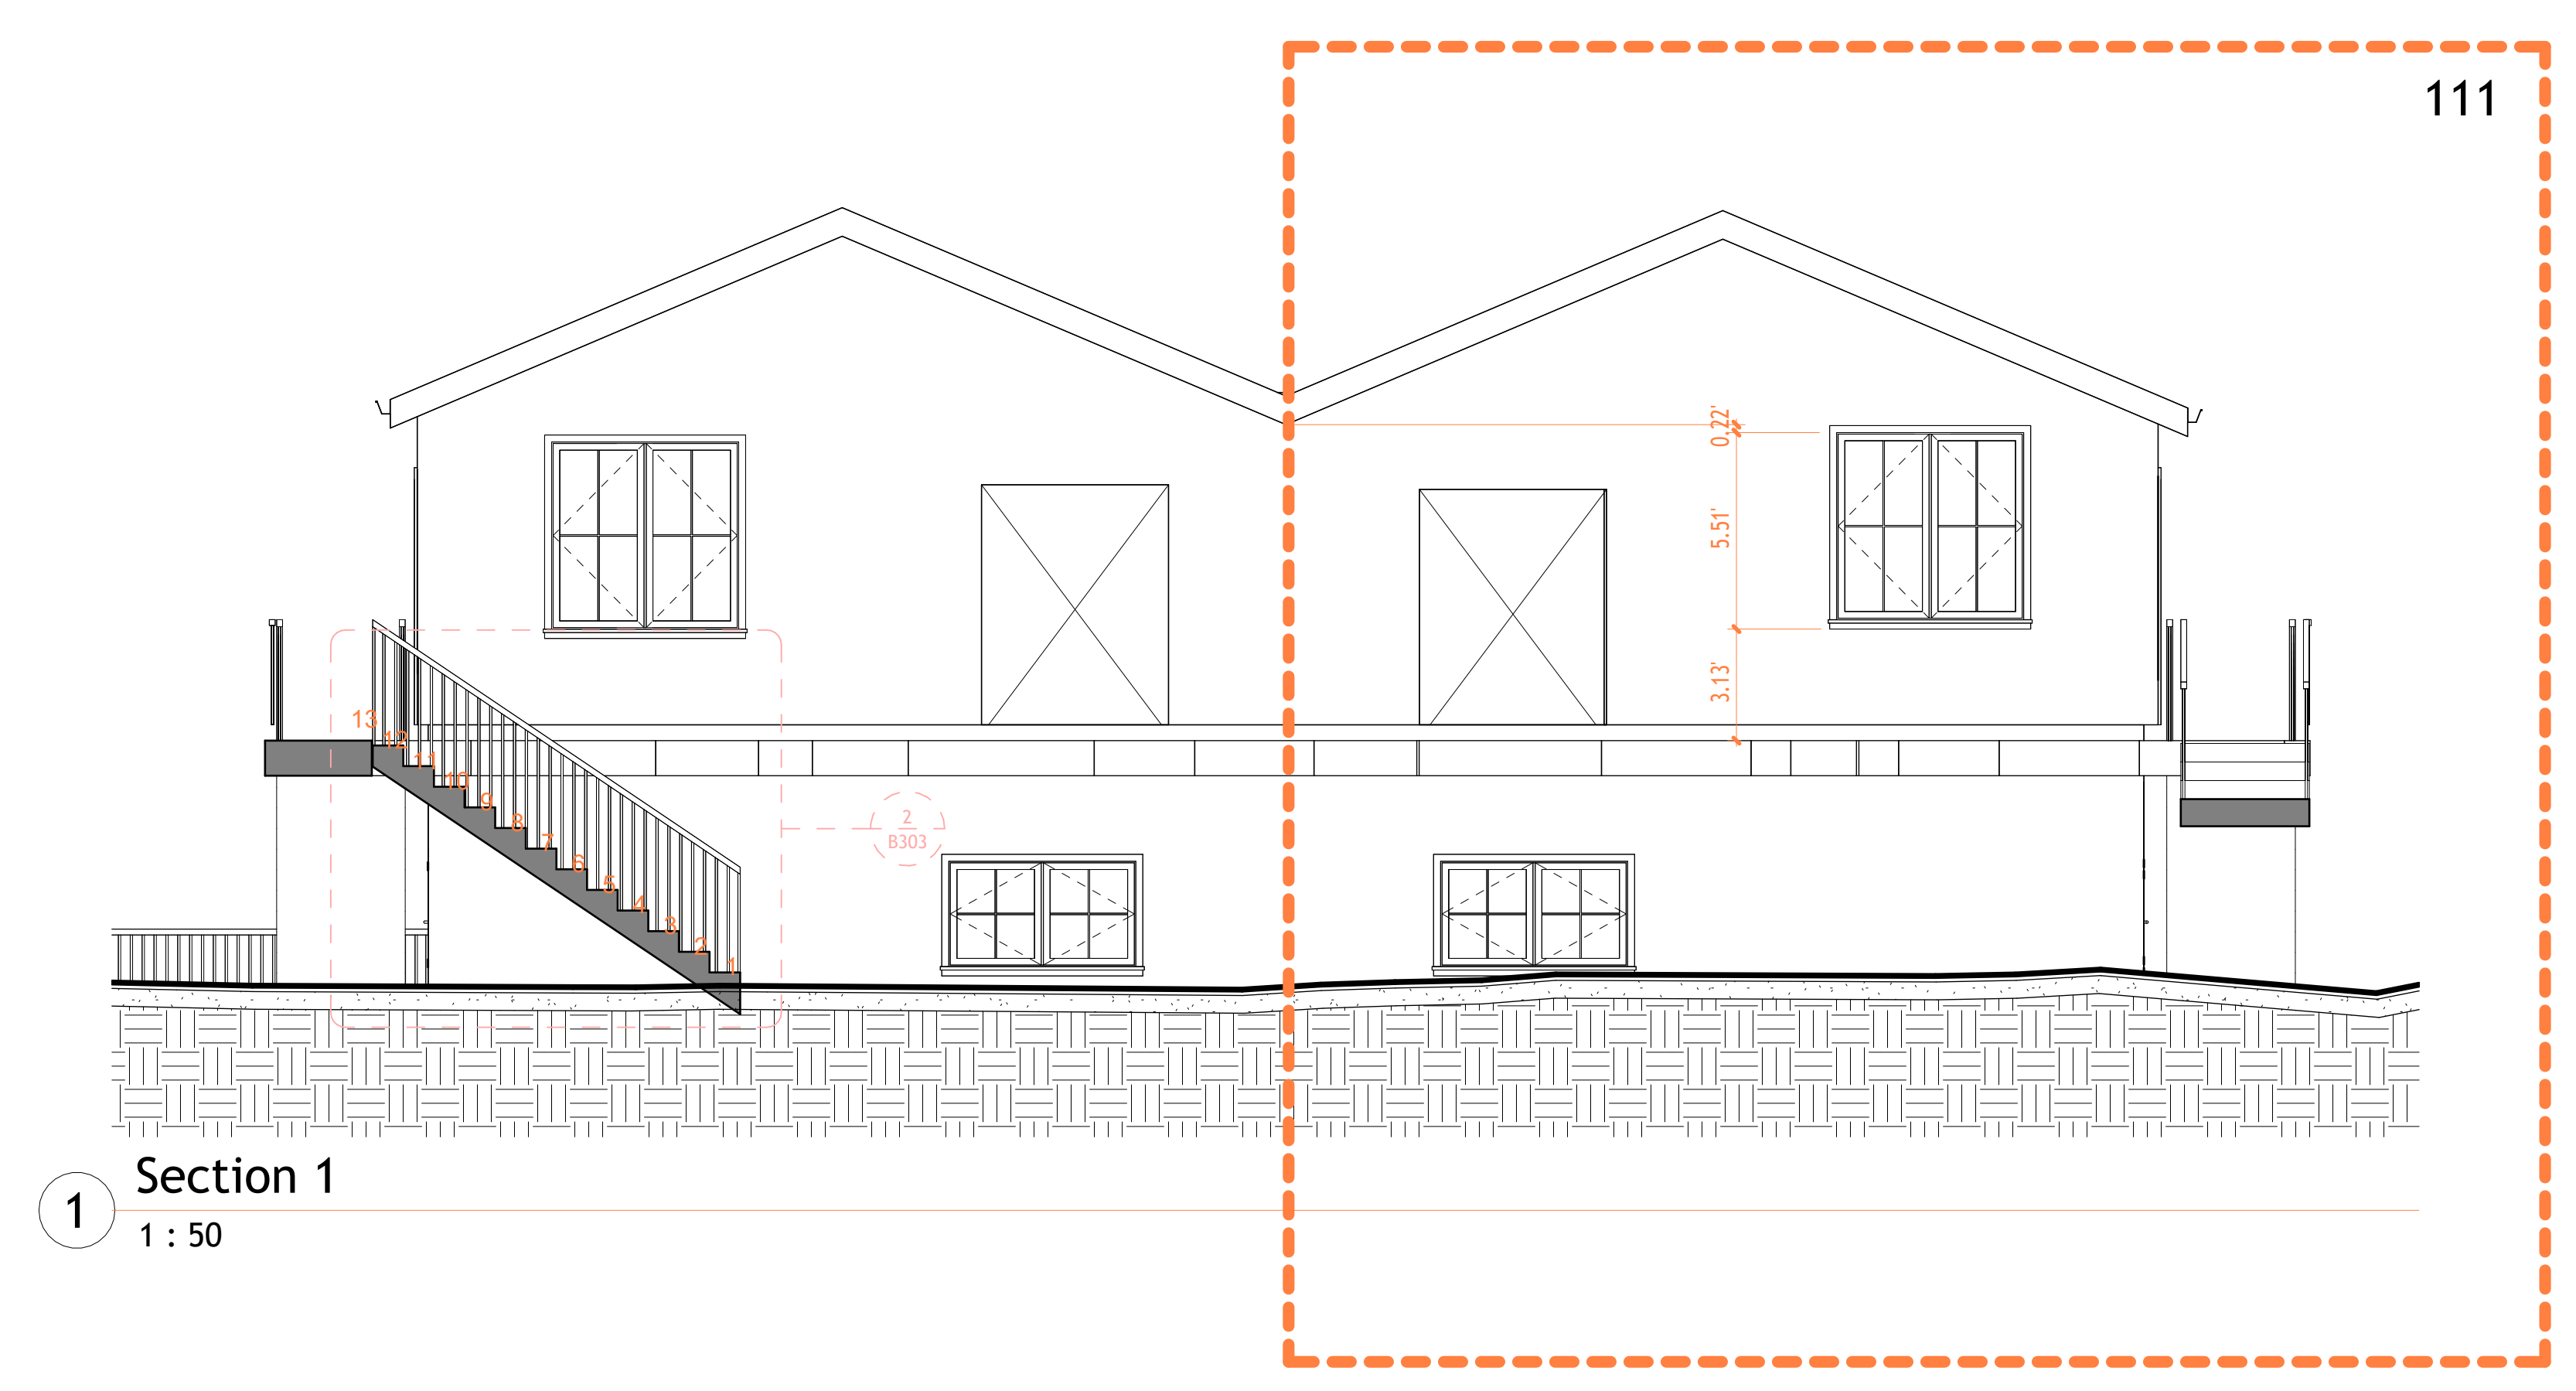



Project Name	
Architectural Building Elevations	
Project number	Project Number
Date	Issue Date
Checked by	Checker
	A303
Scale	1 : 50



18 Spencer St, Brooklyn, NY 11205
info@techscanusa.com
TechScanusa.com
(929) 486-9008



TECHSCAN
Surveying As Builds and Geospatial Solutions

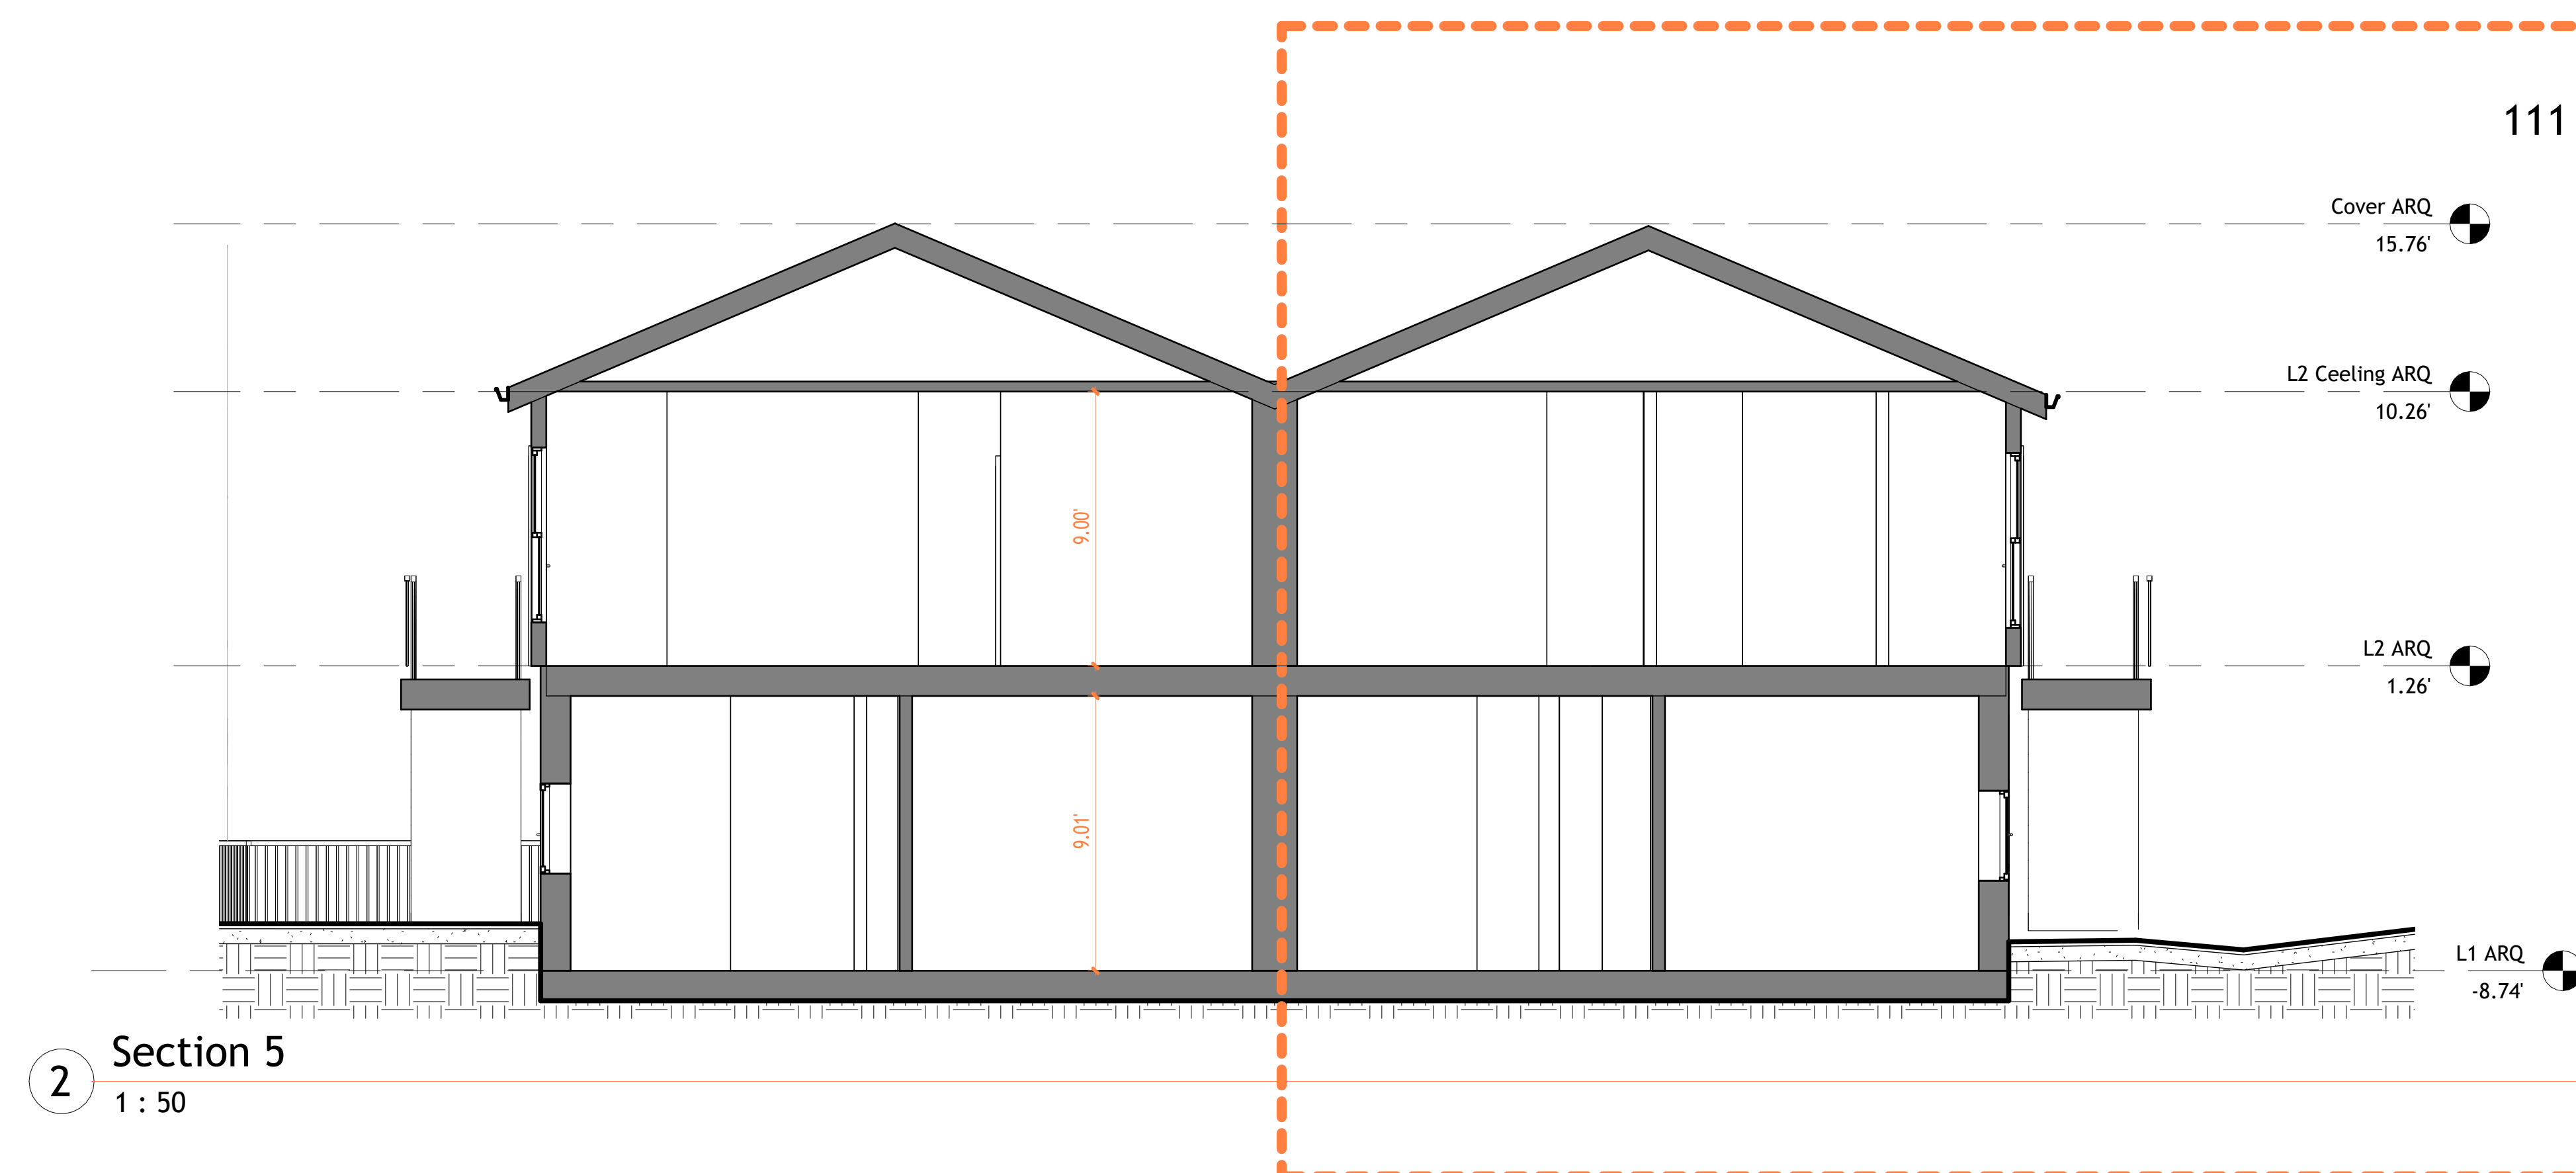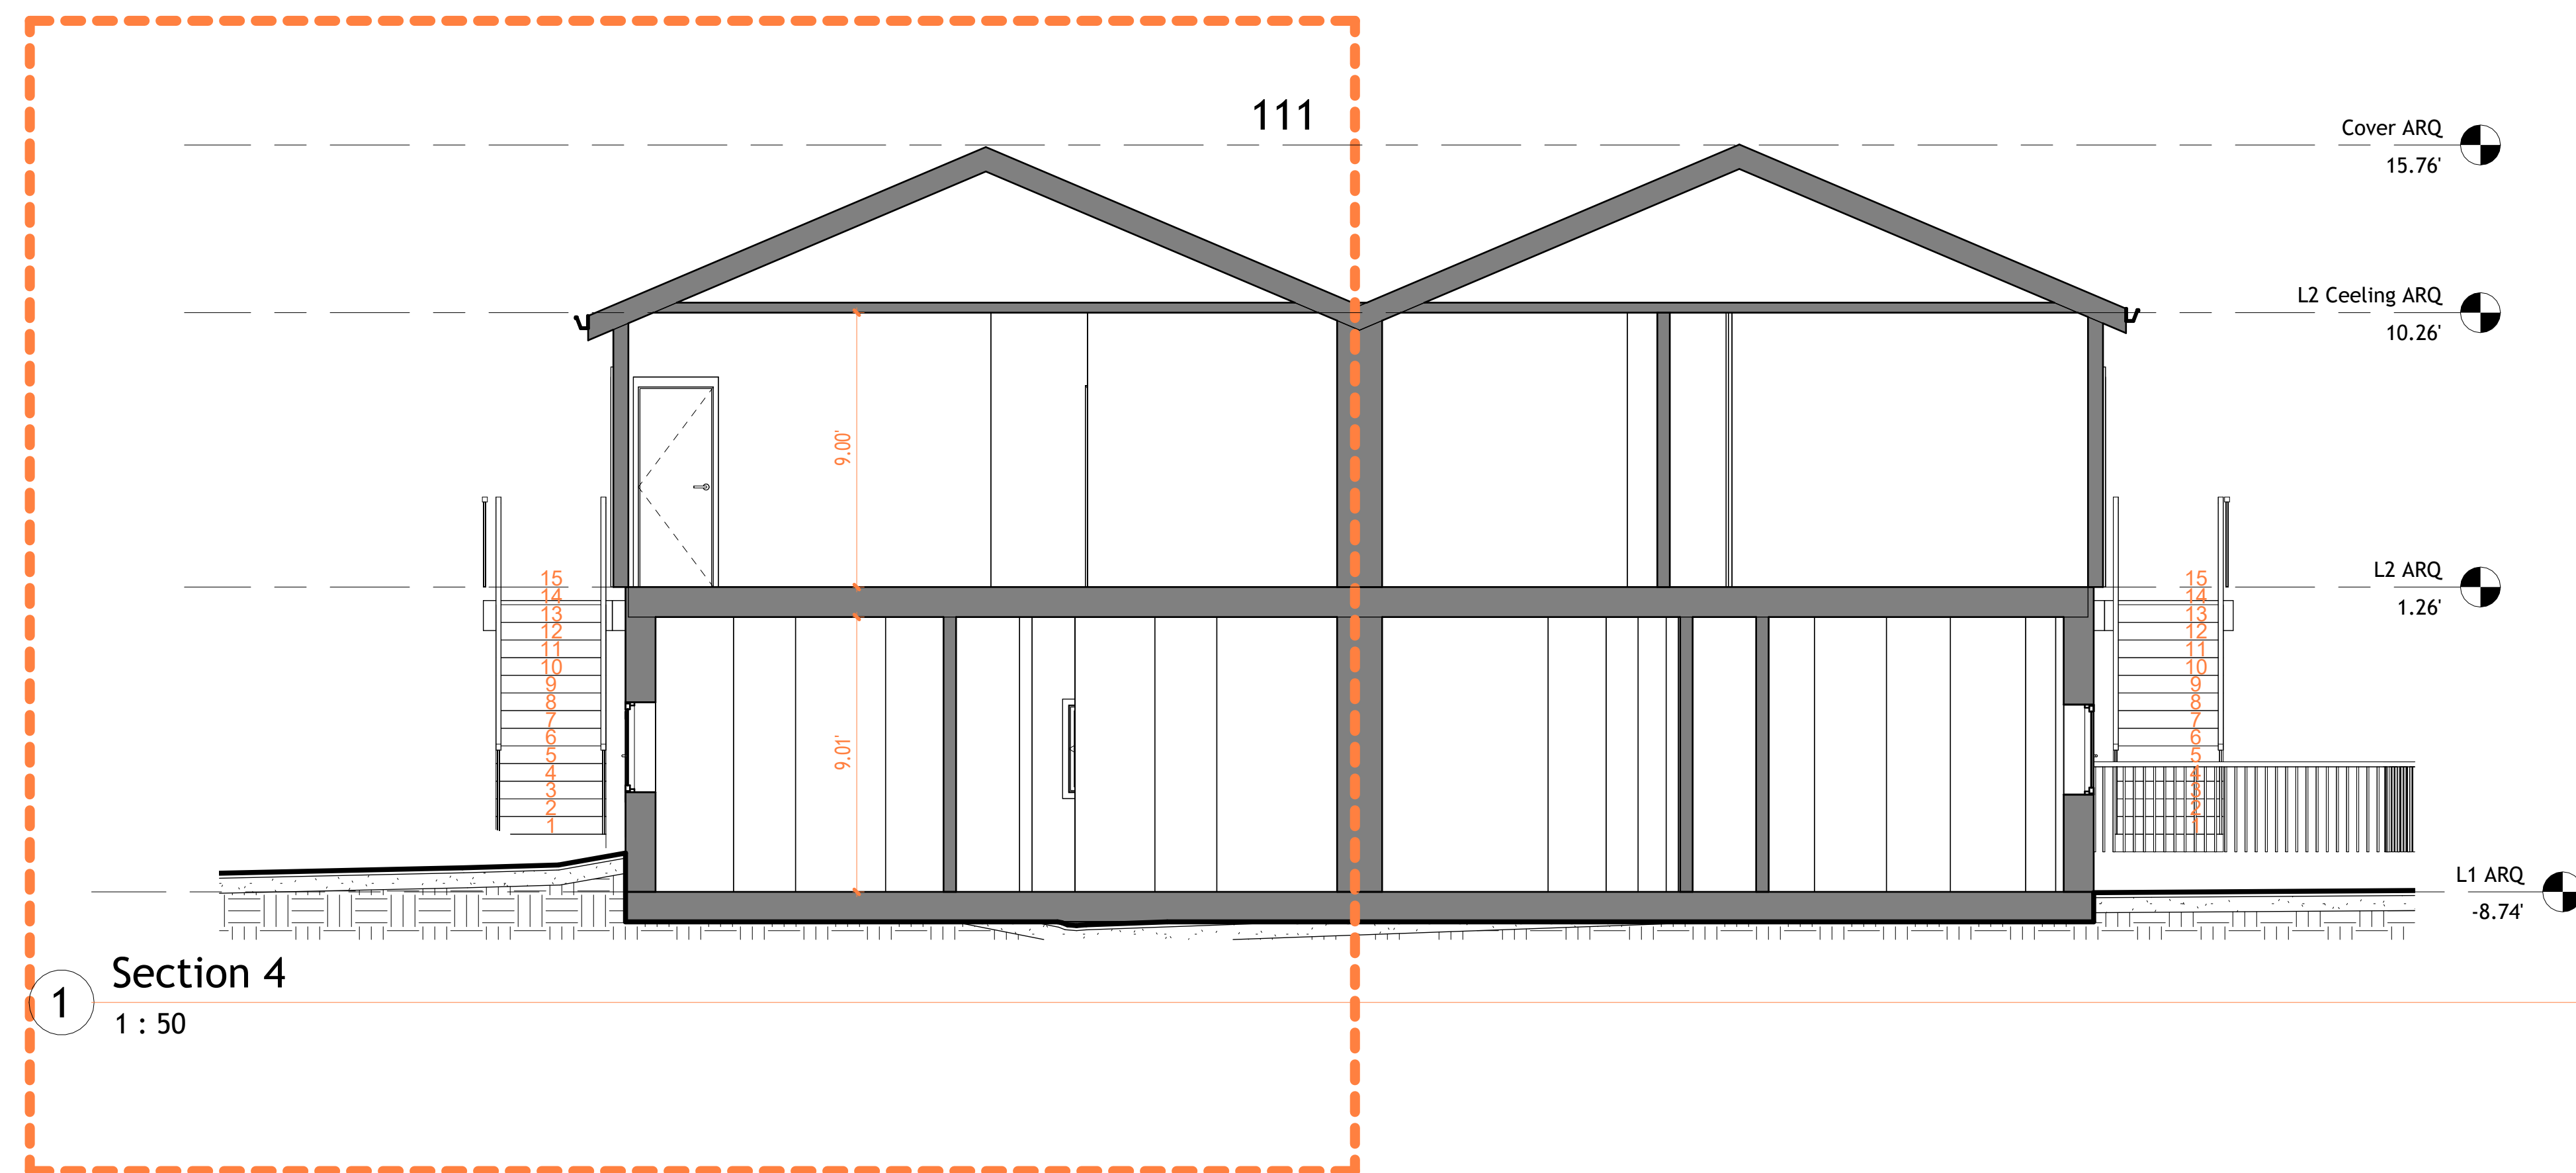

Project Name

Architectural Building
Elevations

Project number Project Number

Date Issue Date

Checked by Checker

A304

Scale 1 : 50




18 Spencer St, Brooklyn,
NY 11205

info@techscanusa.com

TechScanusa.com

(929) 486-9091

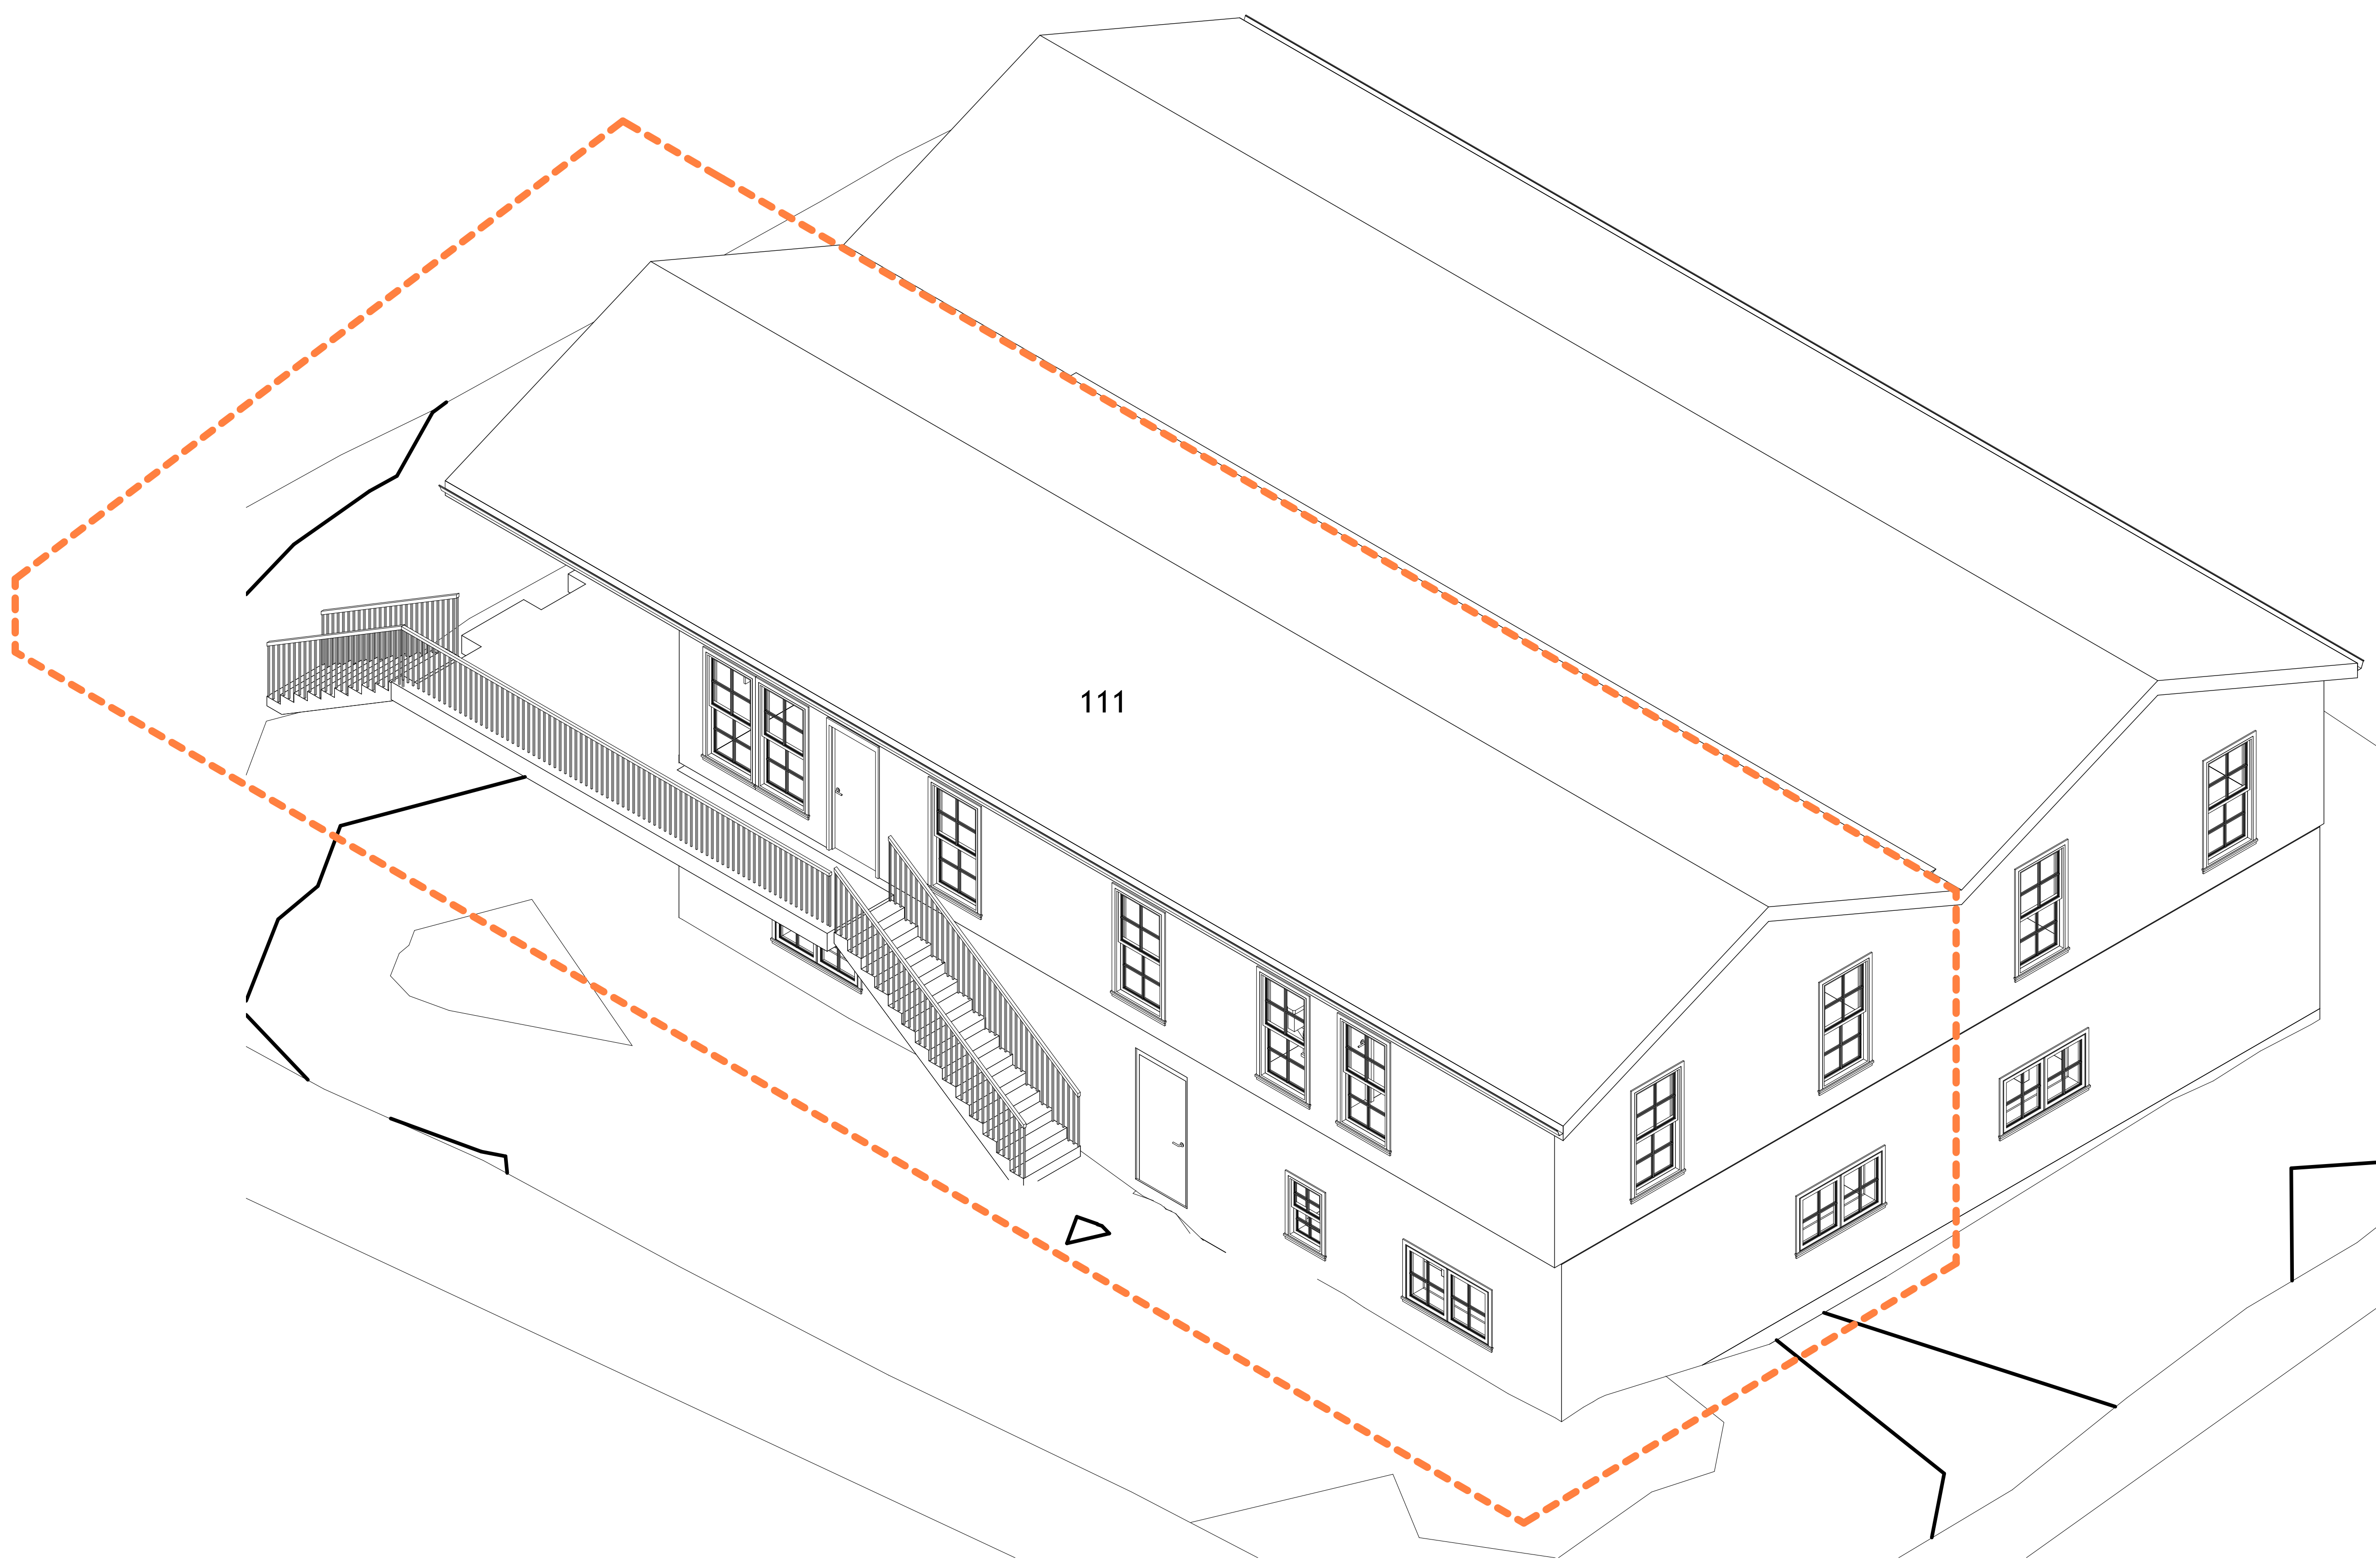

1 {3D} Copy 1




TECHSCAN
Surveying As Builds and Geospatial Solutions

Project Name	
Architectural Enlarged Views	
Project number	Project Number
Date	Issue Date
Checked by	Checker
	A401
Scale	



18 Spencer St, Brooklyn,
NY 11205
info@techscanusa.com
TechScanusa.com
(929) 486-9031

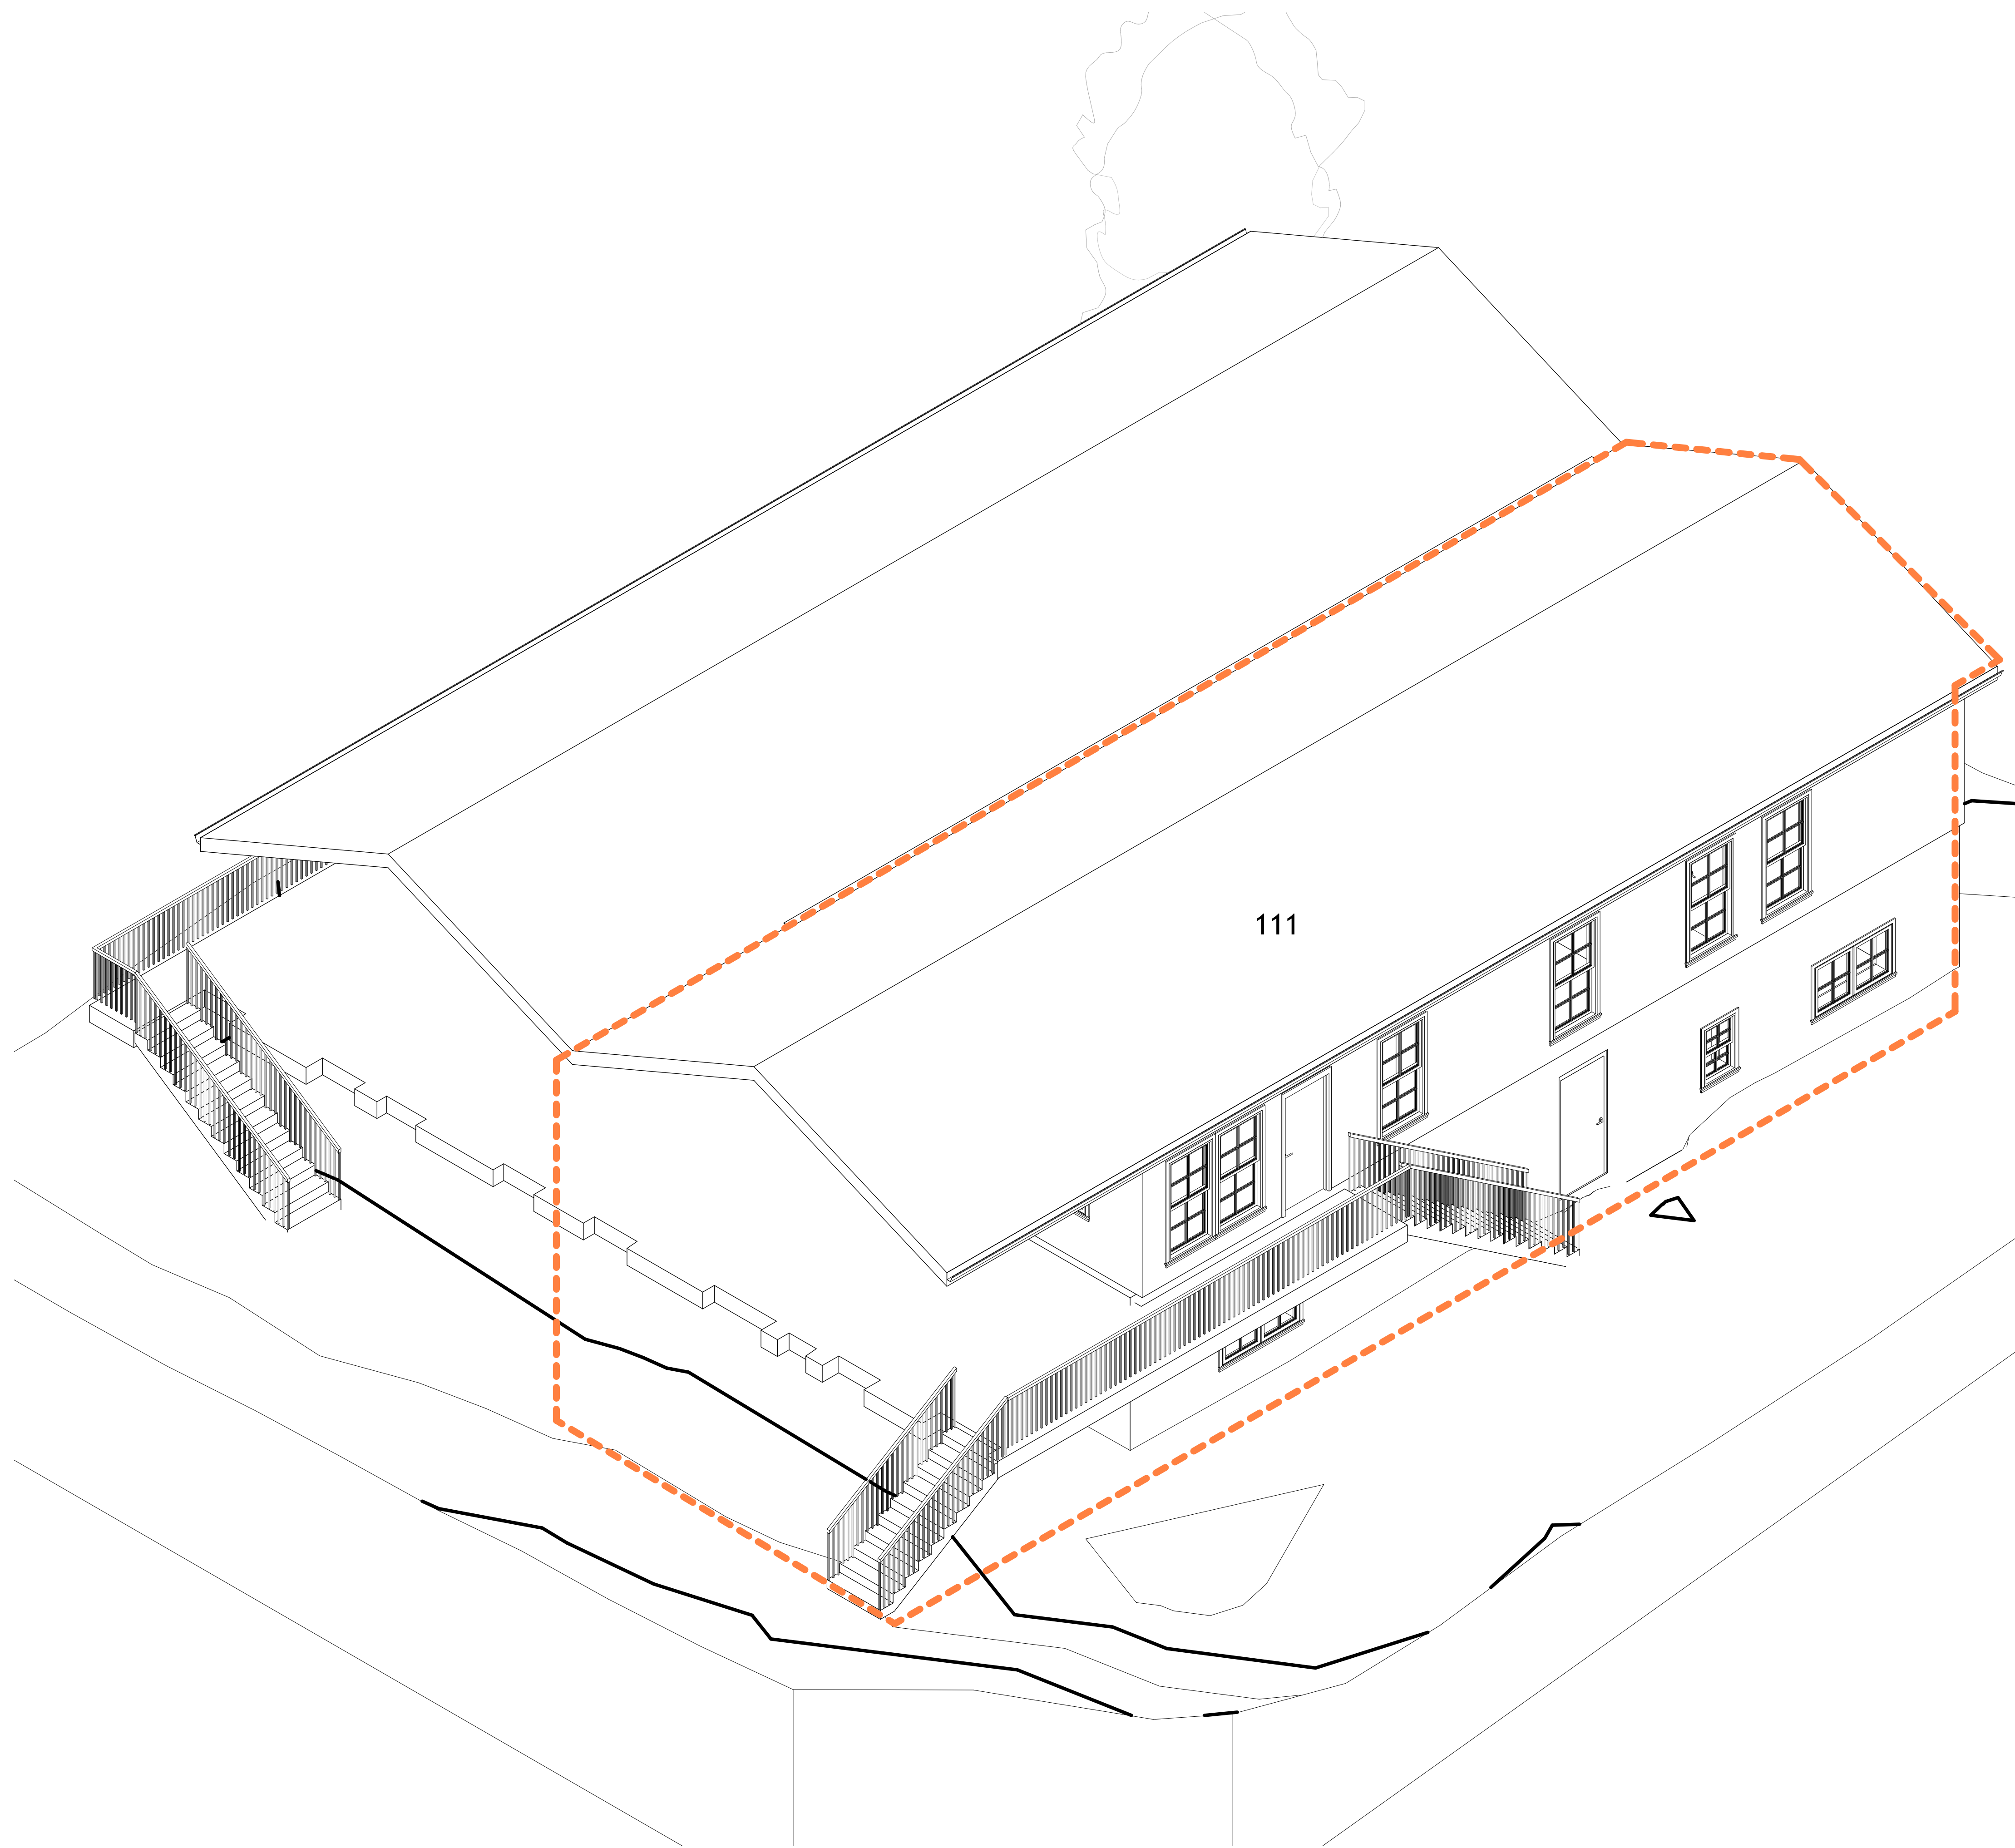

1 {3D} Copy 1 Copy 1



TECHSCAN
 Surveying As Builds and Geospatial Solutions


Project Name	
Architectural Enlarged Views	
Project number	Project Number
Date	Issue Date
Checked by	Checker
	A402
Scale	



18 Spencer St, Brooklyn,
 NY 11205
info@techscanusa.com
TechScanusa.com
 (929) 486-9038



TECHSCAN
Surveying As Builds and Geospatial Solutions

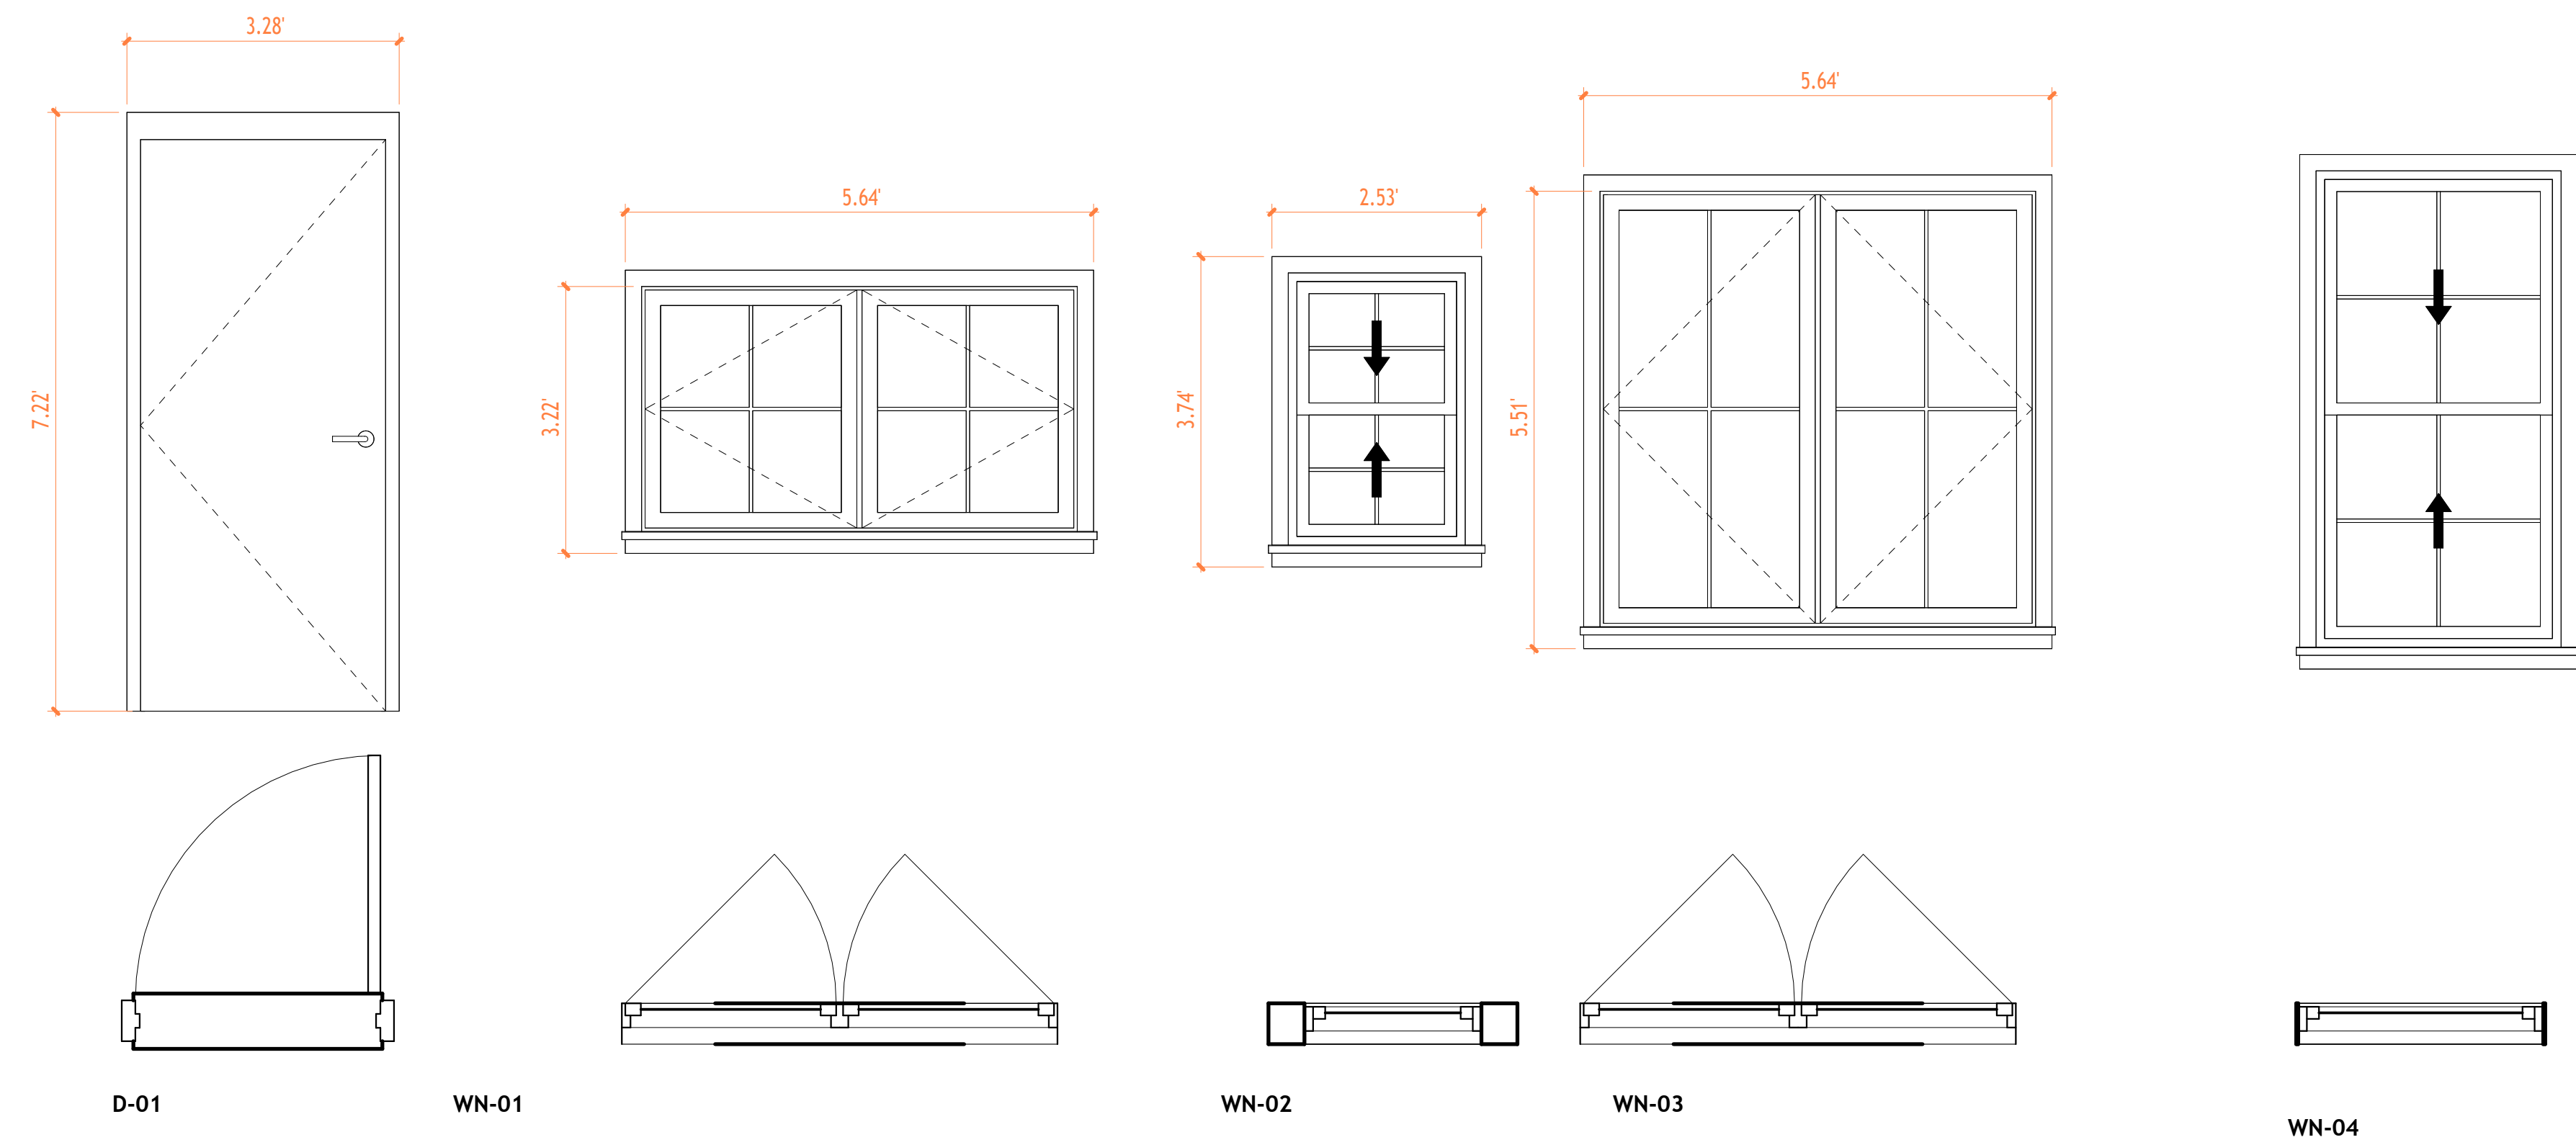

Doors
1 : 20

Door Schedule					
Mark	Door Size			Hardware From Room: Number	Level
	Width	Height	Thickness		
D-10	2.46'	6.56'	0.15'		L2 ARQ
D-01	2.95'	6.89'	0.15'		L1 ARQ
D-01	2.95'	6.89'	0.15'		L2 ARQ
D-01	2.95'	6.89'	0.15'		L2 ARQ
D-01	2.95'	6.89'	0.15'		L1 ARQ
D-01	2.95'	6.89'	0.15'		L1 ARQ
D-03	0.00'	0.00'			L2 ARQ
D-03	0.00'	0.00'			L2 ARQ
D-04	2.46'	6.56'	0.15'		L2 ARQ

Window Schedule				
Type Mark	Size		Head Height	Level
	Width	Height		
WN-04	2.95'	5.74'	7.12'	L2 ARQ
WN-04	2.95'	5.74'	7.12'	L2 ARQ
WN-04	2.95'	5.74'	7.12'	L2 ARQ
WN-04	2.95'	5.74'	7.12'	L2 ARQ
WN-01	5.25'	2.95'	6.14'	L1 ARQ
WN-01	5.25'	2.95'	6.14'	L1 ARQ
WN-01	5.25'	2.95'	6.14'	L1 ARQ
WN-04	2.95'	5.74'	7.17'	L2 ARQ
WN-04	2.95'	5.74'	7.17'	L2 ARQ
WN-04	2.95'	5.74'	7.17'	L2 ARQ
WN-01	5.25'	2.95'	6.14'	L1 ARQ
WN-01	5.25'	2.95'	6.17'	L1 ARQ
WN-01	5.25'	2.95'	6.17'	L1 ARQ
WN-02	2.13'	3.28'	6.53'	L1 ARQ
WN-04	2.95'	5.74'	7.17'	L2 ARQ
WN-02	2.13'	3.28'	7.00'	L2 ARQ
WN-04	2.95'	5.74'	6.99'	L2 ARQ
WN-04	2.95'	5.74'	6.99'	L2 ARQ
WN-02	2.13'	3.28'	6.28'	L1 ARQ
WN-01	5.25'	2.95'	6.22'	L1 ARQ
WN-01	5.25'	2.95'	5.91'	L1 ARQ
W-03	5.25'	5.25'	7.94'	L2 ARQ
W-03	5.25'	5.25'	8.20'	L2 ARQ

Project Name _____

Architectural Details _____

Project number _____ Project Number _____

Date _____ Issue Date _____

Checked by _____ Checker _____

A501

Scale 1 : 20



18 Spencer St, Brooklyn, NY 11205
 info@techscanusa.com
 TechScanusa.com
 (929) 486-9091