




AS-BUILT DOCUMENTATION 365 Greene Ave, Brooklyn, NY 11216, USA

- A1, A2, A3, A4 & A5 THESE DOCUMENTS ARE THE PROPERTY OF THE DESIGNER AND SHALL NOT BE COPIED, DUPLICATED, ALTERED, MODIFIED OR REVISED IN ANY WAY WITHOUT THE WRITTEN APPROVAL OF THE DESIGNER.
- CONTRACTOR SHALL VERIFY ALL CONDITIONS AND DIMENSIONS AT THE SITE AND ALL INCONSISTENCIES SHALL BE BROUGHT TO THE ATTENTION OF THE DEVELOPER AND THE DESIGNER BEFORE PROCEEDING WITH THE WORK.
- ANY ERRORS OR OMISSIONS FOUND IN THESE DRAWINGS SHALL BE BROUGHT TO DEVELOPERS AND DESIGNERS ATTENTION IMMEDIATELY.
- DO NOT SCALE DRAWINGS. WRITTEN DIMENSIONS TAKE PRECEDENCE OVER SCALED DIMENSIONS.
- ALL DIMENSIONS ARE TO FACE OF STUD OR TO FACE OF FRAMING UNLESS OTHERWISE NOTED.
- ALL TRUSS DRAWINGS TO BE REVIEWED AND APPROVED BY THE STRUCTURAL ENGINEER PRIOR TO ISSUANCE OF BUILDING PERMIT.
- ALL OR EQUAL SUBSTITUTIONS MUST BE SUBMITTED TO AND APPROVED BY CITY BUILDING OFFICIAL PRIOR TO INSTALLATION.
- ALL ELECTRICAL AND MECHANICAL EQUIPMENT AND METERS ARE SUBJECT TO RELOCATION DUE TO FIELD CONDITIONS, CONTRACTOR TO VERIFY.
- DAMP PROOFING - ONE COAT CONTINUOUS ELASTOMERIC WATERPROOFING FROM GRADE LEVEL TO BOTTOM OF FOUNDATION.
- SHOP DRAWING REVIEW AND DISTRIBUTION, ALONG WITH PRODUCT SUBMITTALS, REQUESTED IN THE CONSTRUCTION DOCUMENTS, SHALL BE THE SOLE RESPONSIBILITY OF THE GENERAL CONTRACTOR, UNLESS DIRECTED OTHERWISE UNDER A SEPARATE AGREEMENT.
- DEVIATIONS FROM THESE DOCUMENTS IN THE CONSTRUCTION PHASE SHALL BE REVIEWED BY THE DESIGNER AND THE OWNER PRIOR TO THE START OF WORK IN QUESTION. ANY DEVIATIONS FROM THESE DOCUMENTS WITHOUT PRIOR REVIEW, SHALL BE THE SOLE RESPONSIBILITY OF THE GENERAL CONTRACTOR.
- THE GENERAL CONTRACTOR SHALL BE RESPONSIBLE FOR ALL WORK AND MATERIALS REPRESENTED ON THESE DOCUMENTS INCLUDING THE WORK AND MATERIALS FURNISHED BY SUBCONTRACTORS AND VENDORS.
- THE BUILDER SHALL FURNISH ART AND ALL REPORTS RECEIVED FROM THE GEOTECHNICAL ENGINEER (SOILS REPORT), ON THE STUDY OF THE PROPOSED SITE, TO THE DESIGNER, STRUCTURAL ENGINEER, AND GENERAL CONTRACTOR. IN THE EVENT THE GEOTECHNICAL REPORTS DO NOT EXIST, THE SOILS CONDITION SHALL BE ASSUMED TO BE A MINIMUM DESIGN SOIL PRESSURE STATED BY THE STRUCTURAL ENGINEER OF RECORD FOR THE PURPOSE OF STRUCTURAL DESIGN. GENERAL CONTRACTOR SHALL ASSURE THE SOIL CONDITIONS MEET OR EXCEED THE CRITERIA.
- ALL WORK PERFORMED BY THE GENERAL CONTRACTOR SHALL COMPLY AND CONFORM WITH LOCAL AND STATE BUILDING CODES, ORDINANCES AND REGULATIONS, ALONG WITH ALL OTHER AUTHORITIES HAVING JURISDICTION. THE GENERAL CONTRACTOR IS RESPONSIBLE TO BE AWARE OF THESE REQUIREMENTS AND GOVERNING REGULATIONS.
- WINDOW SUPPLIER TO VERIFY AT LEAST ONE WINDOW IN ALL BEDROOMS TO HAVE A CLEAR EGRESS OPENING OF 5.7 SQ FT WITH MIN. DIMENSION OF 24" IN HEIGHT AND 20" IN WIDTH.

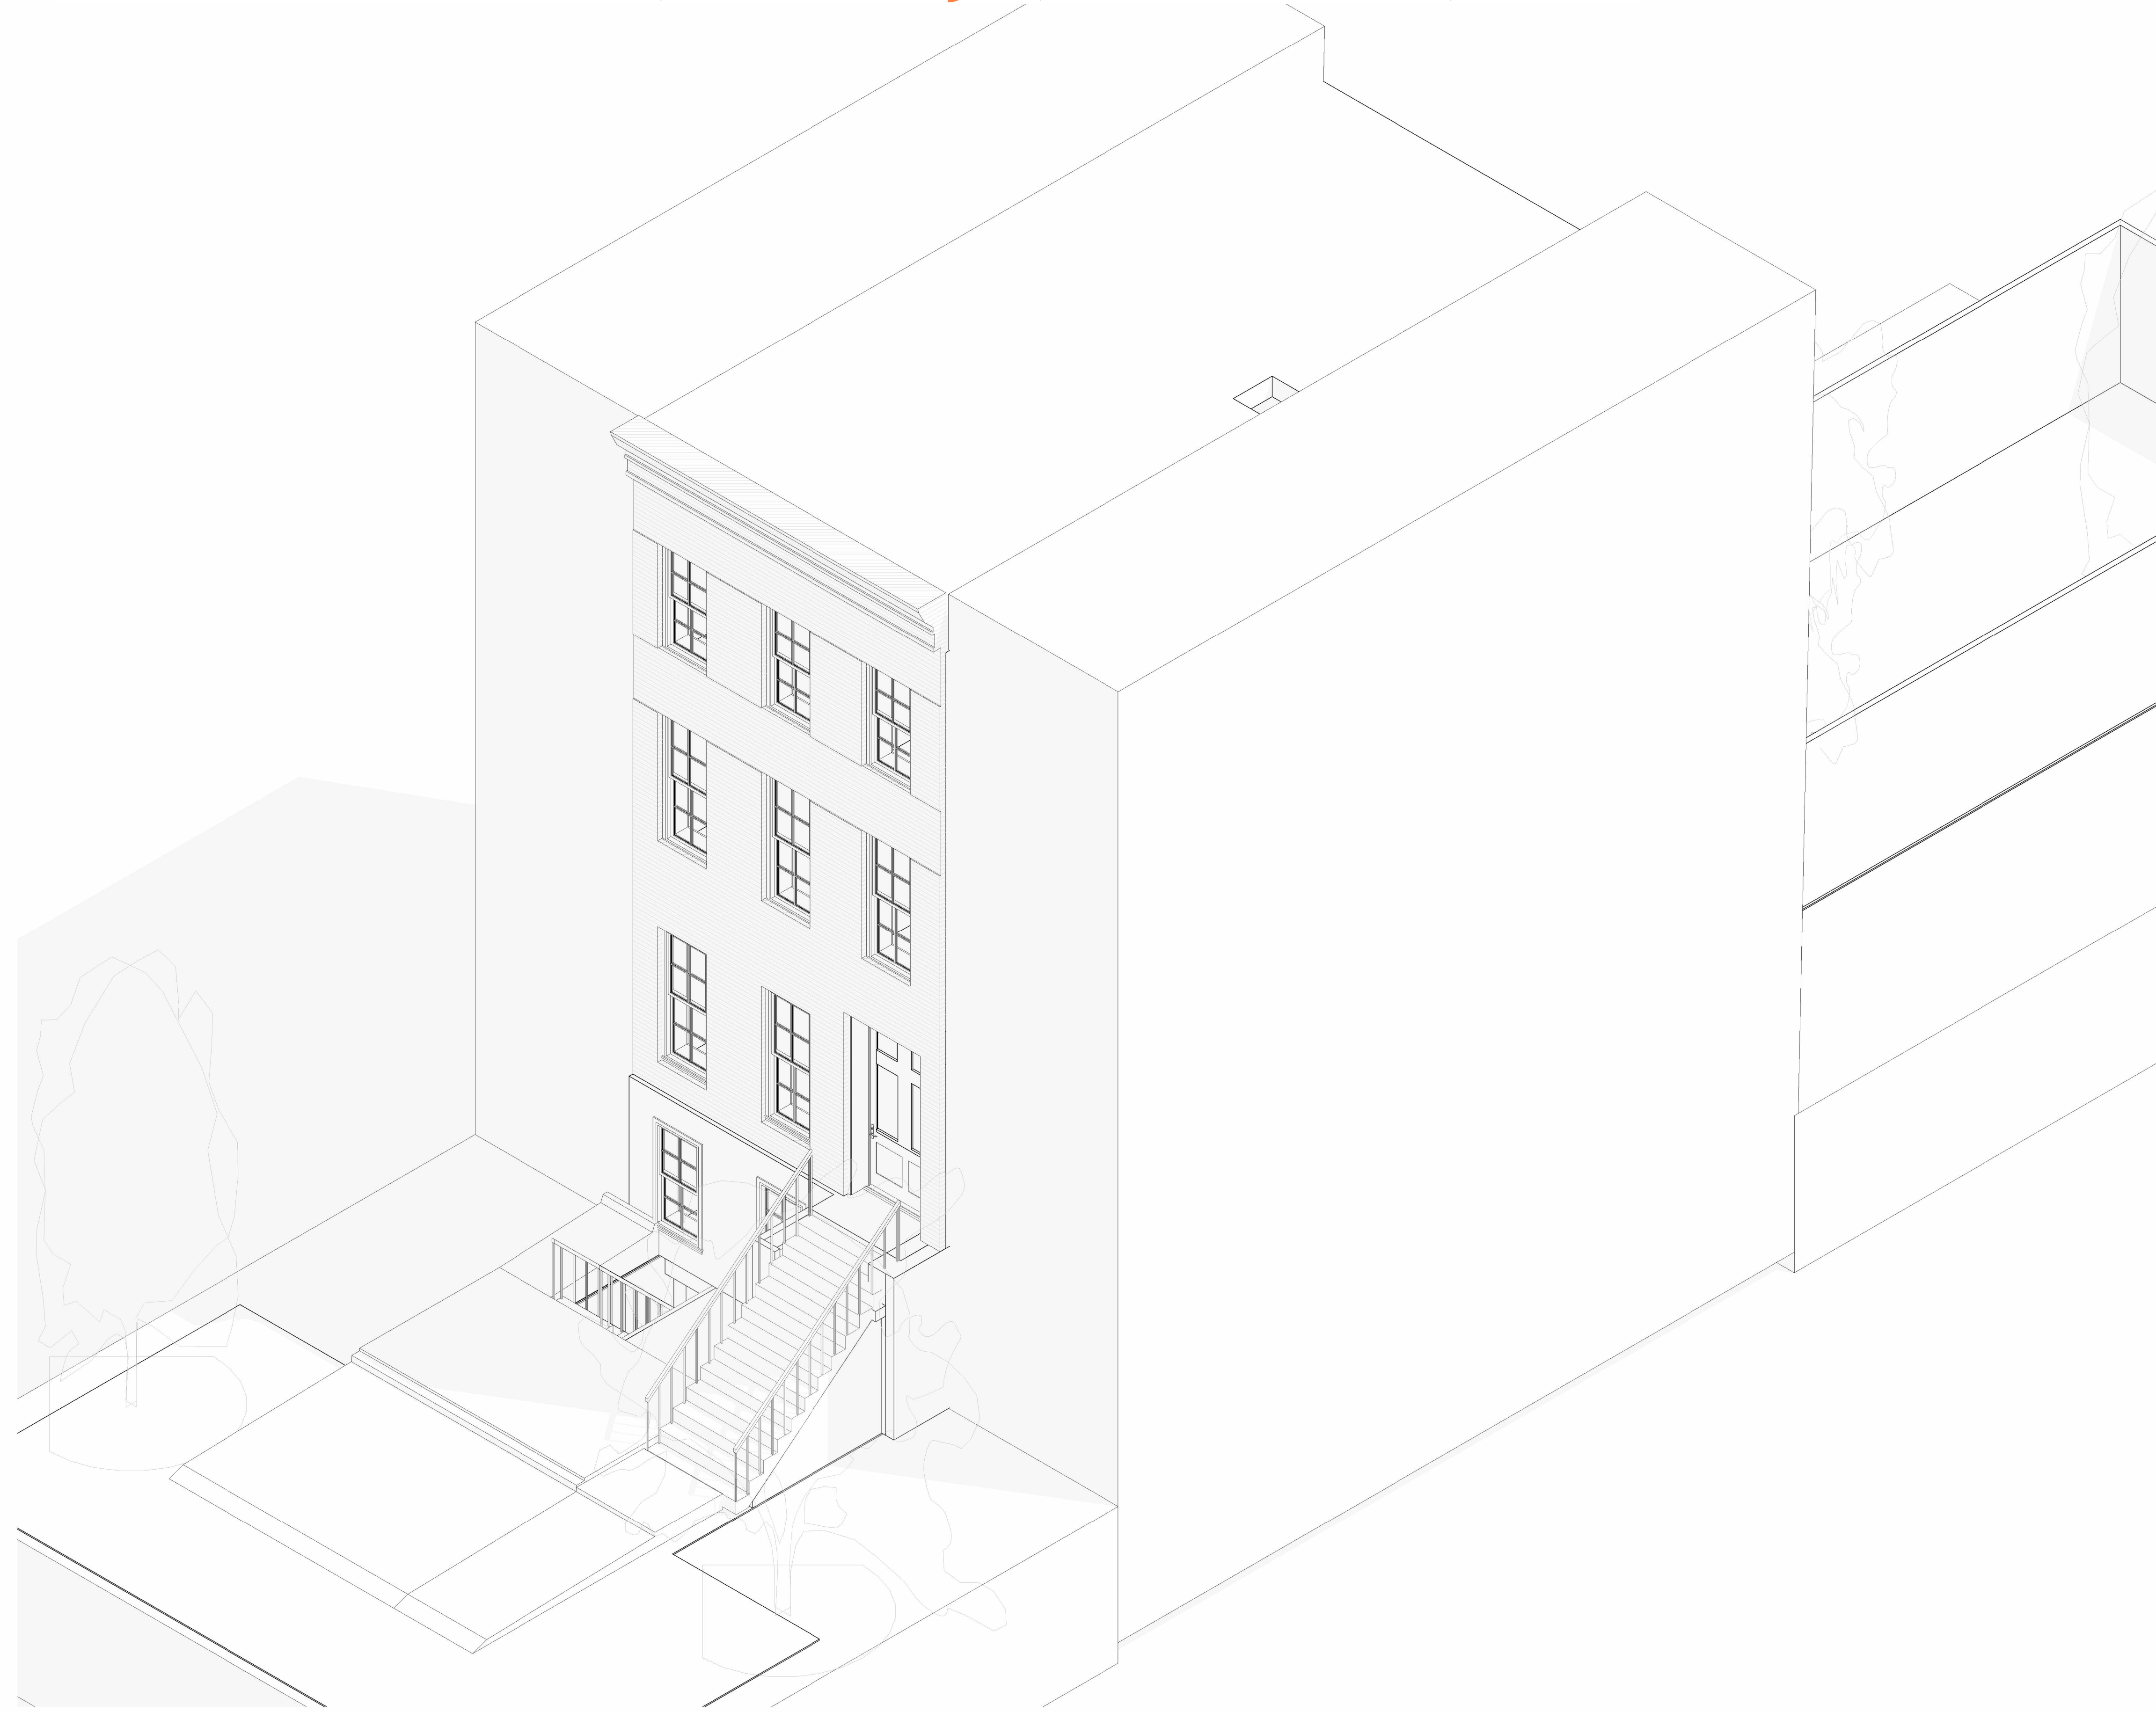

1 COVER 3D

Site views

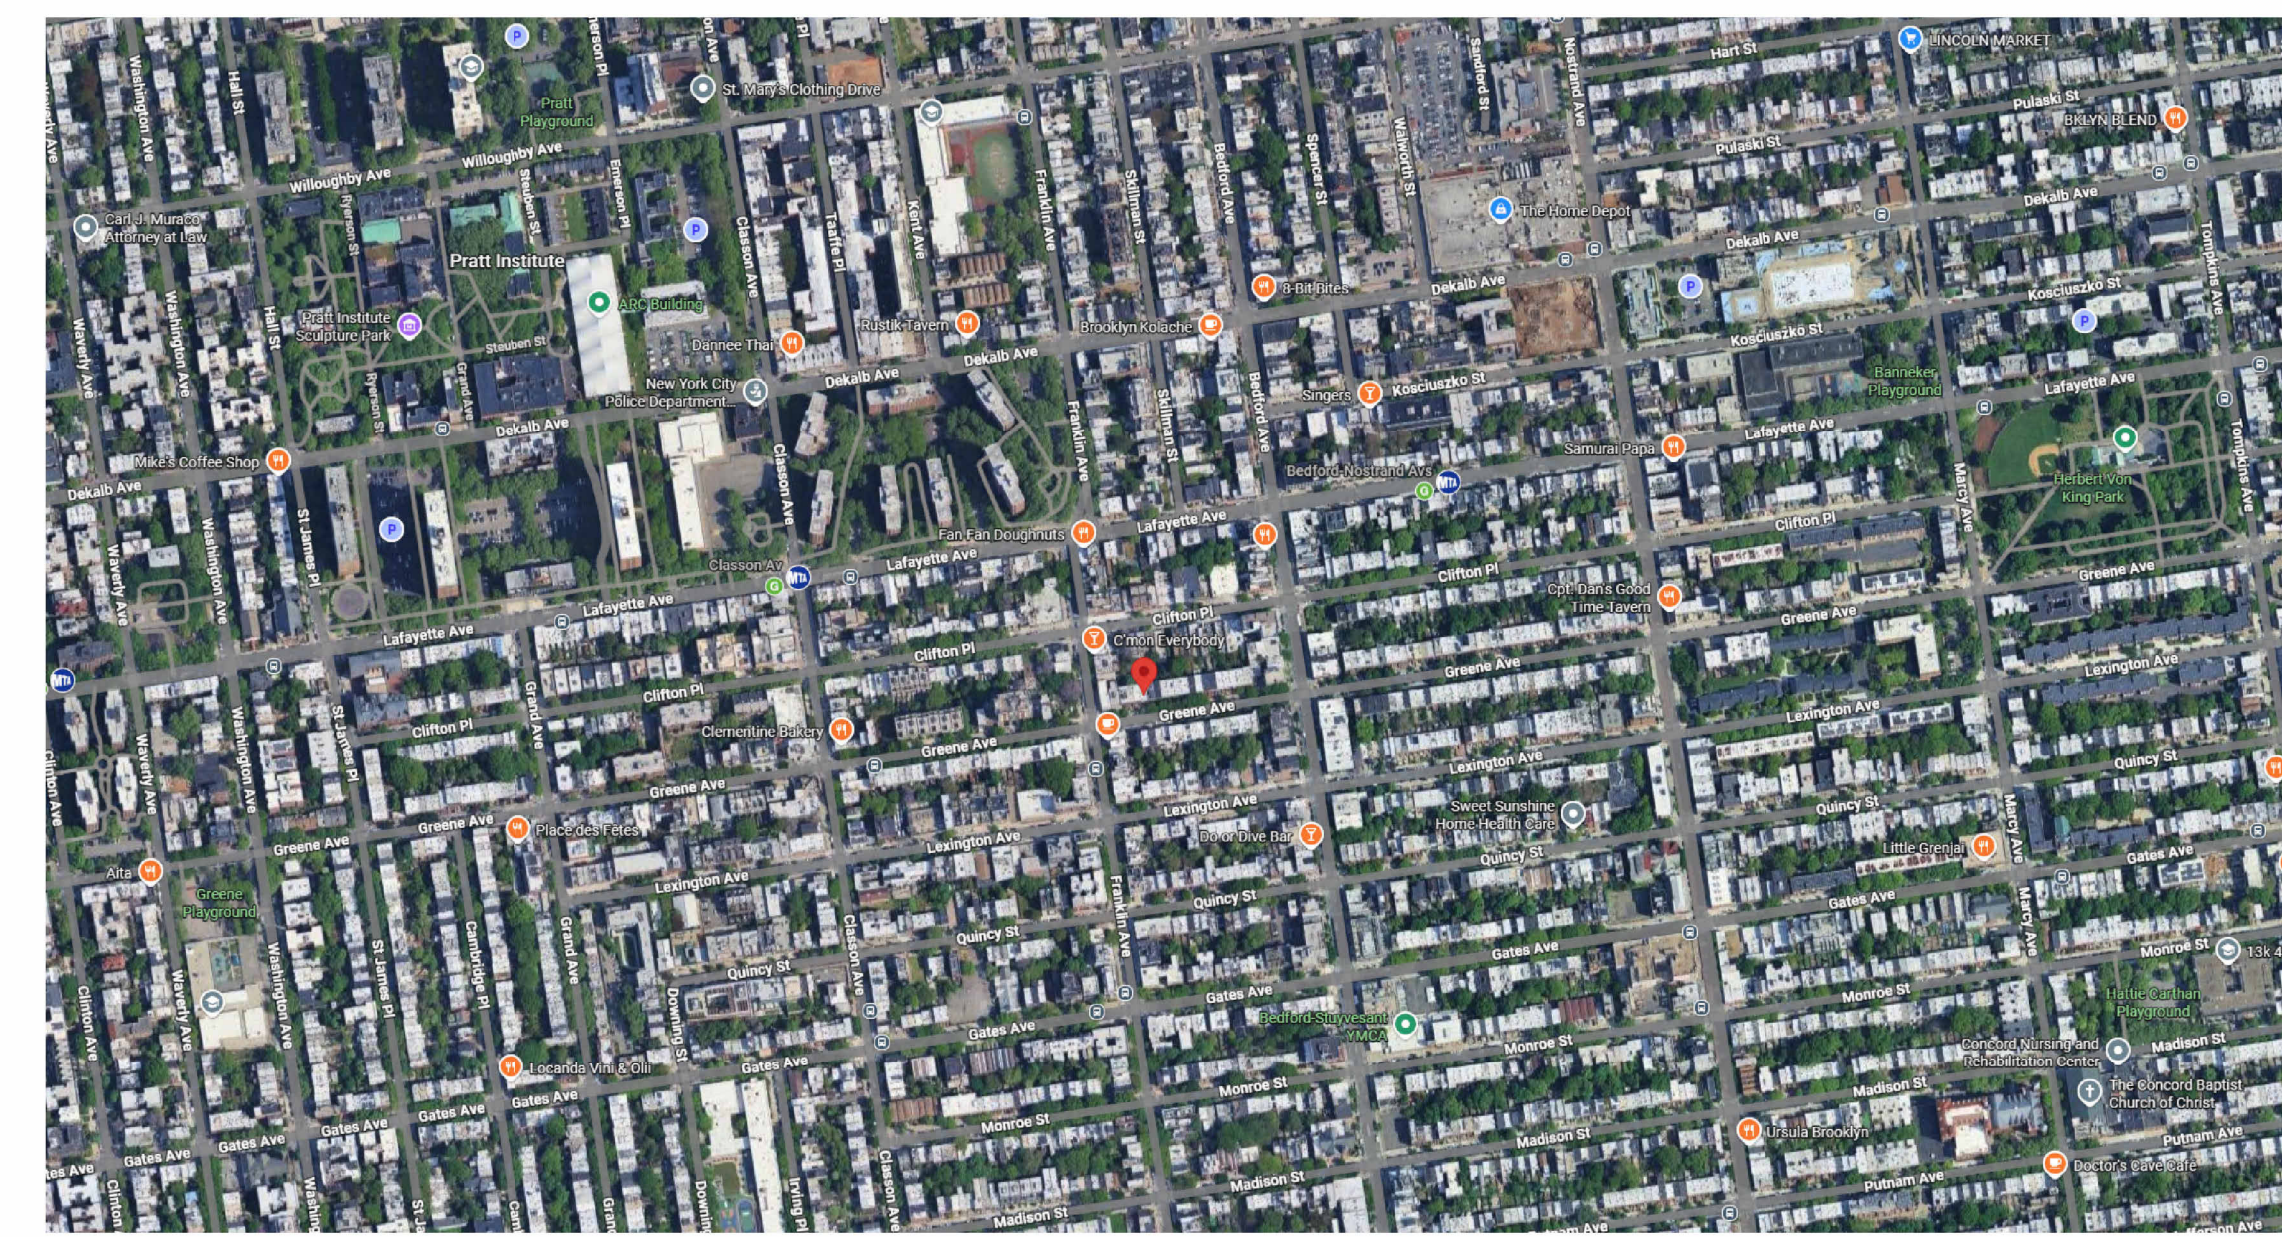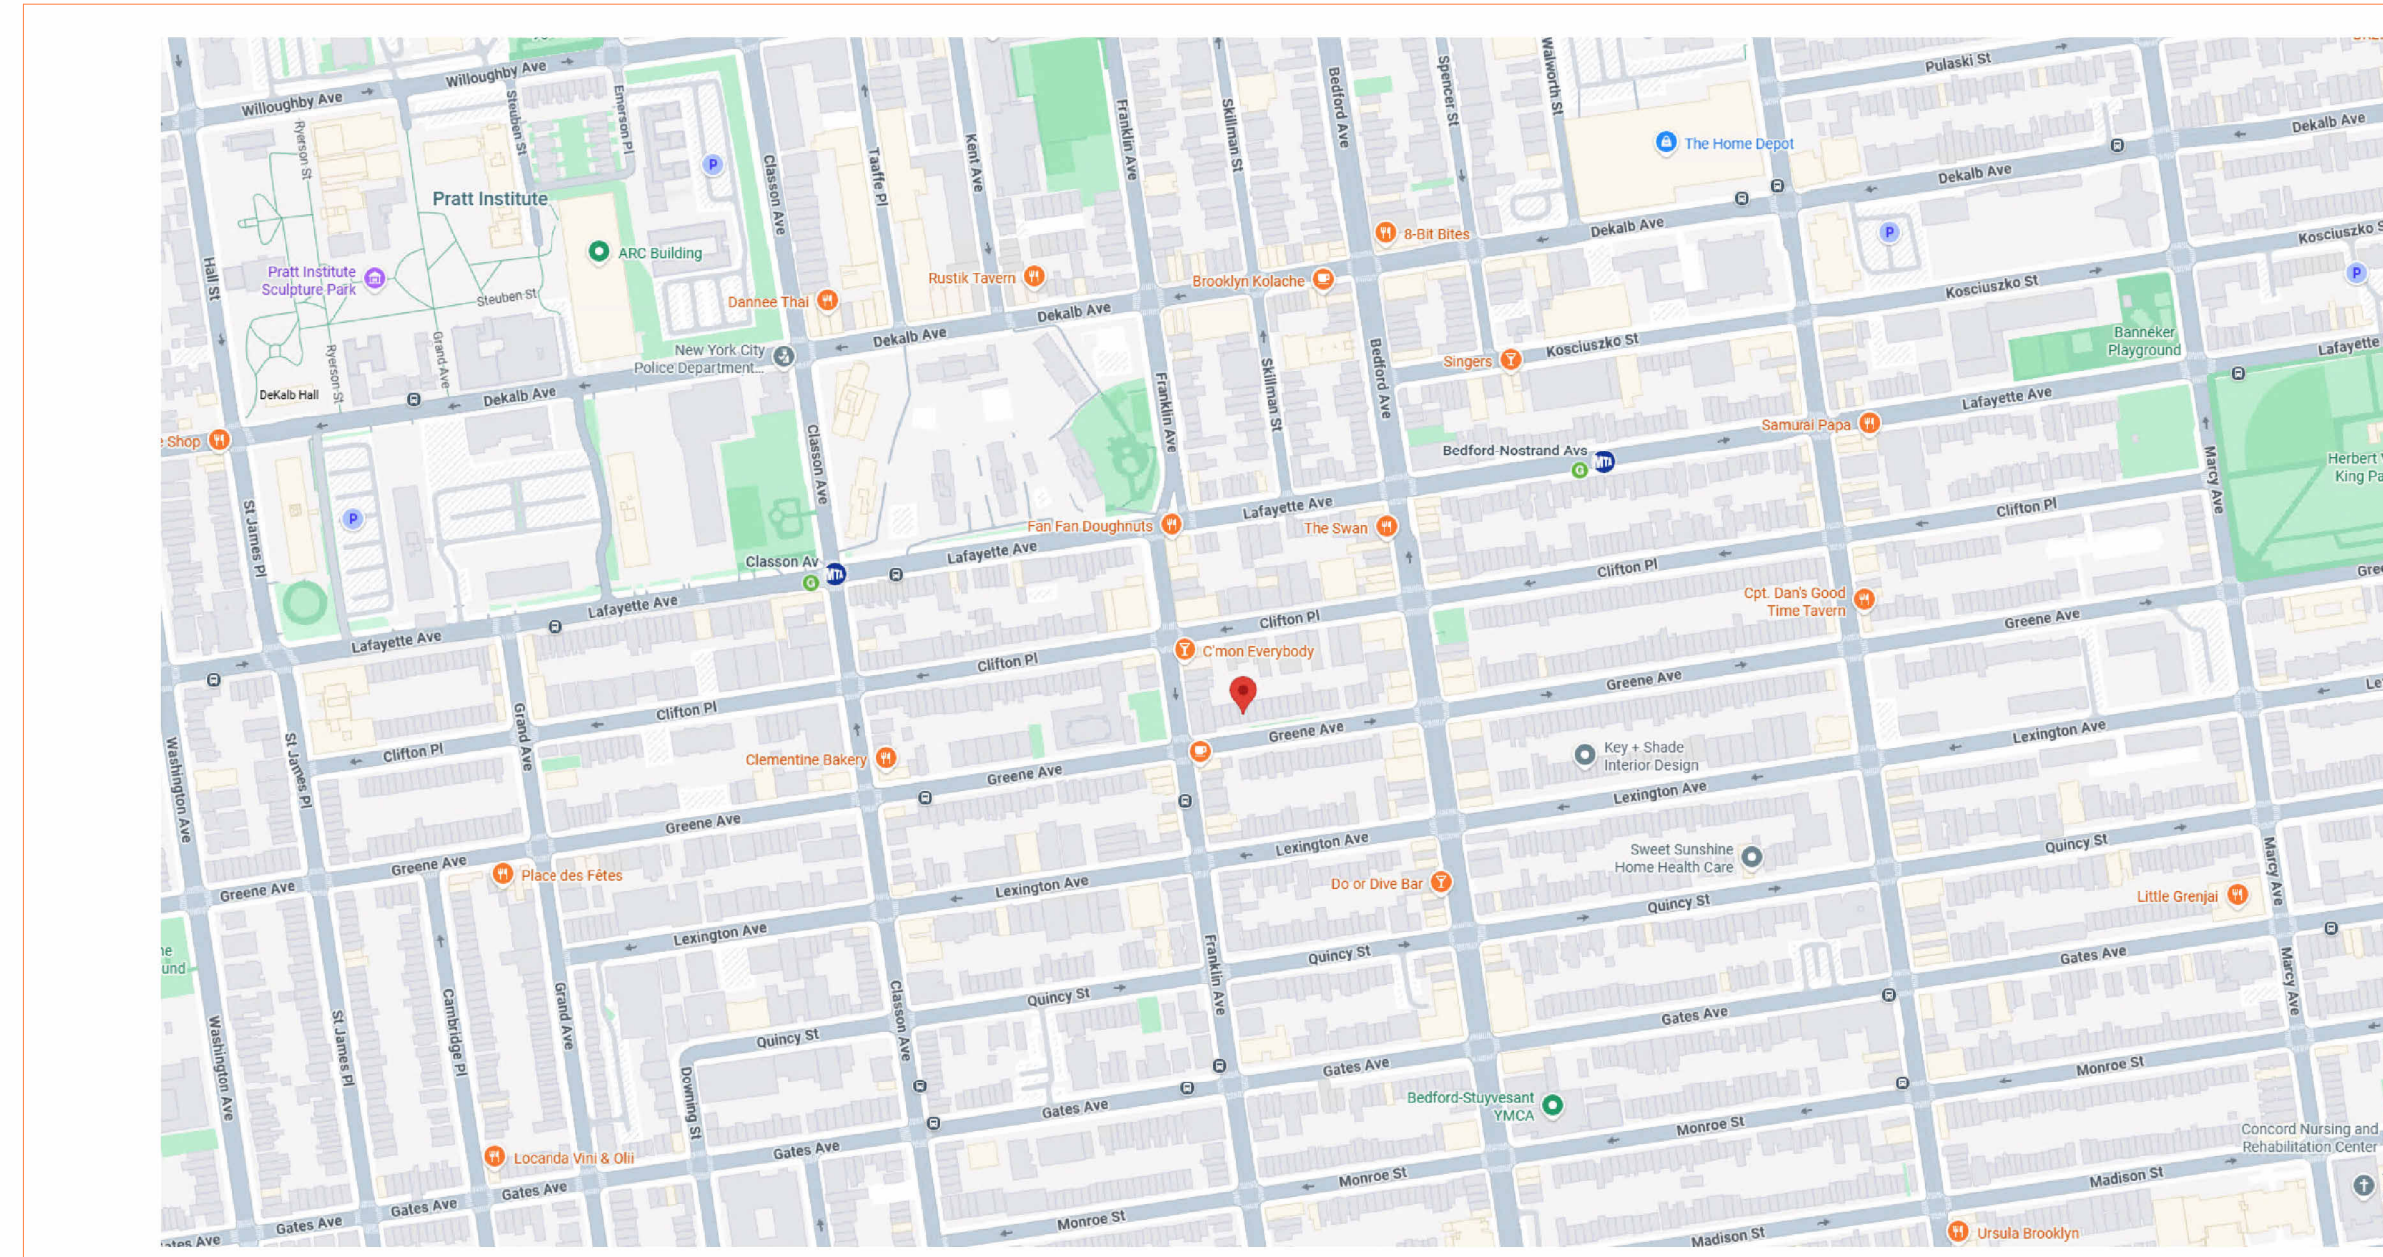

Working Sheet List			
Sheet Number	Sheet Name	Sheet Sort	Sheet Group
A000	Cover	000	General
A001	Cover	000	General
A101	Architectural Floor Plans	070	Architectural
A102	Architectural Floor Plans	070	Architectural
A103	Architectural Floor Plans	070	Architectural
A201	Architectural Building Elevations	070	Architectural
A202	Architectural Building Elevations	070	Architectural
A203	Architectural Building Elevations	070	Architectural
A204	Architectural Building Elevations	070	Architectural
A301	Architectural Building Sections	070	Architectural
A302	Architectural Building Sections	070	Architectural
A303	Architectural Building Sections	070	Architectural
A401	Architectural Enlarged Views	070	Architectural
A402	Architectural Enlarged Views	070	Architectural
A501	Architectural Details	070	Architectural
A502	Architectural Details	070	Architectural
A503	Architectural Details	070	Architectural

Level Schedule					
Name	Elevation Base	Elevation	Structural	Story Above	Workset
L-1	Project Base Point	12' - 8"	No	Default	
L0	Project Base Point	20' - 6"	No	Default	
L1	Project Base Point	29' - 8"	No	Default	
L2	Project Base Point	42' - 0"	No	Default	
L3	Project Base Point	52' - 11"	No	Default	
L4	Project Base Point	63' - 0"	No	Default	

Room Finish Schedule					
Room Number	Room Name	Area	Level	Count	Comments
109	Living Room	247 ft ²	L1	1	
110	Hall	136 ft ²	L1	1	
111	Room	106 ft ²	L1	1	
112	Room	91 ft ²	L1	1	
113	Bath	34 ft ²	L1	1	
114	Storage	21 ft ²	L1	1	
115	Hall	55 ft ²	L1	1	
116	Circulation	18 ft ²	L1	1	
117	Room	232 ft ²	L2	1	
118	Room	234 ft ²	L2	1	
119	Room	77 ft ²	L2	1	
120	Bath	29 ft ²	L2	1	
121	Bath	22 ft ²	L2	1	
122	Hall	110 ft ²	L2	1	
123	Storage	13 ft ²	L2	1	
124	Storage	8 ft ²	L2	1	
125	Living Room	413 ft ²	L0	1	
126	Bath	57 ft ²	L0	1	
127	Hall	36 ft ²	L0	1	
128	Kitchen	147 ft ²	L0	1	
129	Hall	82 ft ²	L0	1	
130	Storage	31 ft ²	L0	1	
131	Backyard	931 ft ²	L0	1	
132	Technical room	51 ft ²	L-1	1	
133	Storage	62 ft ²	L-1	1	
134	Basement	534 ft ²	L-1	1	
135	Room	248 ft ²	L3	1	
136	Room	75 ft ²	L3	1	
137	Kitchen	26 ft ²	L3	1	
138	Room	190 ft ²	L3	1	
139	Room	73 ft ²	L3	1	
140	Kitchen	28 ft ²	L3	1	
141	Hall	95 ft ²	L3	1	



TECHSCAN
Surveying As Builds and Geospatial Solutions

365 Greene Ave, Brooklyn

Cover

Project number 001

Date Issue Date

Checked by Checker

A000

Scale



18 Spencer St, Brooklyn,
NY 11205
info@TechScanusa.com
TechScanusa.com
(929) 486 9091

AS-BUILT DOCUMENTATION

Symbols Legend

Reflected Ceiling Plan

General

	Section Head
	Centerline
	Section Head - Triangle
	Interior Elevation Marker
	Elevation Marker
	Room Tag
	Grid Head
	Elevation Marker
	North Marker
	Revision tag
	Section Head
	Section Head
	Section tail
	Spot elevation
	View reference
	View title
	Windows tag

Note:

Although every attempt has been made to ensure the quality and accuracy of these asbuilt drawings, prior to the commencement of any office or fieldwork these as built drawings must be field verified for any discrepancies. Asbuilt Professionals must be notified within 30 days of the date of delivery in writing as to any discrepancies. The discovery of any discrepancies after 30 days or after the commencement of any office or fieldwork is the full responsibility of the client to remedy.

	Exhaust vent		Track light or vanity light
	Ceiling mounted light fixture		Wall-mounted light fixture
	Ceiling mounted directional light		Emergency exit sign
	Recessed can light		Emergency exit light
	Eyeball or small can light		Emergency exit light w/ sign
	Pendant light		Lighted stair sign
	Individual floor, lay-in fixture 4 bulb		Flood light
	Individual floor, hanging fixture 2 bulb		Photo cell
	Individual floor, flush mount fixture 4 bulb		Ceiling fan
	Camera		Ceiling fan w/ light kit
	Motion det.		Ceiling height and trim 7'-2" above floor below with 6" crown moulding. Note: all ceilings not labeled are plaster. Ceilings shown with a grid are lay in acoustical tile.
	Supply vent		Junction box
	Return vent		
	Spaker		

Fire protection

	Fire extinguisher
	Fire pull
	Fire alarm (horn/strobe)
	Smoke detector
	Smoke alarm speaker
	Sprinkler head ceiling mount
	Sprinkler head wall mount

MISC

	Bollard
	Spot elevation

Electric

	Data outlet		Basic switch
	Telephone jack		Occupancy sensor switch
	Electric switch		Dimmer switch
	Cable television outlet		Double pole switch
	Duplex receptacle outlet		Three-way switch
	Special purpose connection or outlet		Four-way switch
	Quadruplex receptacle outlet		Emergency switch
	Floor duplex receptacle outlet		Timmer switch
	Electric panel		GFCI receptacle
	Electric meter		Weatherproof receptacle
	Button switch		USB receptacle
	Disconnect switch		Wireless access point (WAP)
	Ground/floor light		Transformer
	Key pad		

MEP

	Thermostat		HVAC duct
	Floor drain		Rectangular duct
	Valve		Round duct
	Hose bib		Flexible duct
	Water supply		Duct shaft
	Suspended gas heater		



TECHSCAN
Surveying As Builds and Geospatial Solutions

365 Greene Ave, Brooklyn

Cover

Project number 001

Date Issue Date

Checked by Checker

A001


Scale 1 : 50




18 Spencer St, Brooklyn,
NY 11205
info@TechScanusa.com
TechScanusa.com
(929) 486 9091



TECHSCAN
Surveying As Builds and Geospatial Solutions

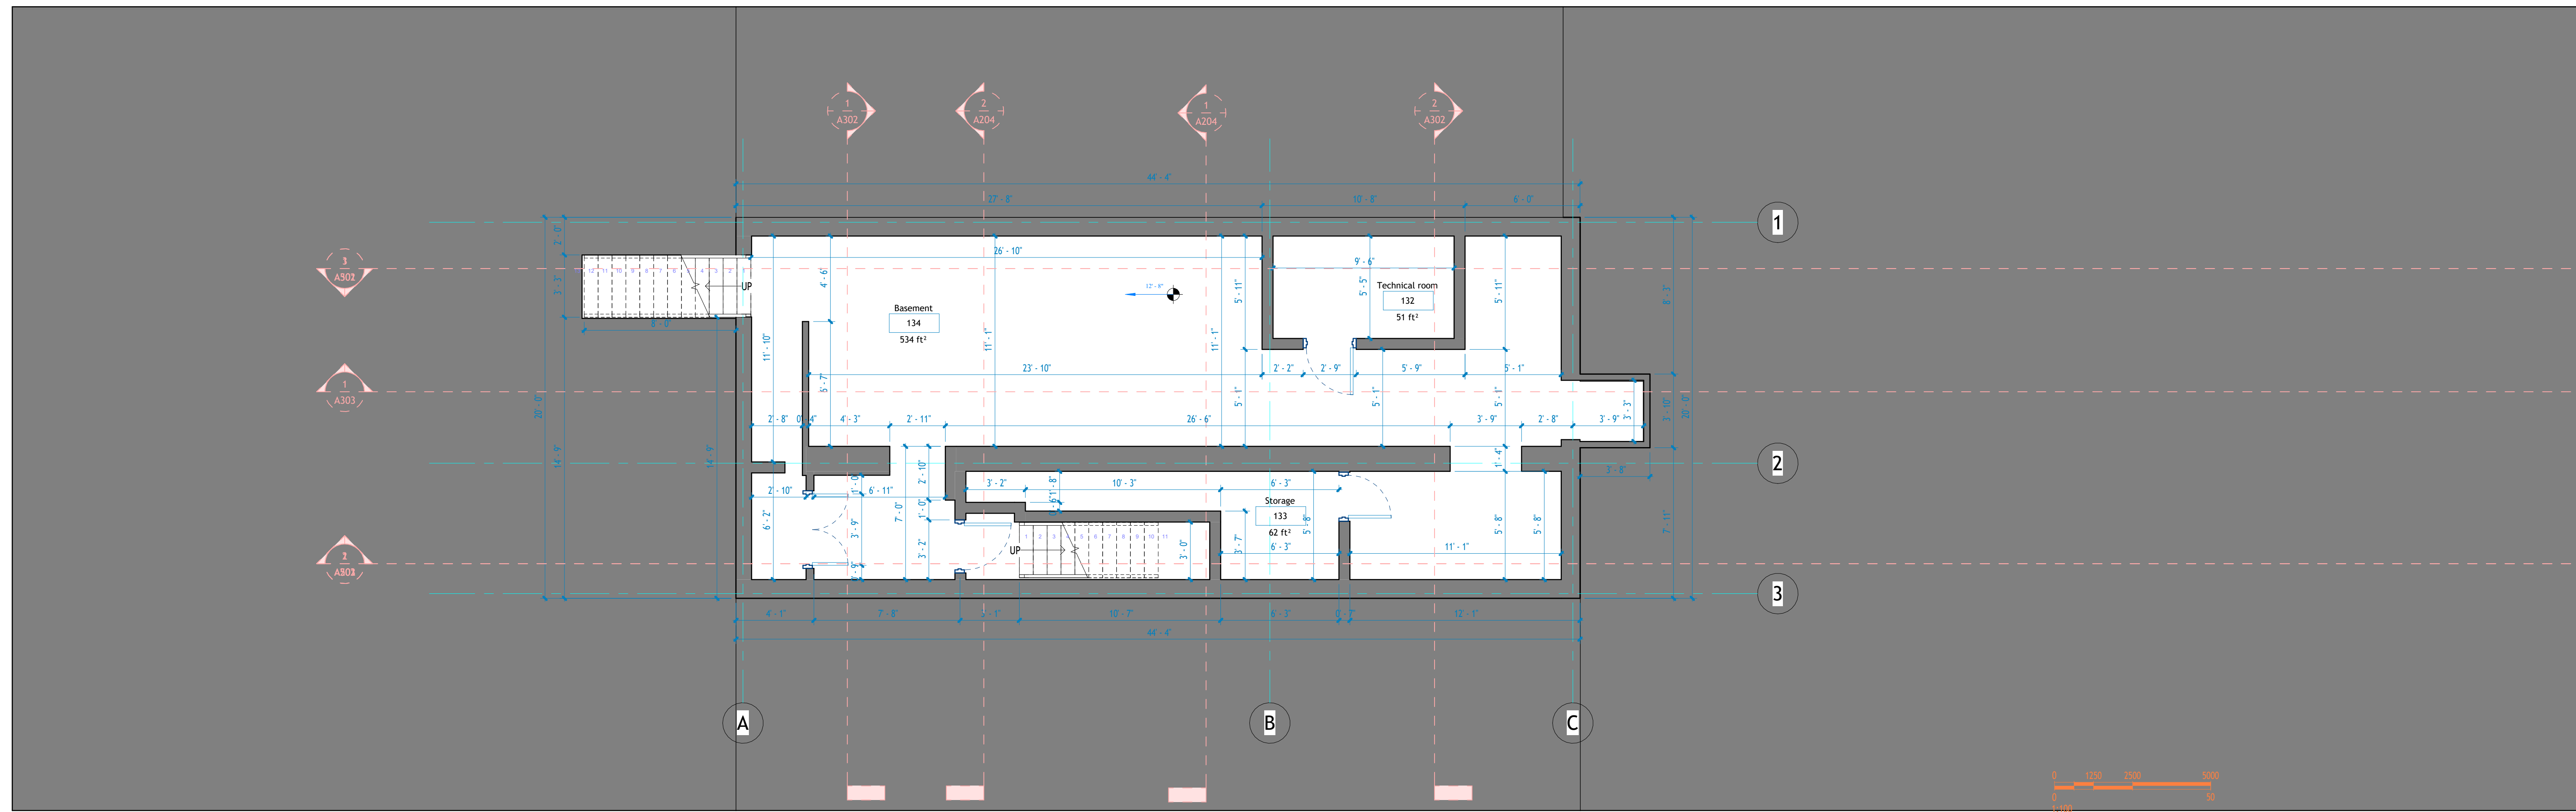

2 L-1
1 : 50

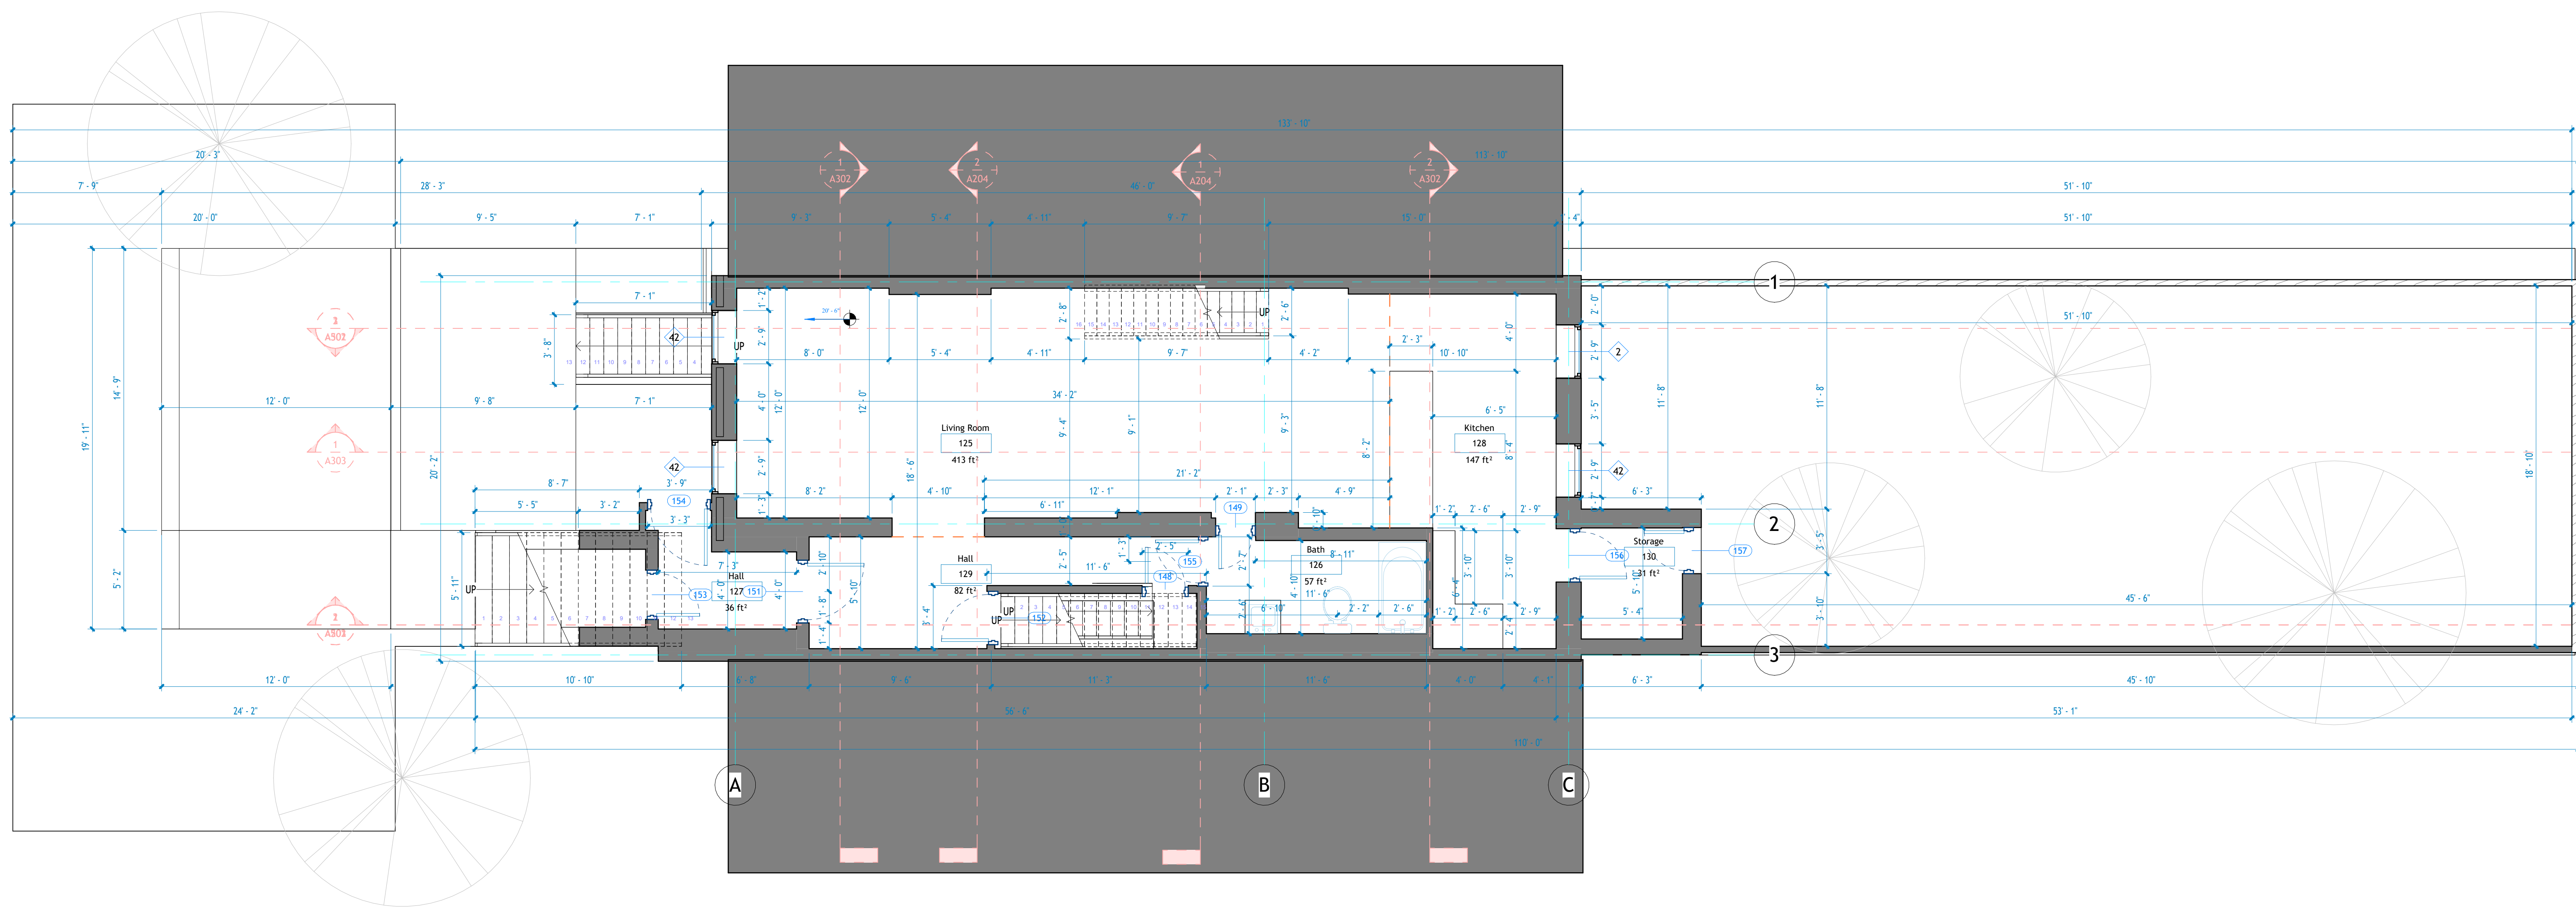

1 L0
1 : 50

365 Greene Ave, Brooklyn

Architectural Floor Plans

Project number 001

Date Issue Date



Checked by Checker

A101



Scale 1 : 50



18 Spencer St, Brooklyn,
NY 11205
info@TechScanusa.com
TechScanusa.com
(929) 486 9091

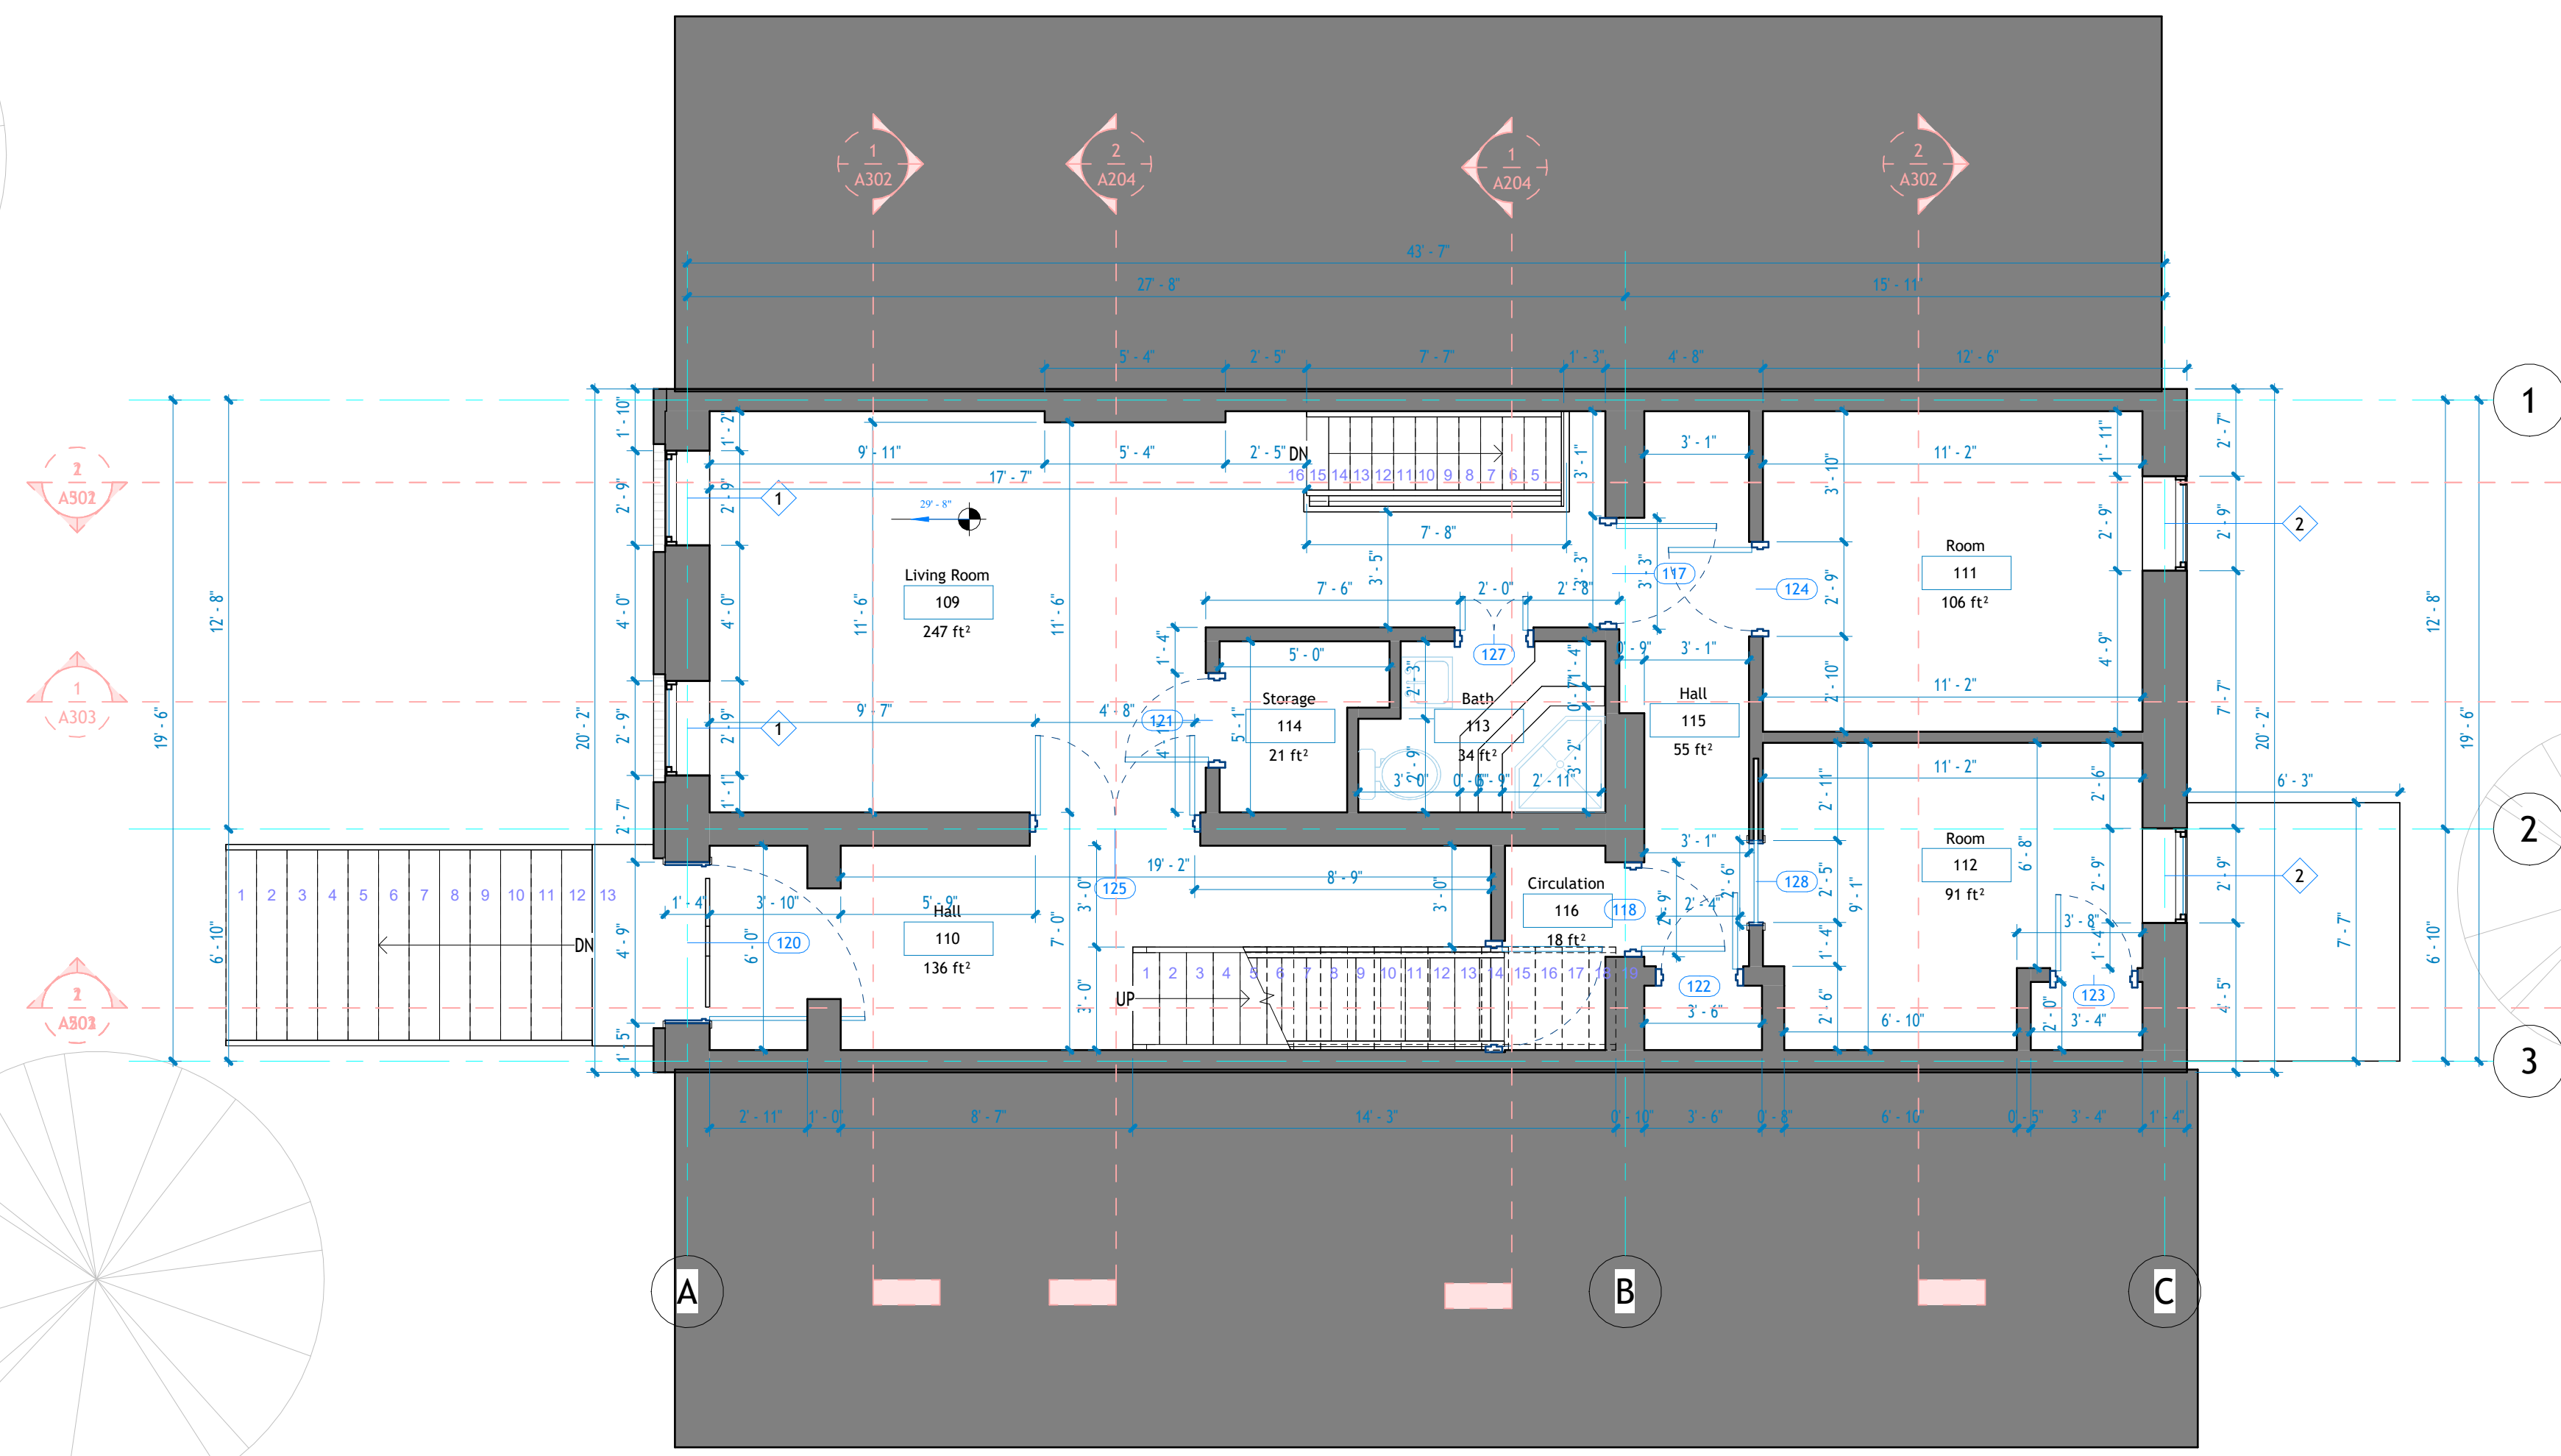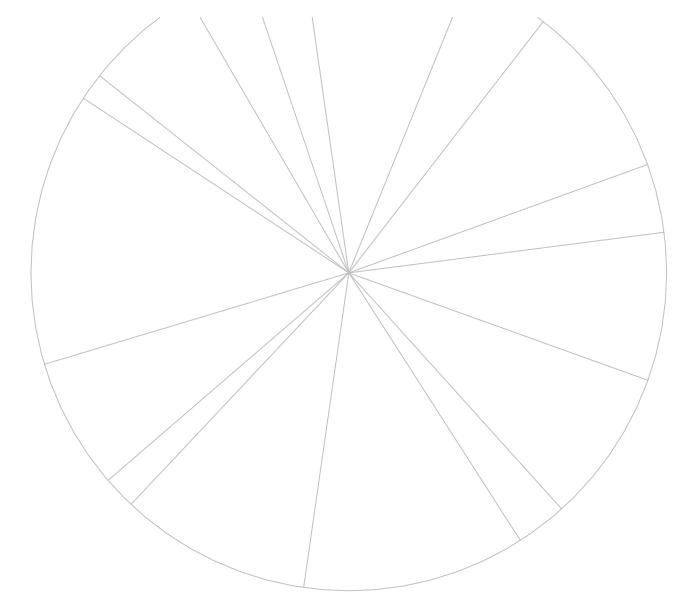

1 First Floor Architectural Plan
1:50

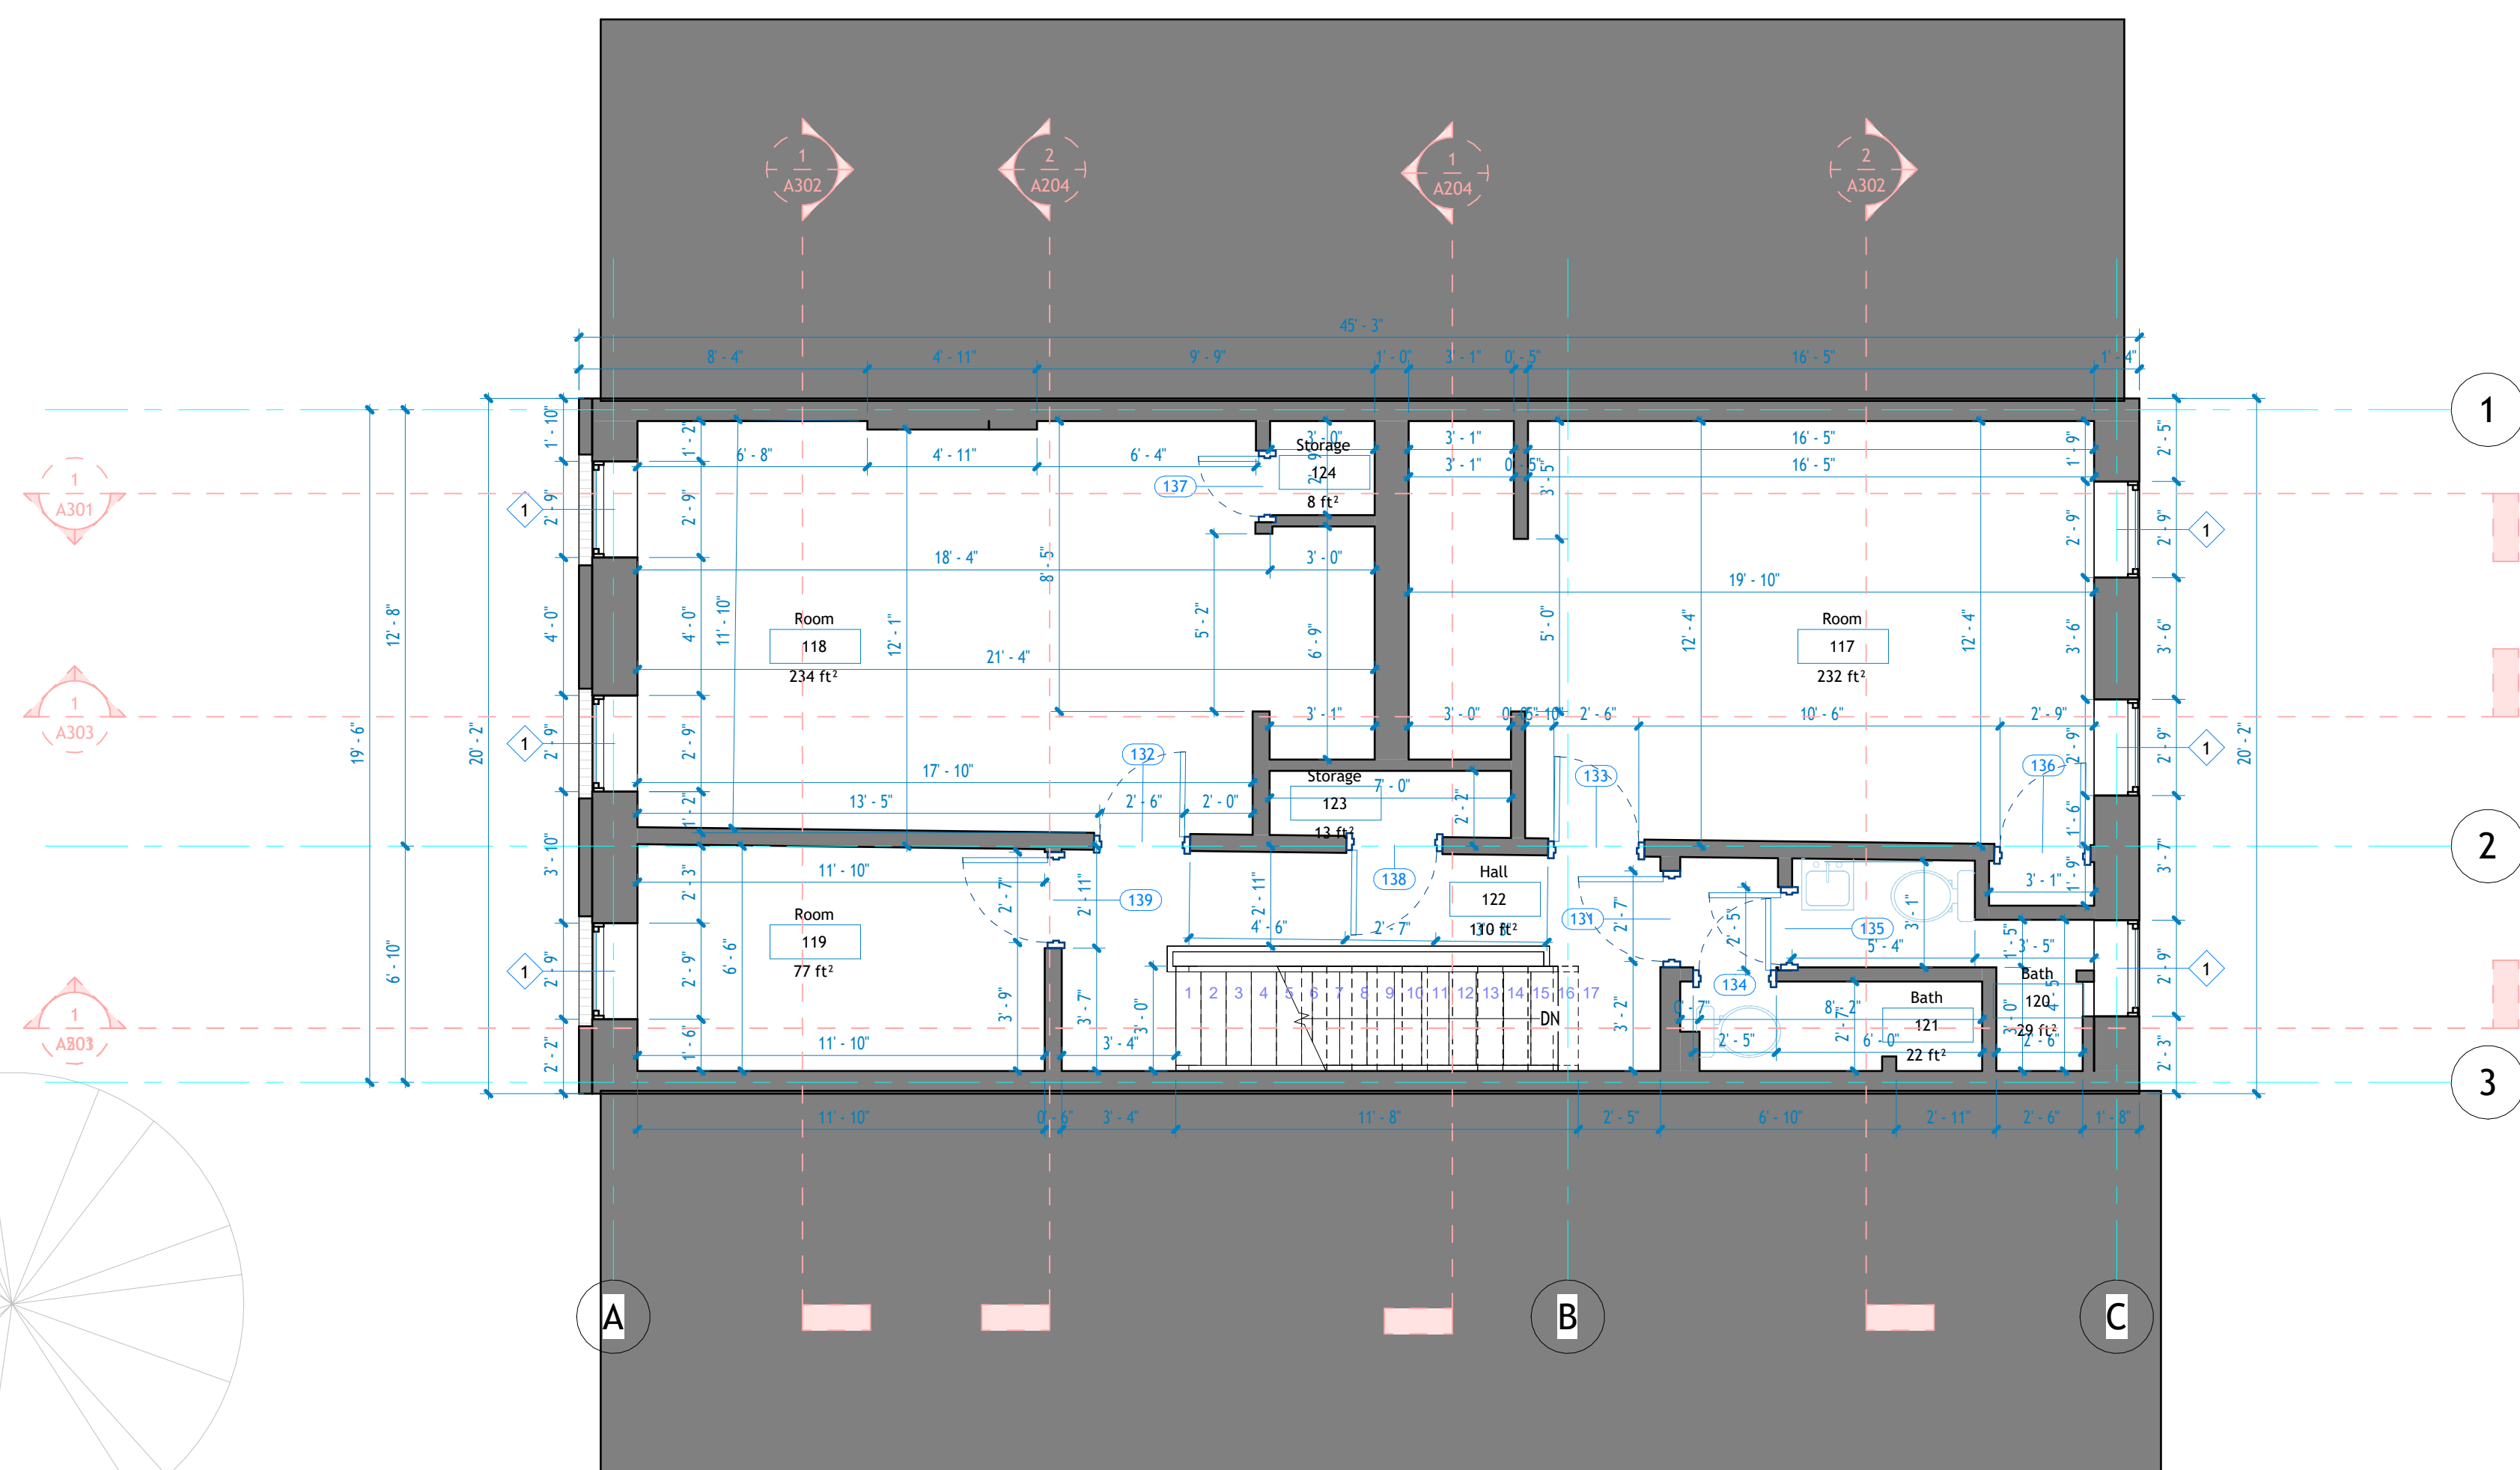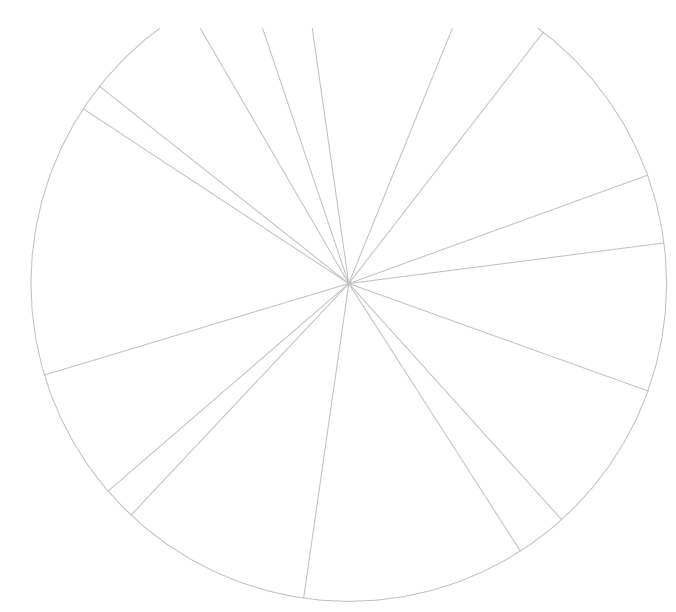

2 Second Floor Architectural Plan
1:50



TECHSCAN
Surveying As Builds and Geospatial Solutions

365 Greene Ave, Brooklyn

Architectural Floor Plans

Project number 001

Date Issue Date


Checked by Checker

A102


Scale 1 : 50



18 Spencer St, Brooklyn,
NY 11205
info@TechScanusa.com
TechScanusa.com
(929) 486 9091

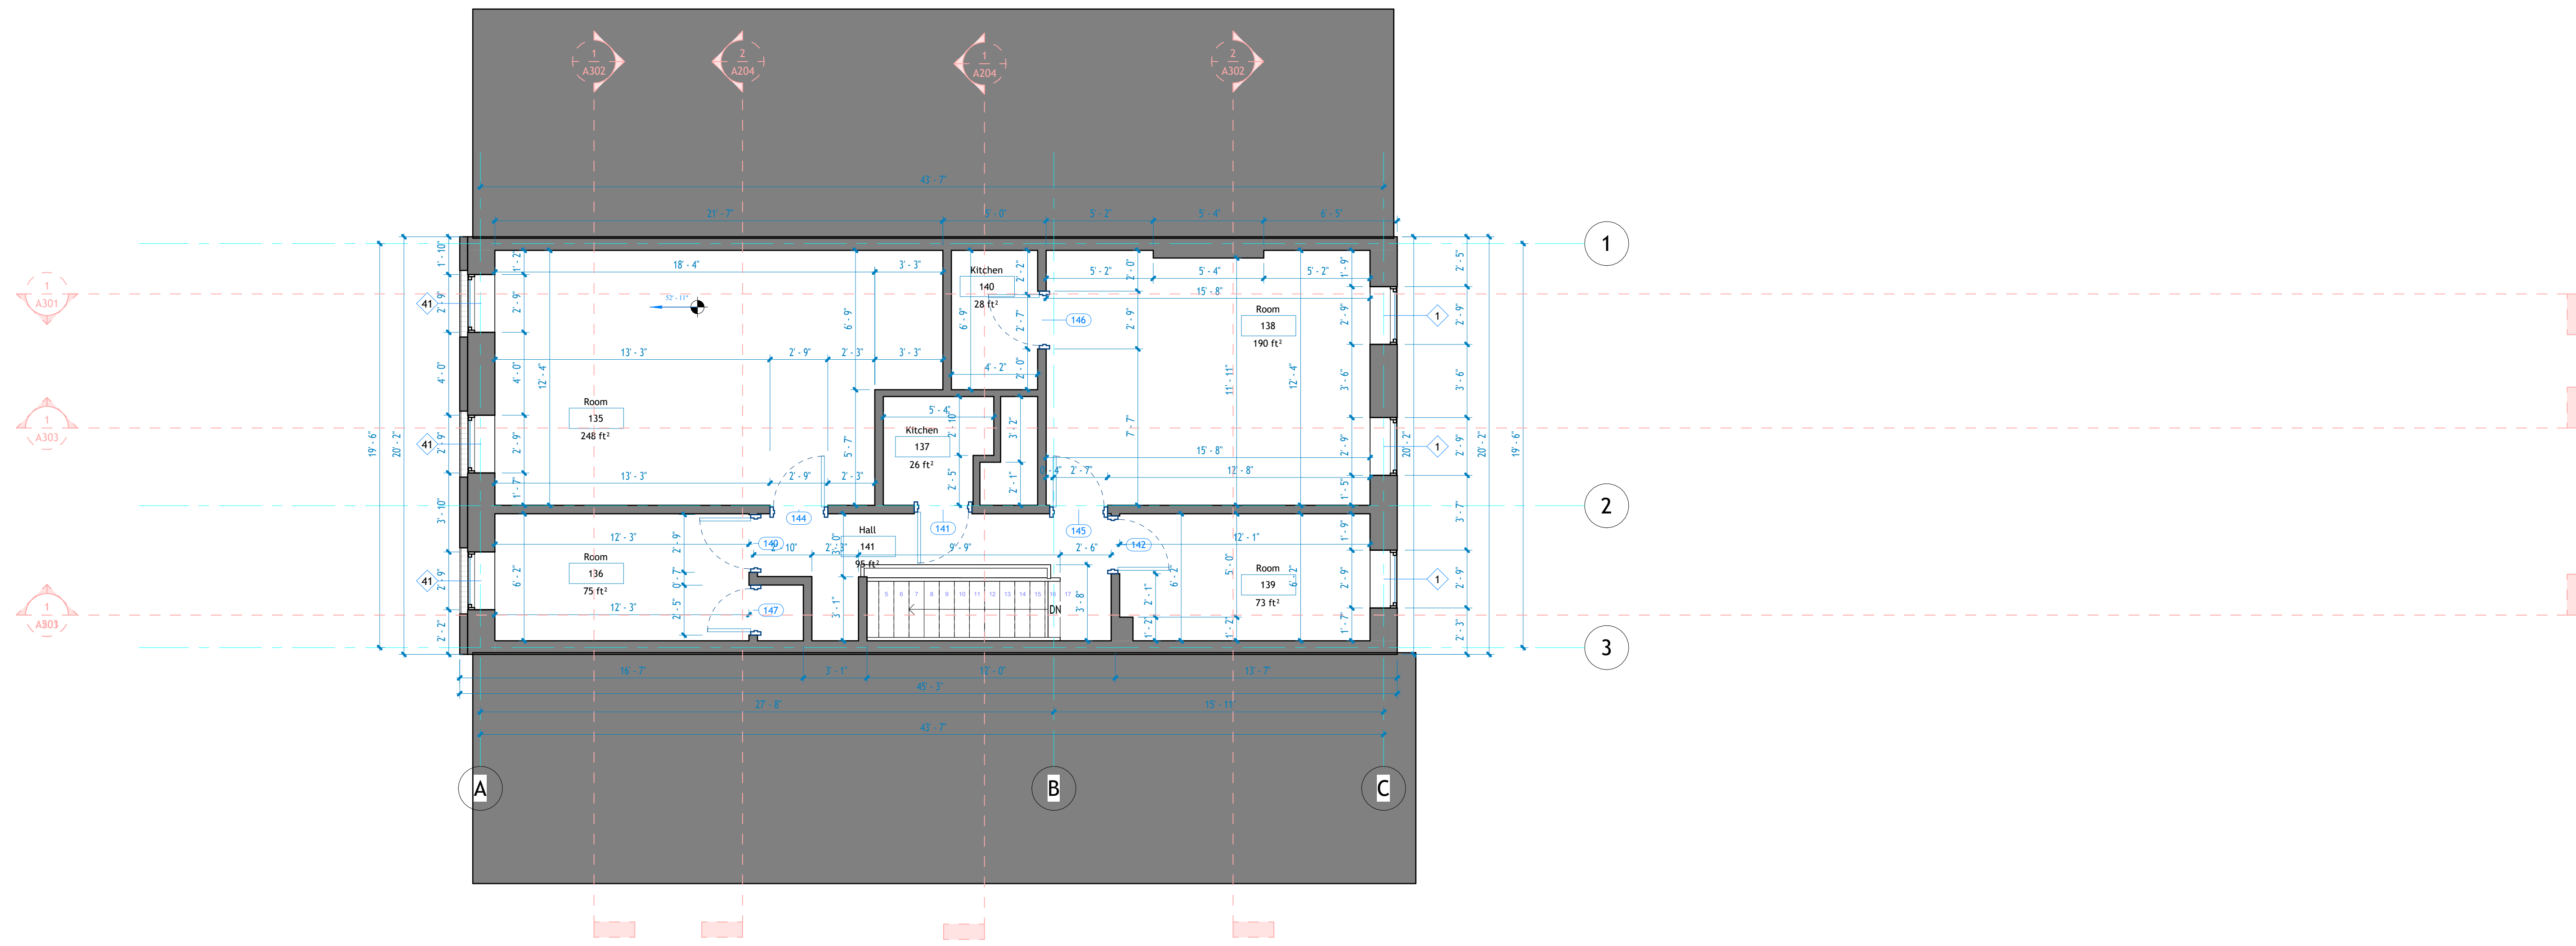

1 L3
1:50

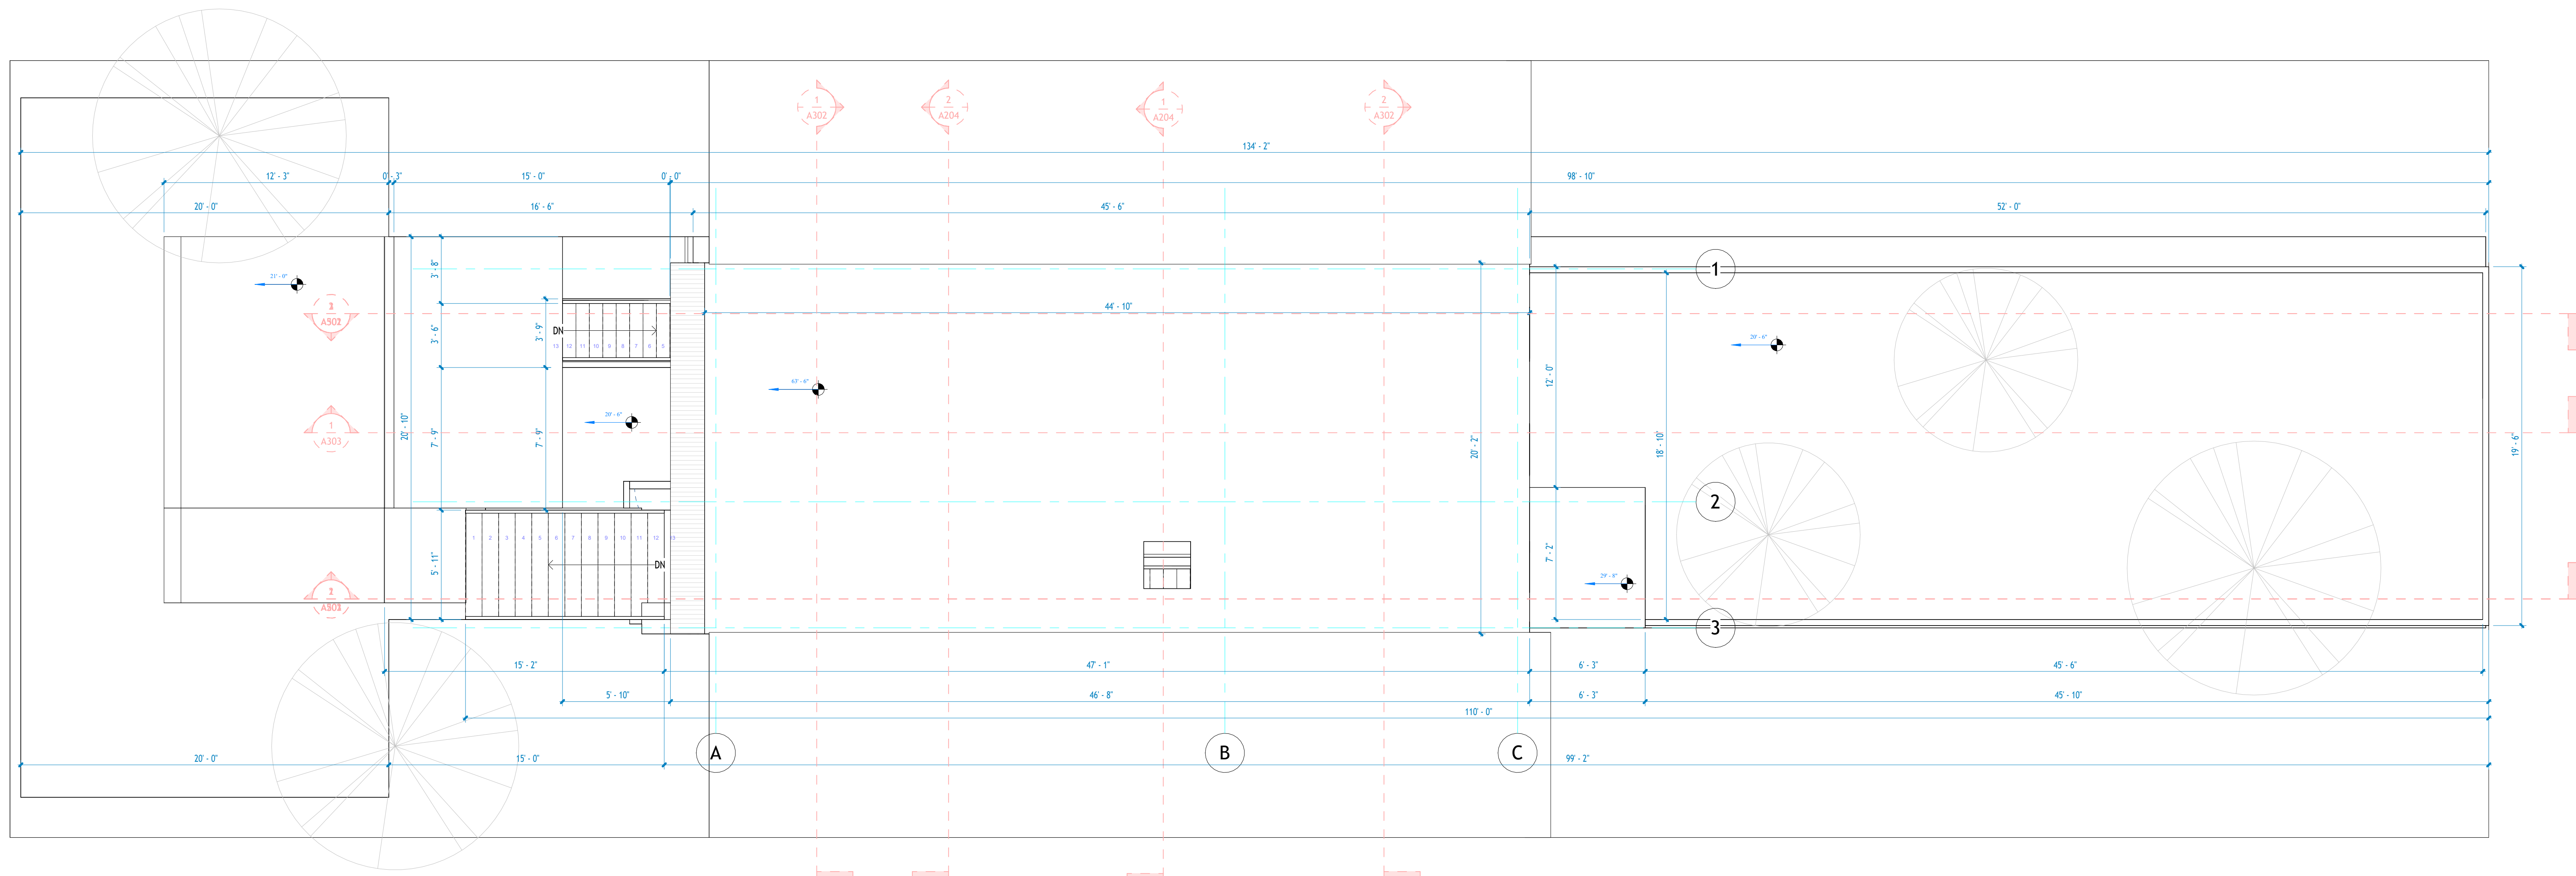

2 L4
1:50




TECHSCAN
Surveying As Builds and Geospatial Solutions


365 Greene Ave, Brooklyn	
Architectural Floor Plans	
Project number	001
Date	Issue Date
Checked by	Checker
A103	
Scale	1 : 50



18 Spencer St, Brooklyn,
NY 11205
info@TechScanusa.com
TechScanusa.com
(929) 486 9091

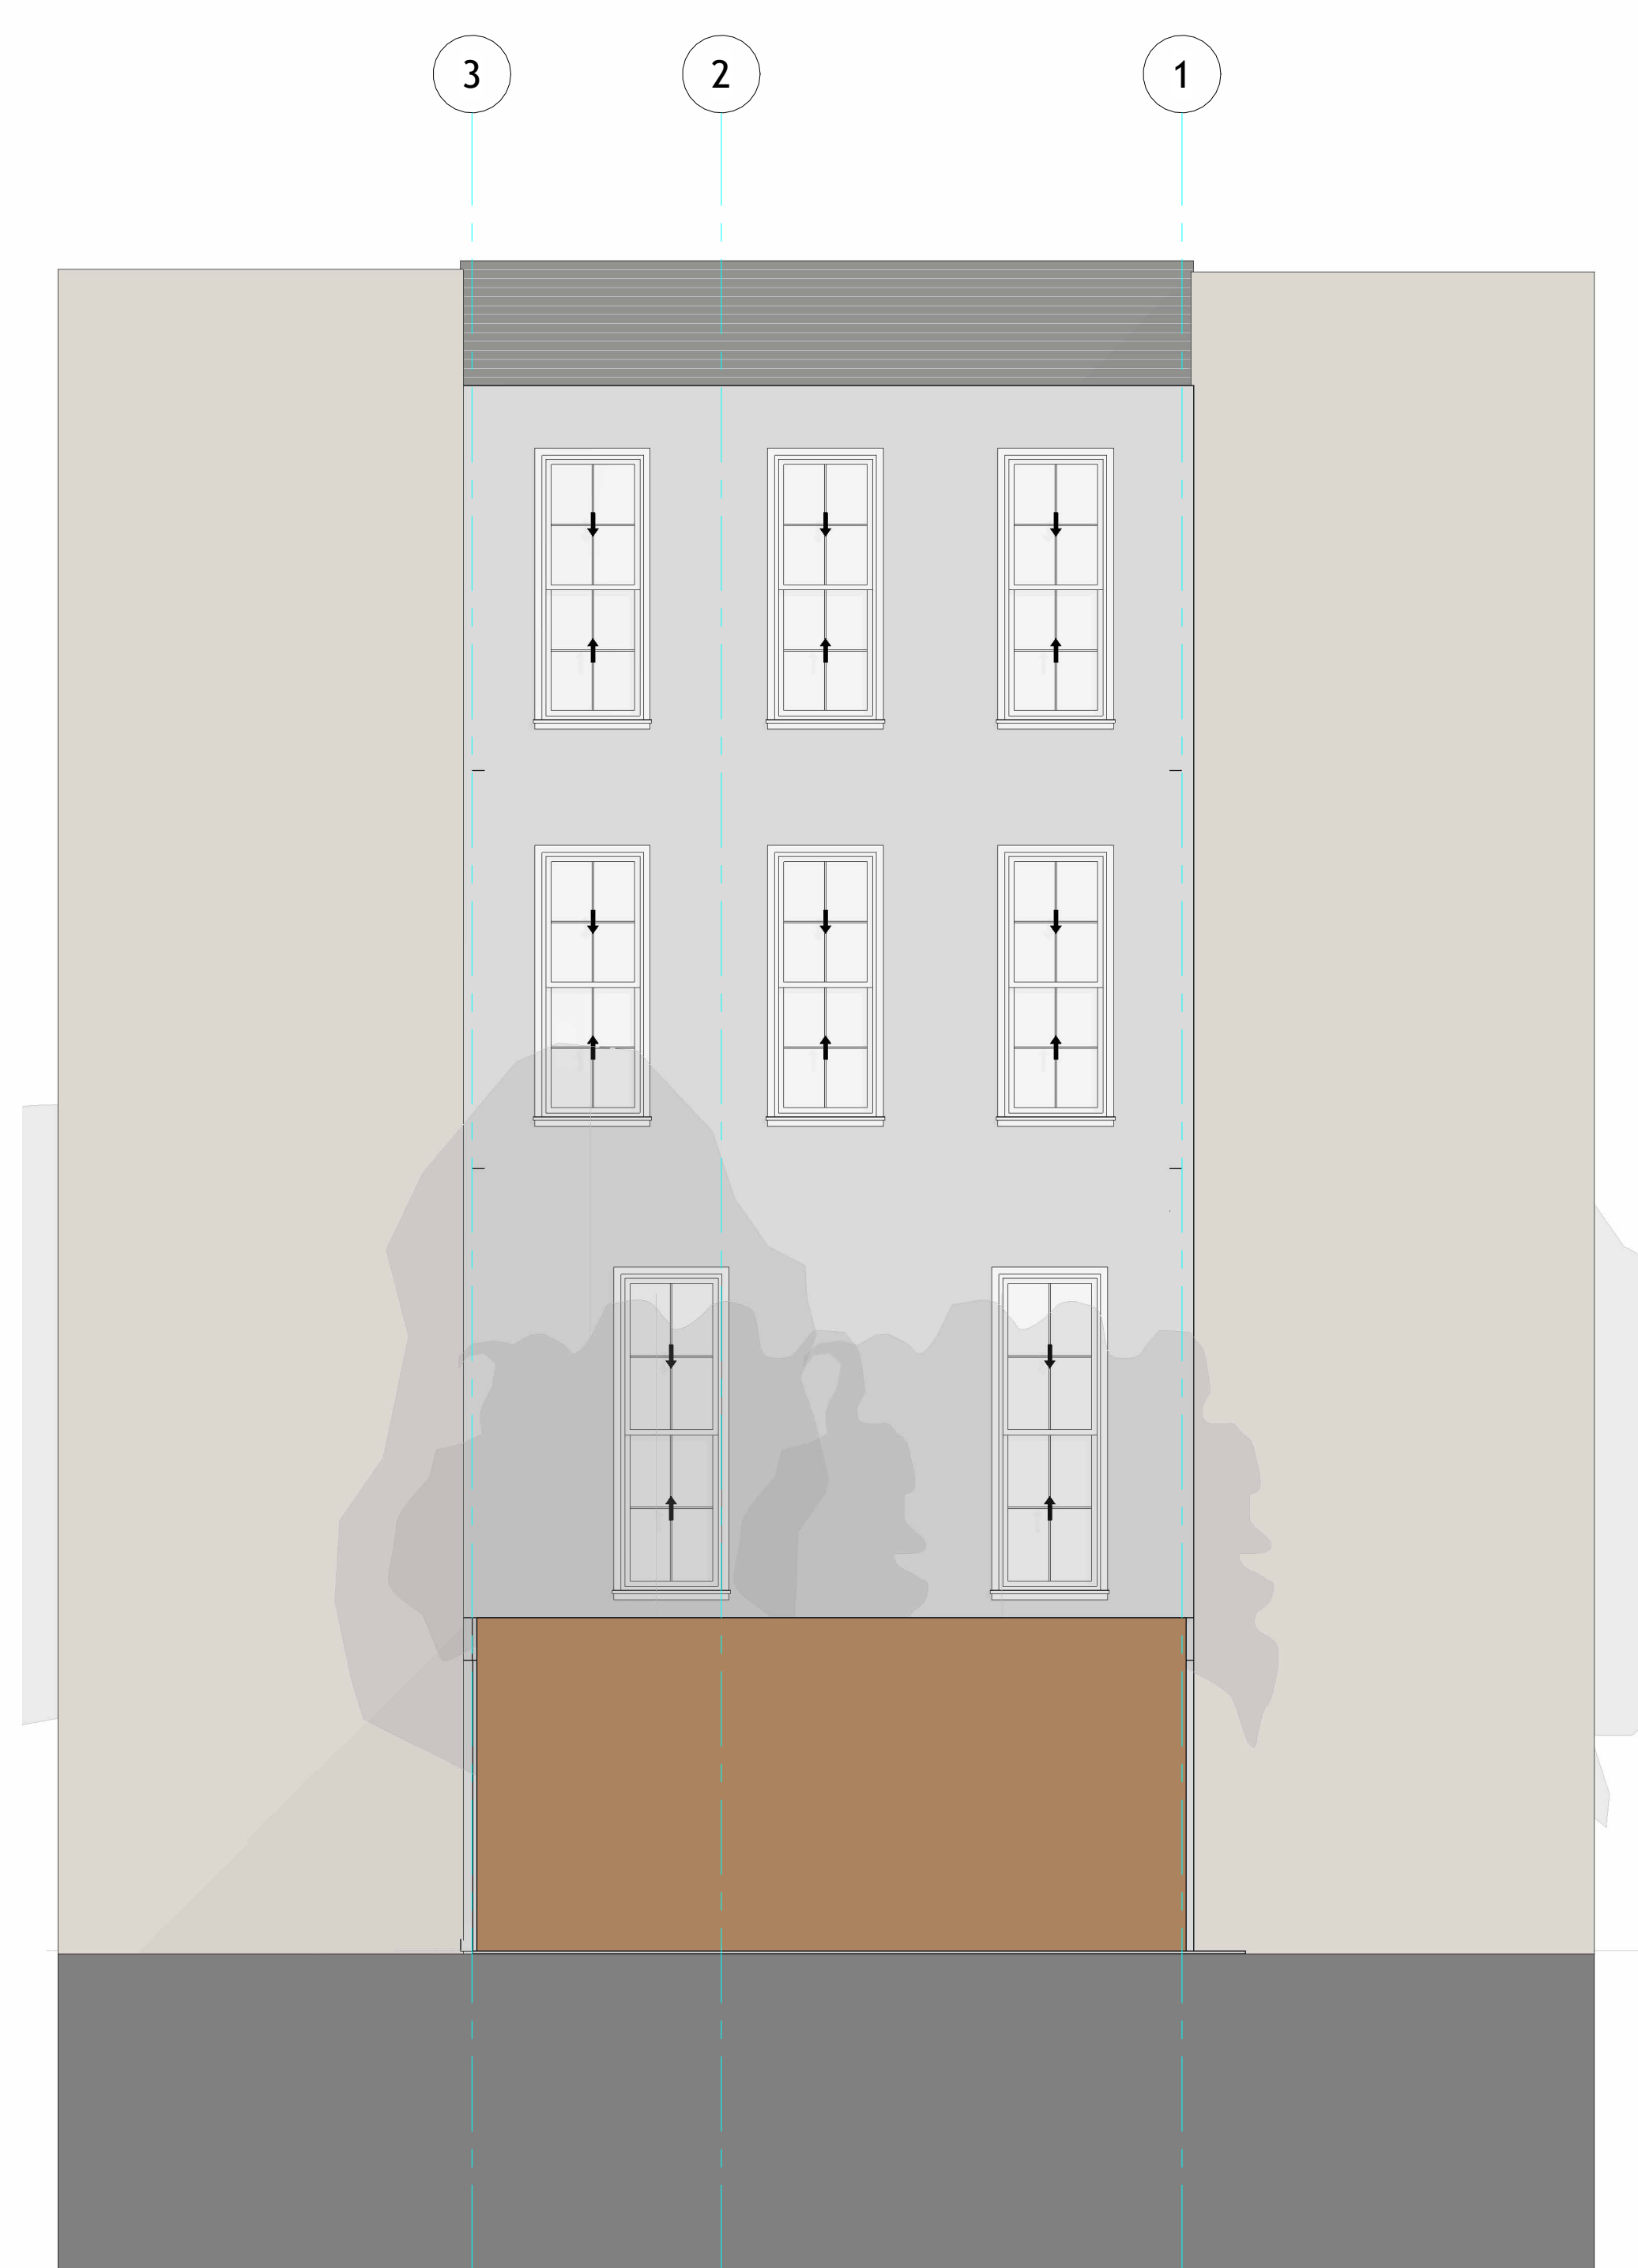

① East Architectural Building
Elevation
1:50

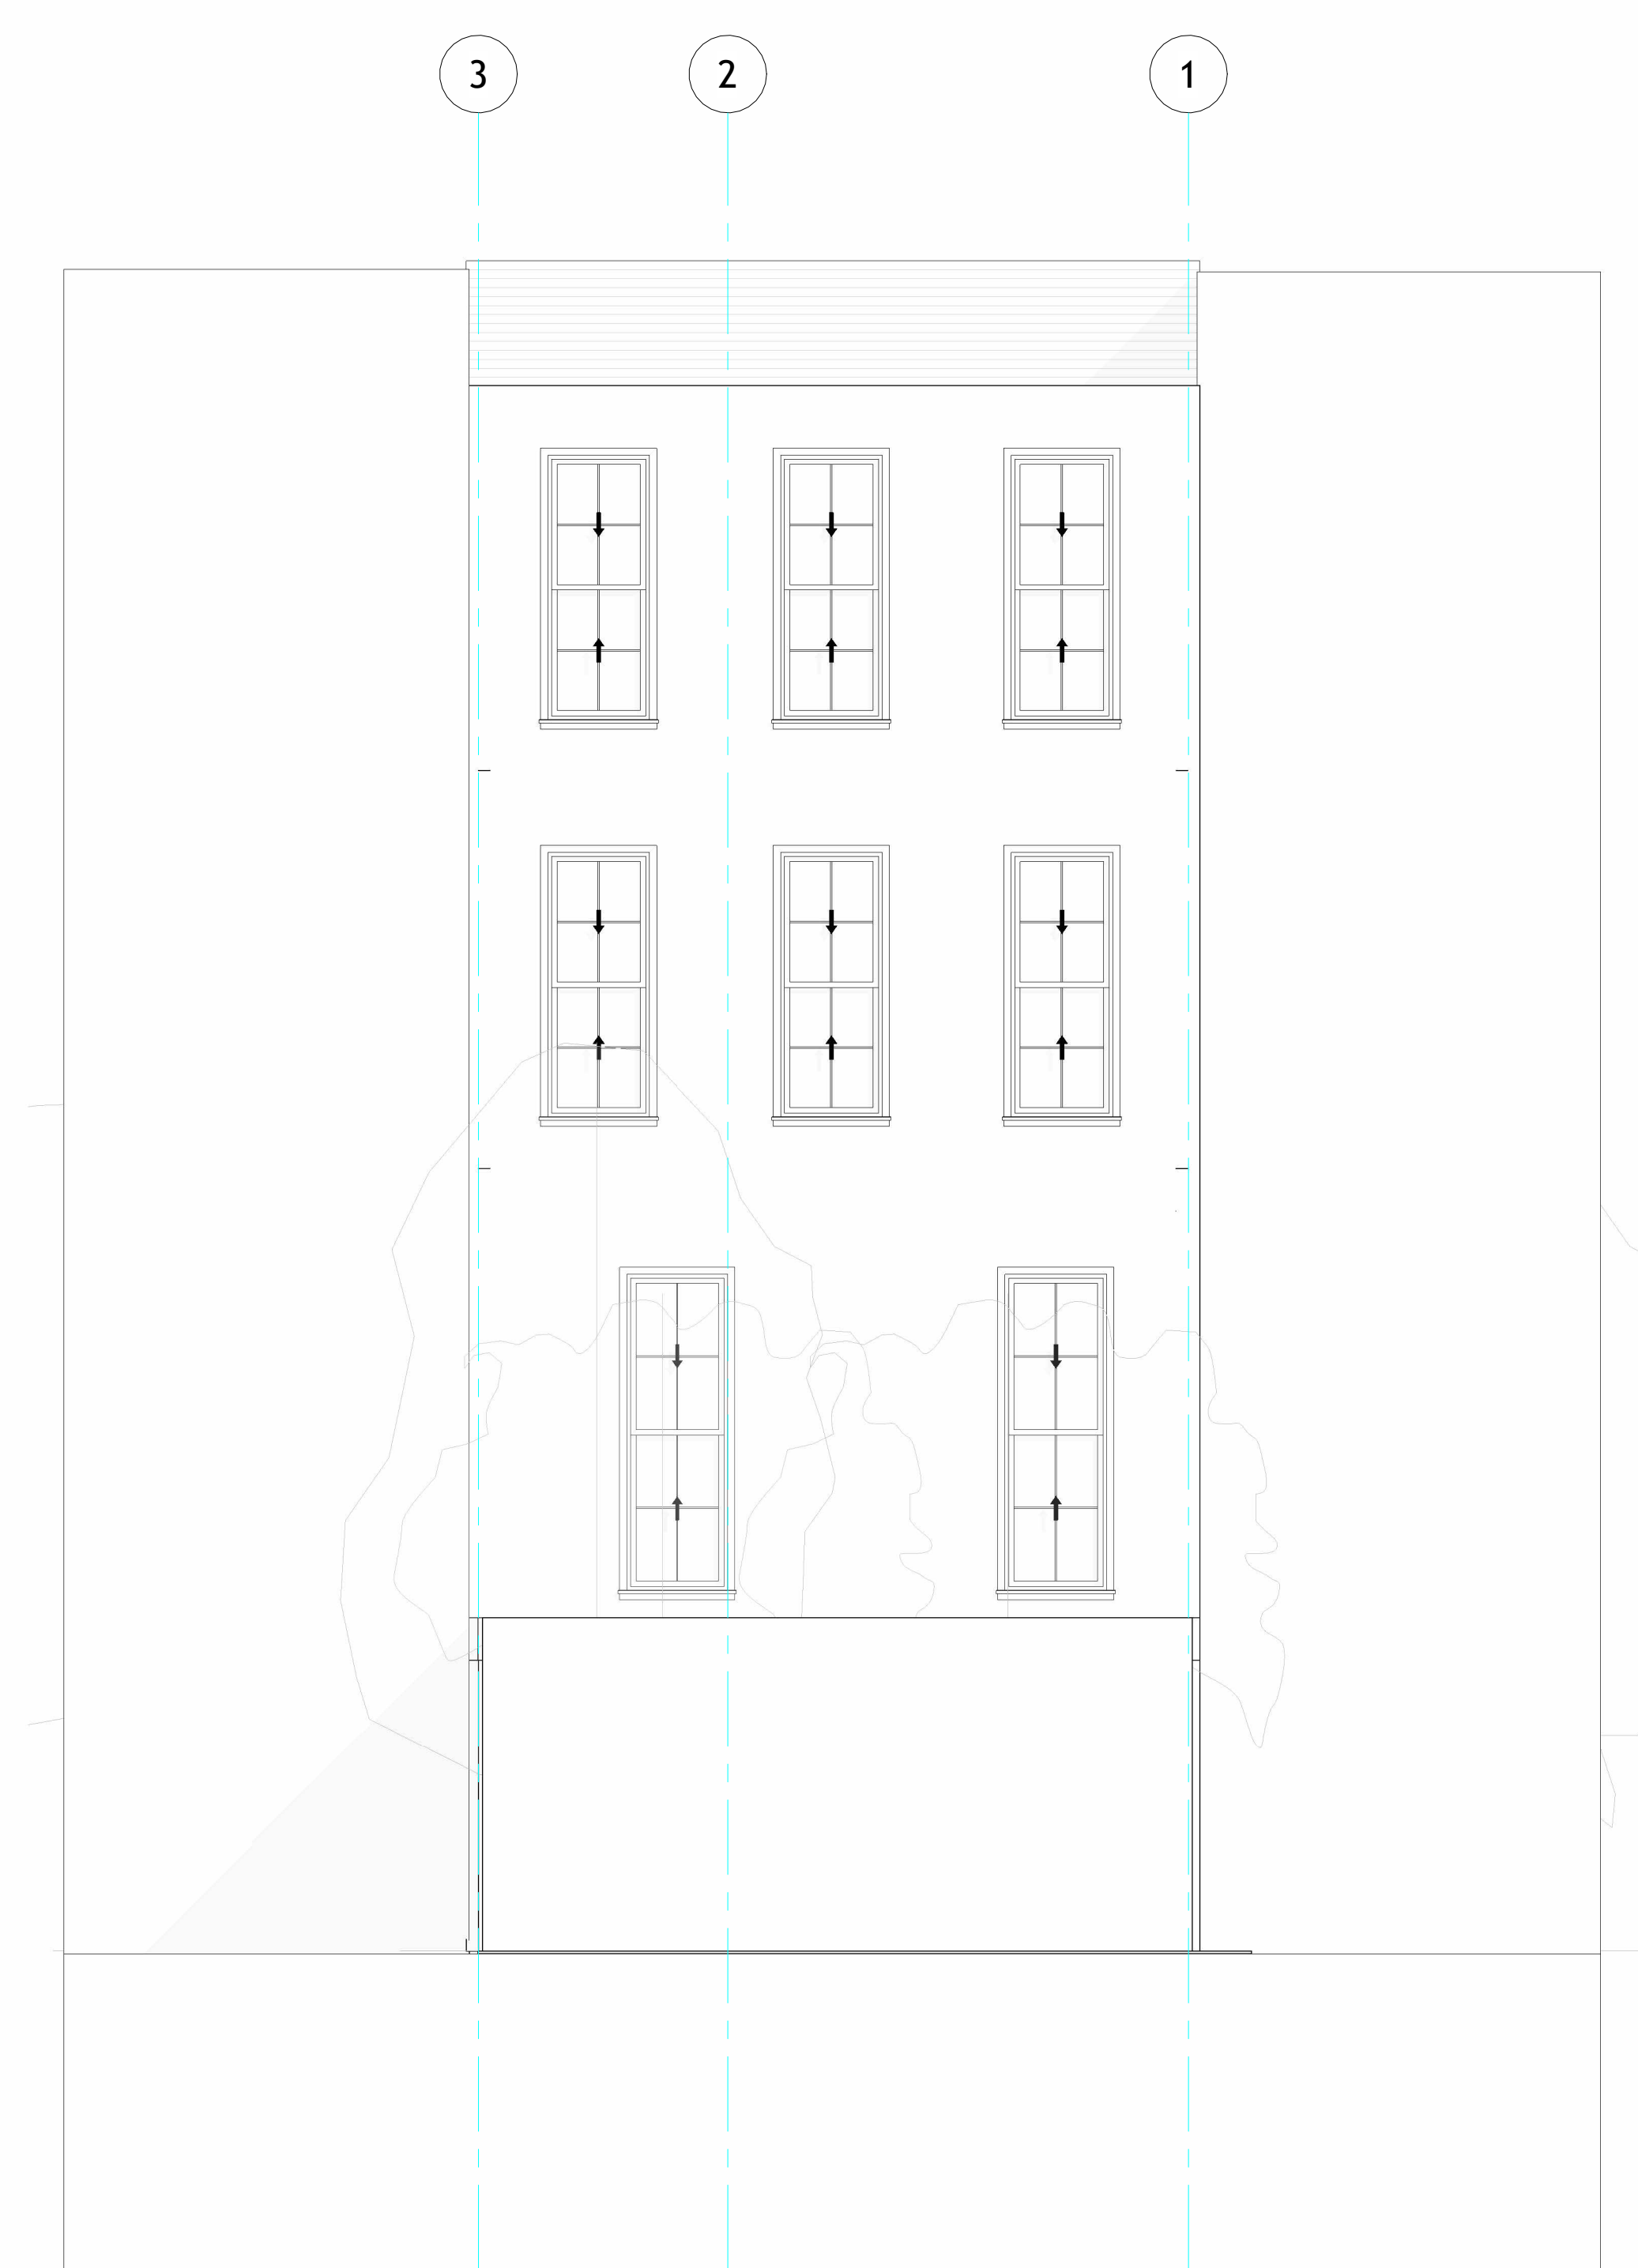

② East Architectural Building
Elevation
1:50




TECHSCAN
Surveying As Builds and Geospatial Solutions

365 Greene Ave, Brooklyn	
Architectural Building Elevations	
Project number	001
Date	Issue Date
Checked by	Checker
A201	
Scale	1 : 50



18 Spencer St, Brooklyn,
NY 11205
info@TechScanusa.com
TechScanusa.com
(929) 486 9091

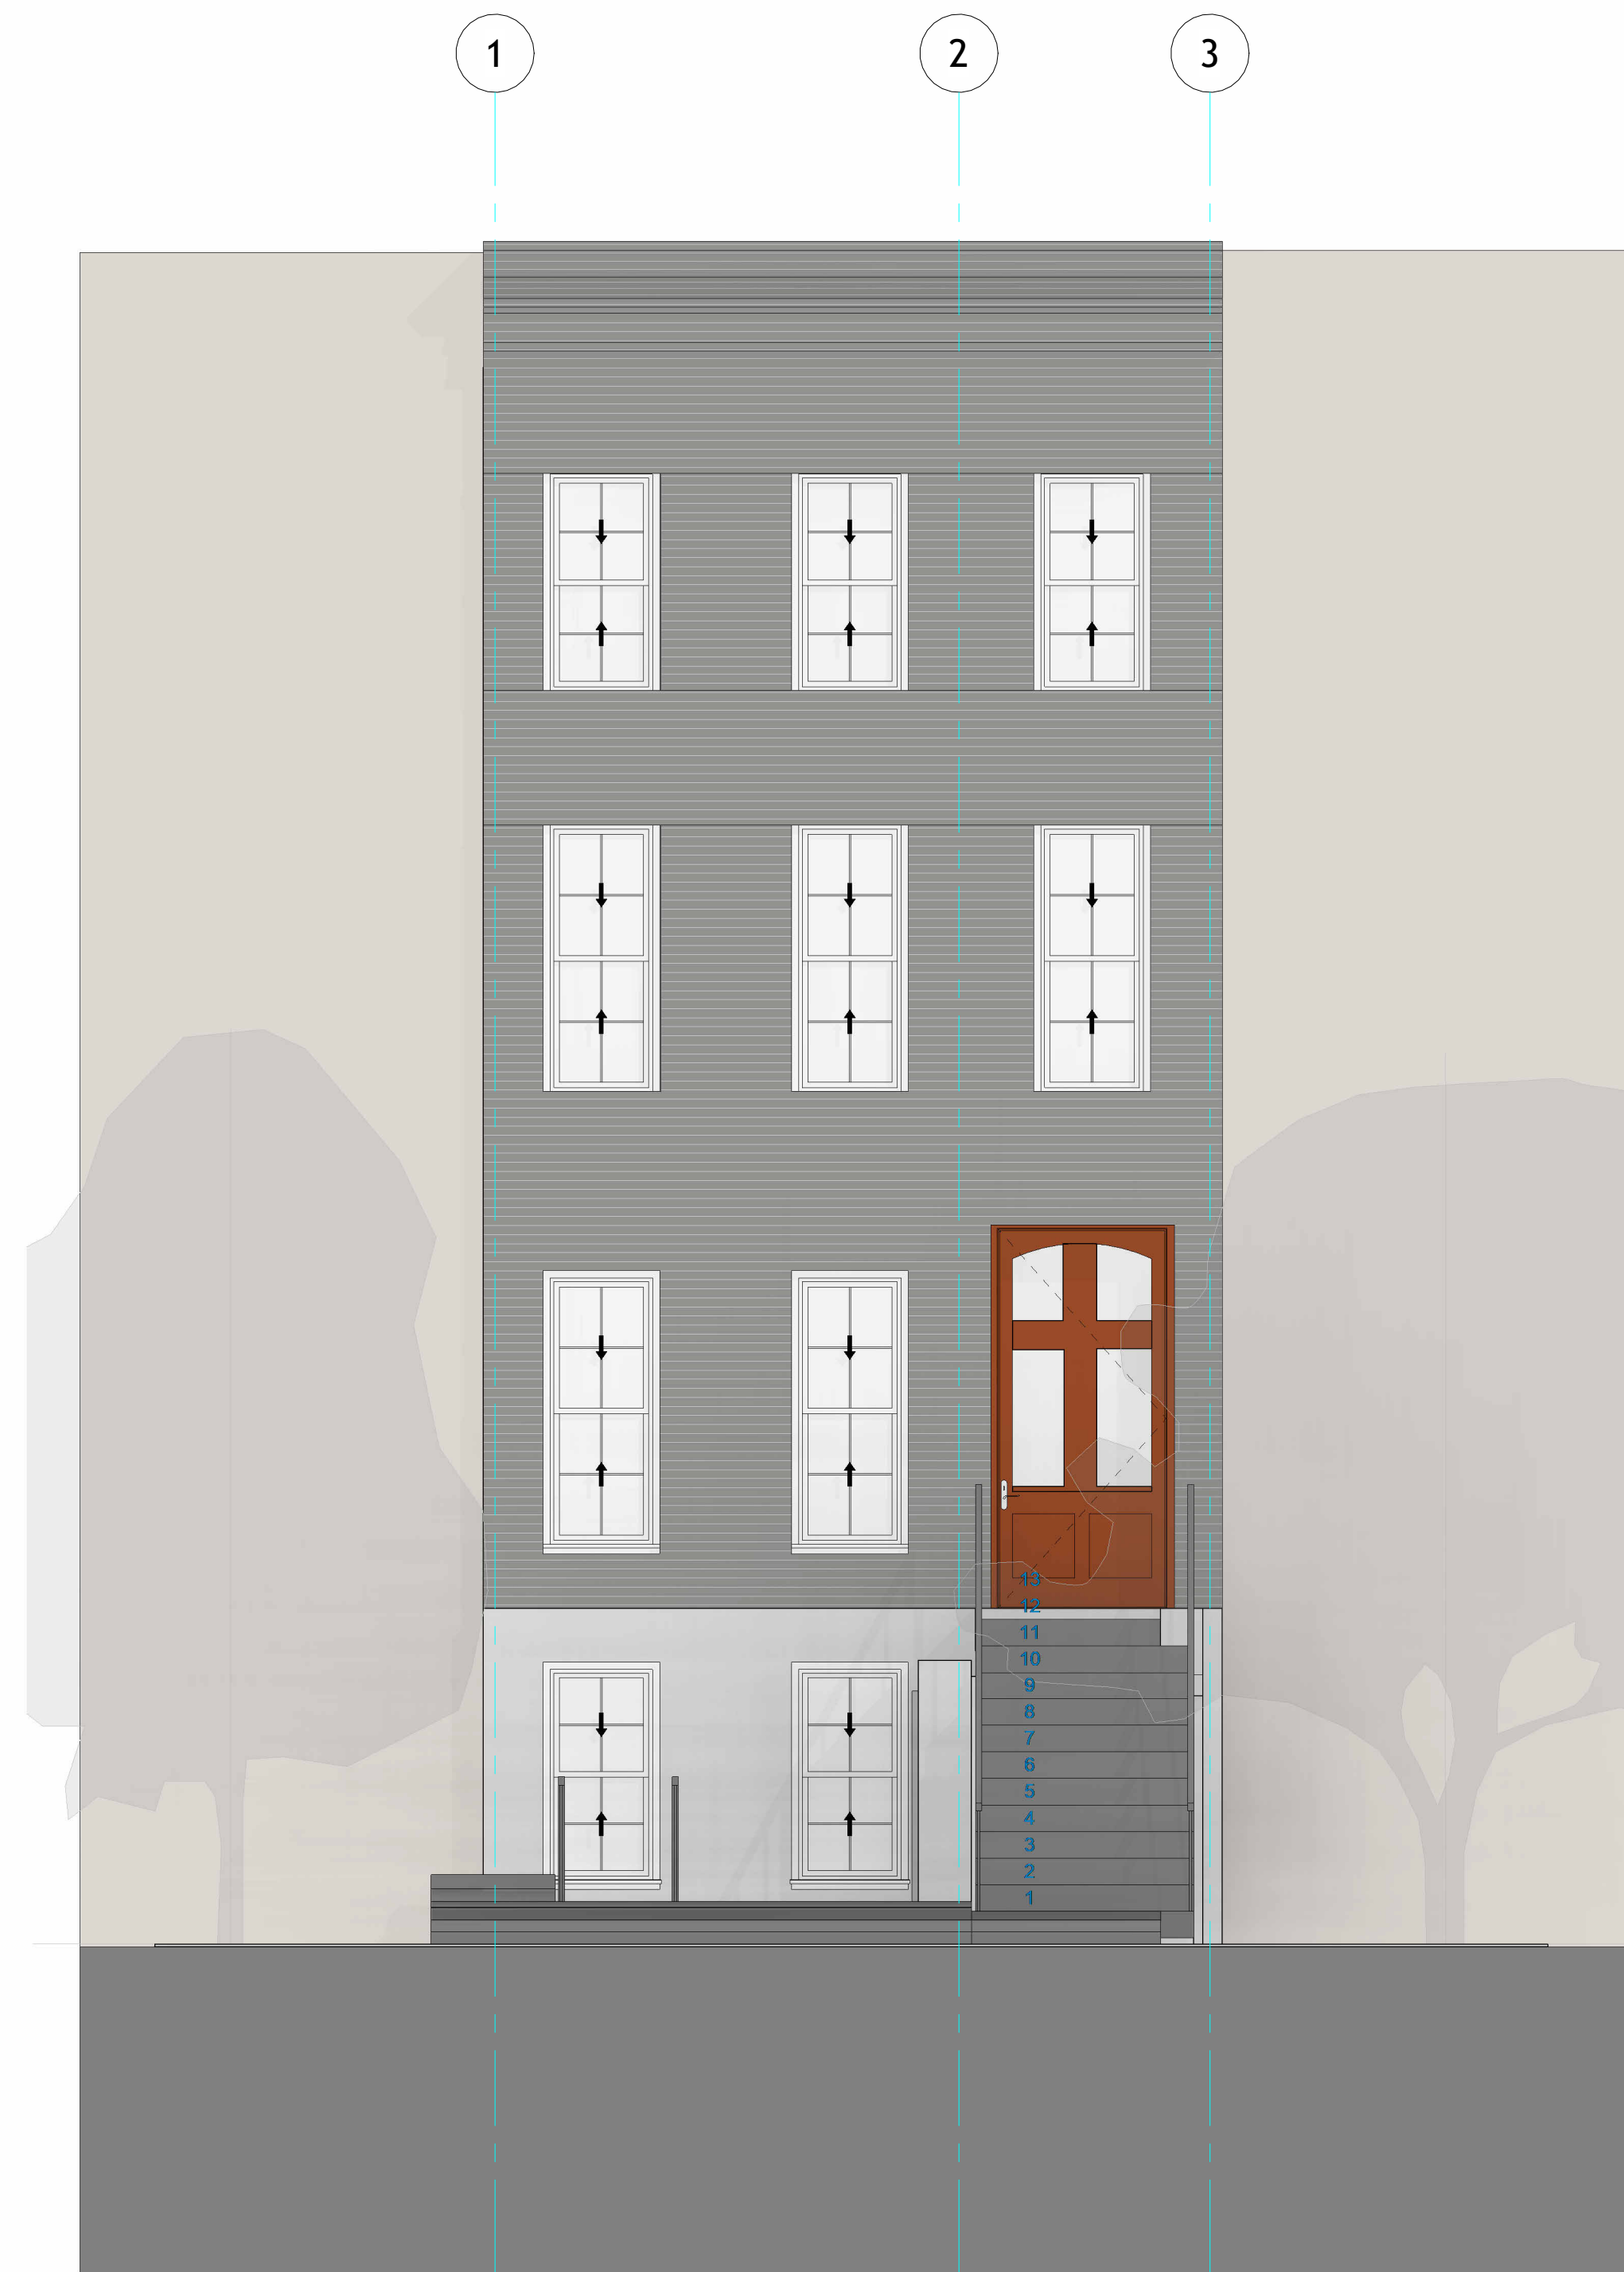

1 West Architectural Building
Elevation
1 : 50



2 West Architectural Building
Elevation
1 : 50



TECHSCAN
Surveying As Builds and Geospatial Solutions

365 Greene Ave, Brooklyn

Architectural Building
Elevations

Project number 001

Date Issue Date

Checked by Checker

A202

Scale 1 : 50



18 Spencer St, Brooklyn,
NY 11205
info@TechScanusa.com
TechScanusa.com
(929) 486 9091



1 Section 2
1 : 50



2 Section 4
1 : 50



TECHSCAN
Surveying As Builds and Geospatial Solutions

365 Greene Ave, Brooklyn

Architectural Building
Elevations

Project number 001

Date Issue Date

Checked by Checker

A204

Scale 1 : 50



18 Spencer St, Brooklyn,
NY 11205

info@TechScanusa.com

TechScanusa.com

(929) 486 9091



TECHSCAN
Surveying As Builds and Geospatial Solutions



1 Section 3
1 : 50

365 Greene Ave, Brooklyn

Architectural Building Sections

Project number 001

Date Issue Date

Checked by Checker

A301

Scale 1 : 50



18 Spencer St, Brooklyn,
NY 11205
info@TechScanusa.com
TechScanusa.com
(929) 486 9091



TECHSCAN
Surveying As Builds and Geospatial Solutions

365 Greene Ave, Brooklyn

Architectural Building
Sections

Project number 001

Date Issue Date

Checked by Checker

A302

Scale 1 : 50



18 Spencer St, Brooklyn,
NY 11205
info@TechScanusa.com
TechScanusa.com
(929) 486 9091



1 Section 5
1 : 50



2 Section 6
1 : 50



TECHSCAN
Surveying As Builds and Geospatial Solutions




1 Section 7
1 : 50

365 Greene Ave, Brooklyn	
Architectural Building Sections	
Project number	001
Date	Issue Date
Checked by	Checker
A303	
Scale	1 : 50



18 Spencer St, Brooklyn,
NY 11205
info@TechScanusa.com
TechScanusa.com
(929) 486 9091

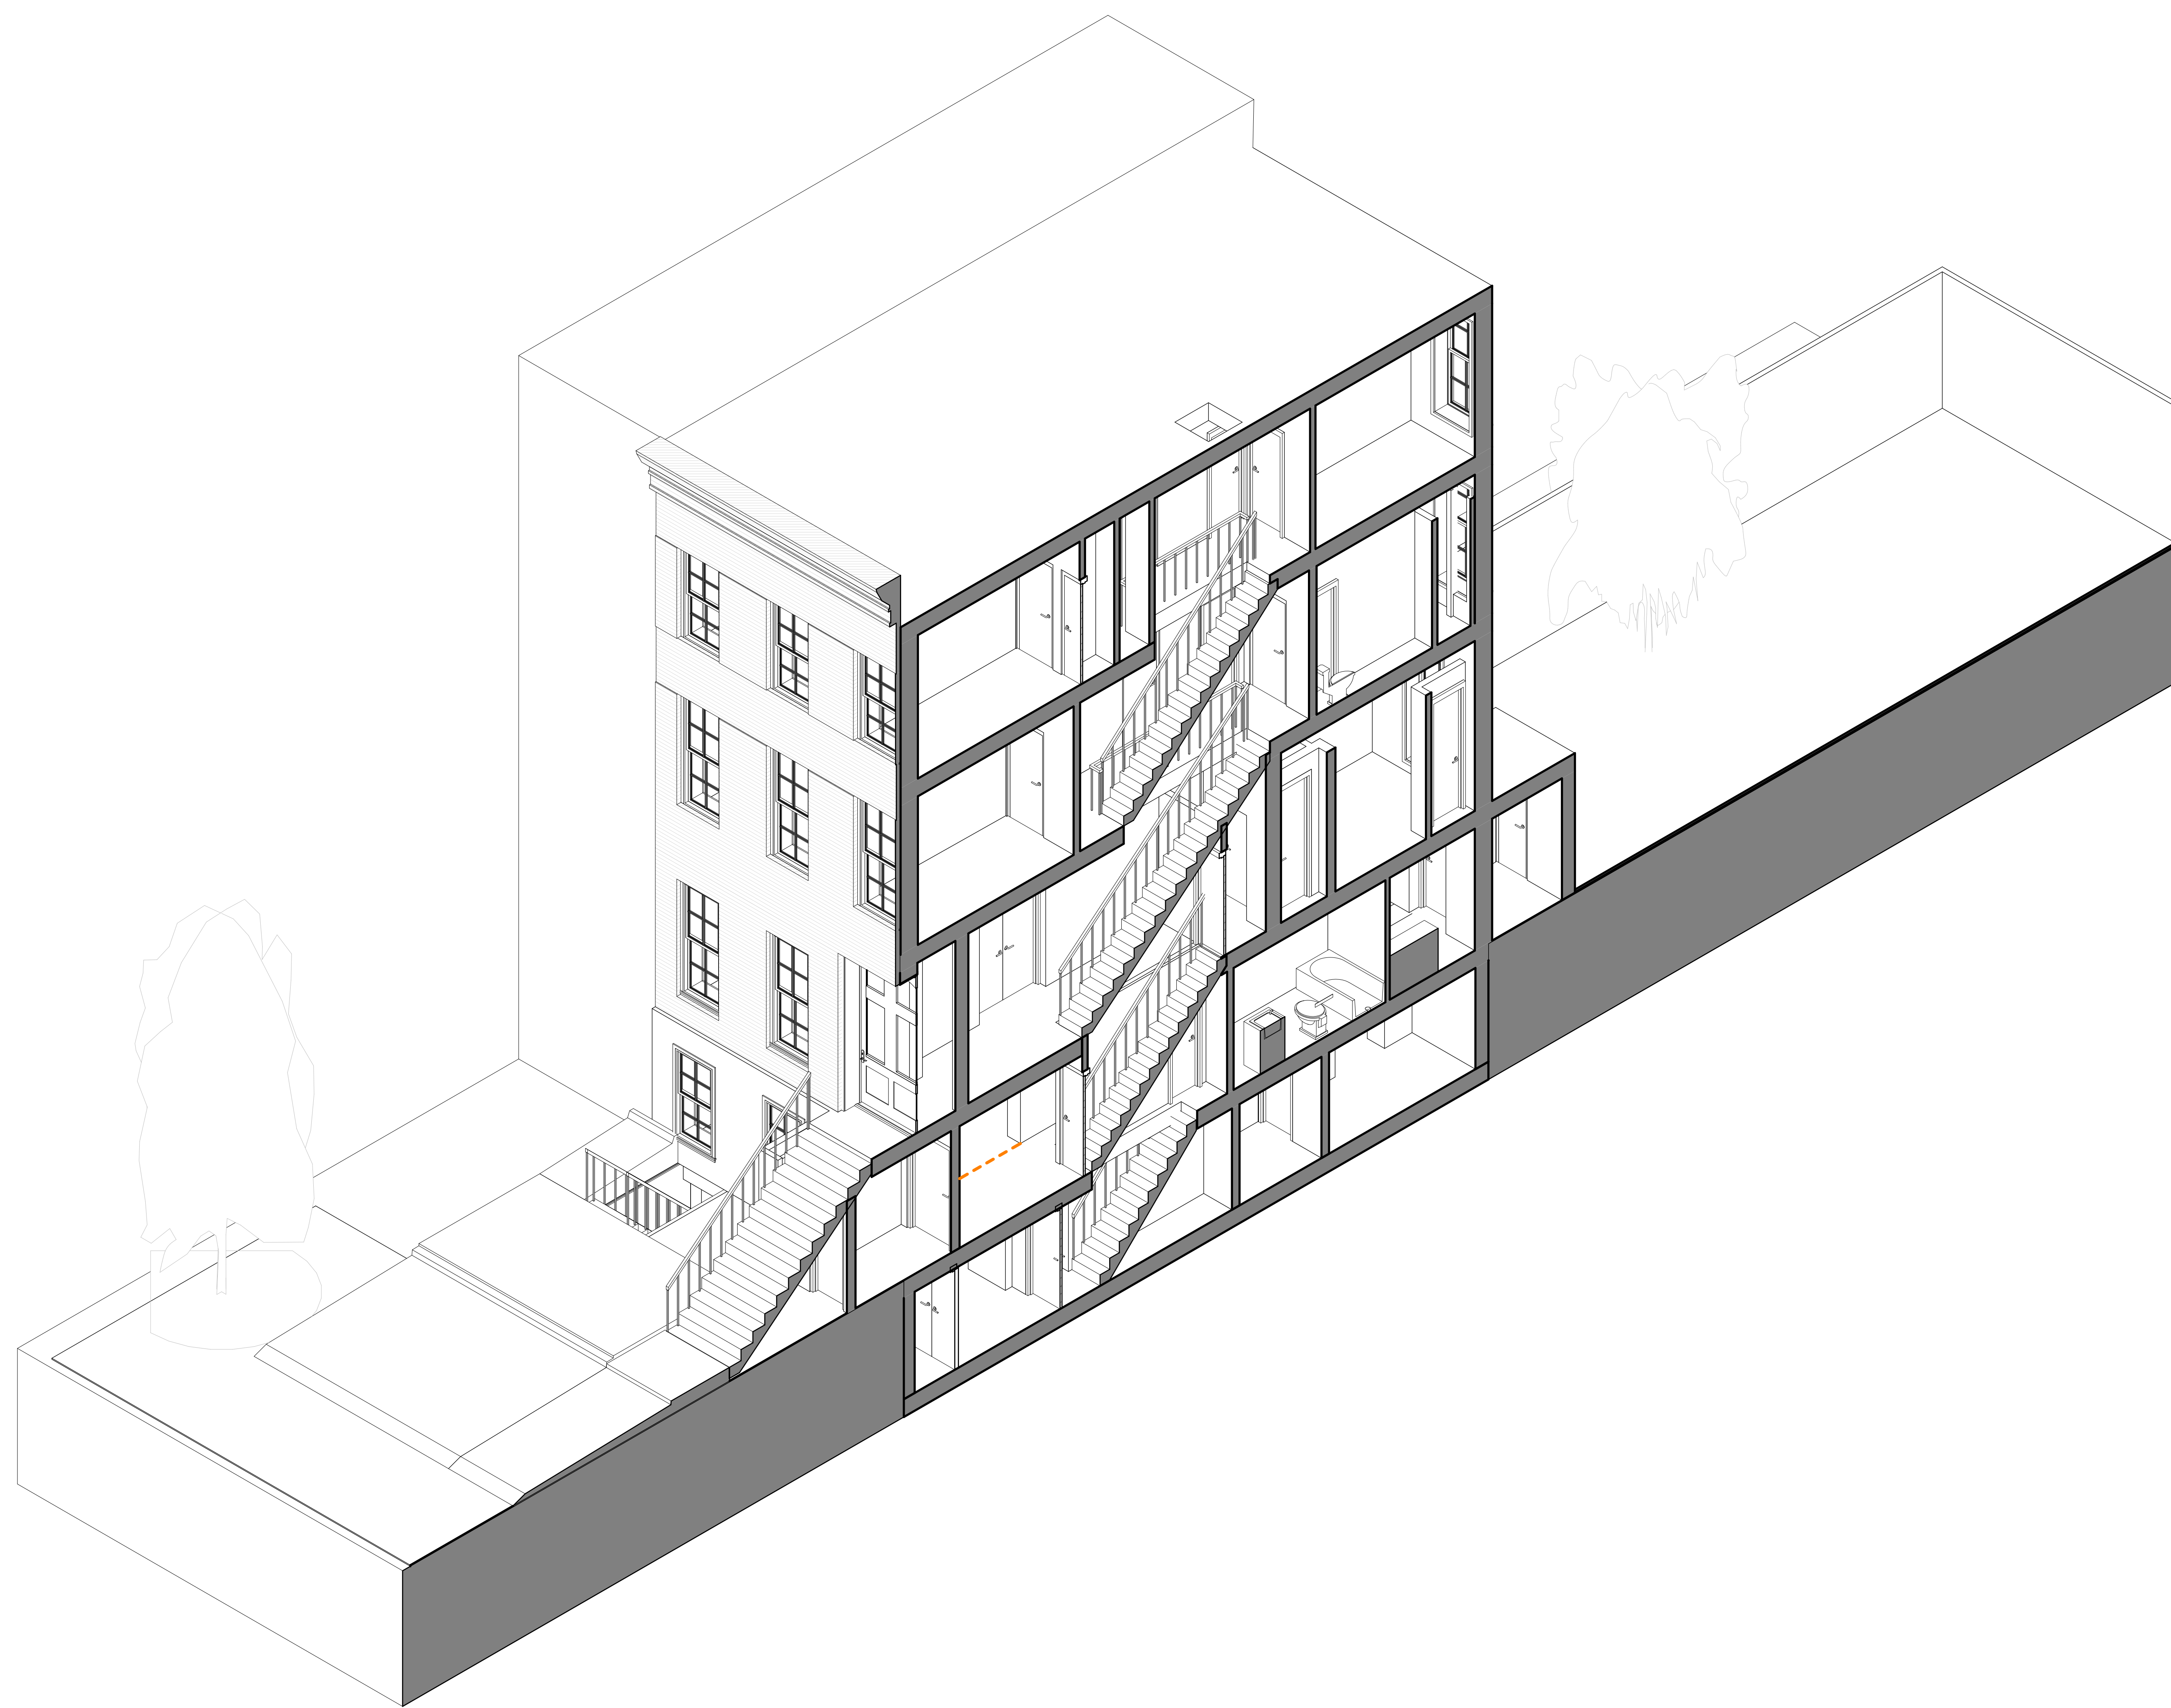

1 3DDH



TECHSCAN
 Surveying As Builds and Geospatial Solutions

365 Greene Ave, Brooklyn	
Architectural Enlarged Views	
Project number	001
Date	Issue Date
Checked by	Checker
A401	
Scale	



18 Spencer St, Brooklyn,
 NY 11205
 info@TechScanusa.com
 TechScanusa.com
 (929) 486 9091



① 3DDH Copy 1



TECHSCAN
 Surveying As Builds and Geospatial Solutions

365 Greene Ave, Brooklyn

Architectural Enlarged Views

Project number 001

Date Issue Date

Checked by Checker

A402

Scale




18 Spencer St, Brooklyn,
 NY 11205


info@TechScanusa.com

TechScanusa.com

(929) 486 9091

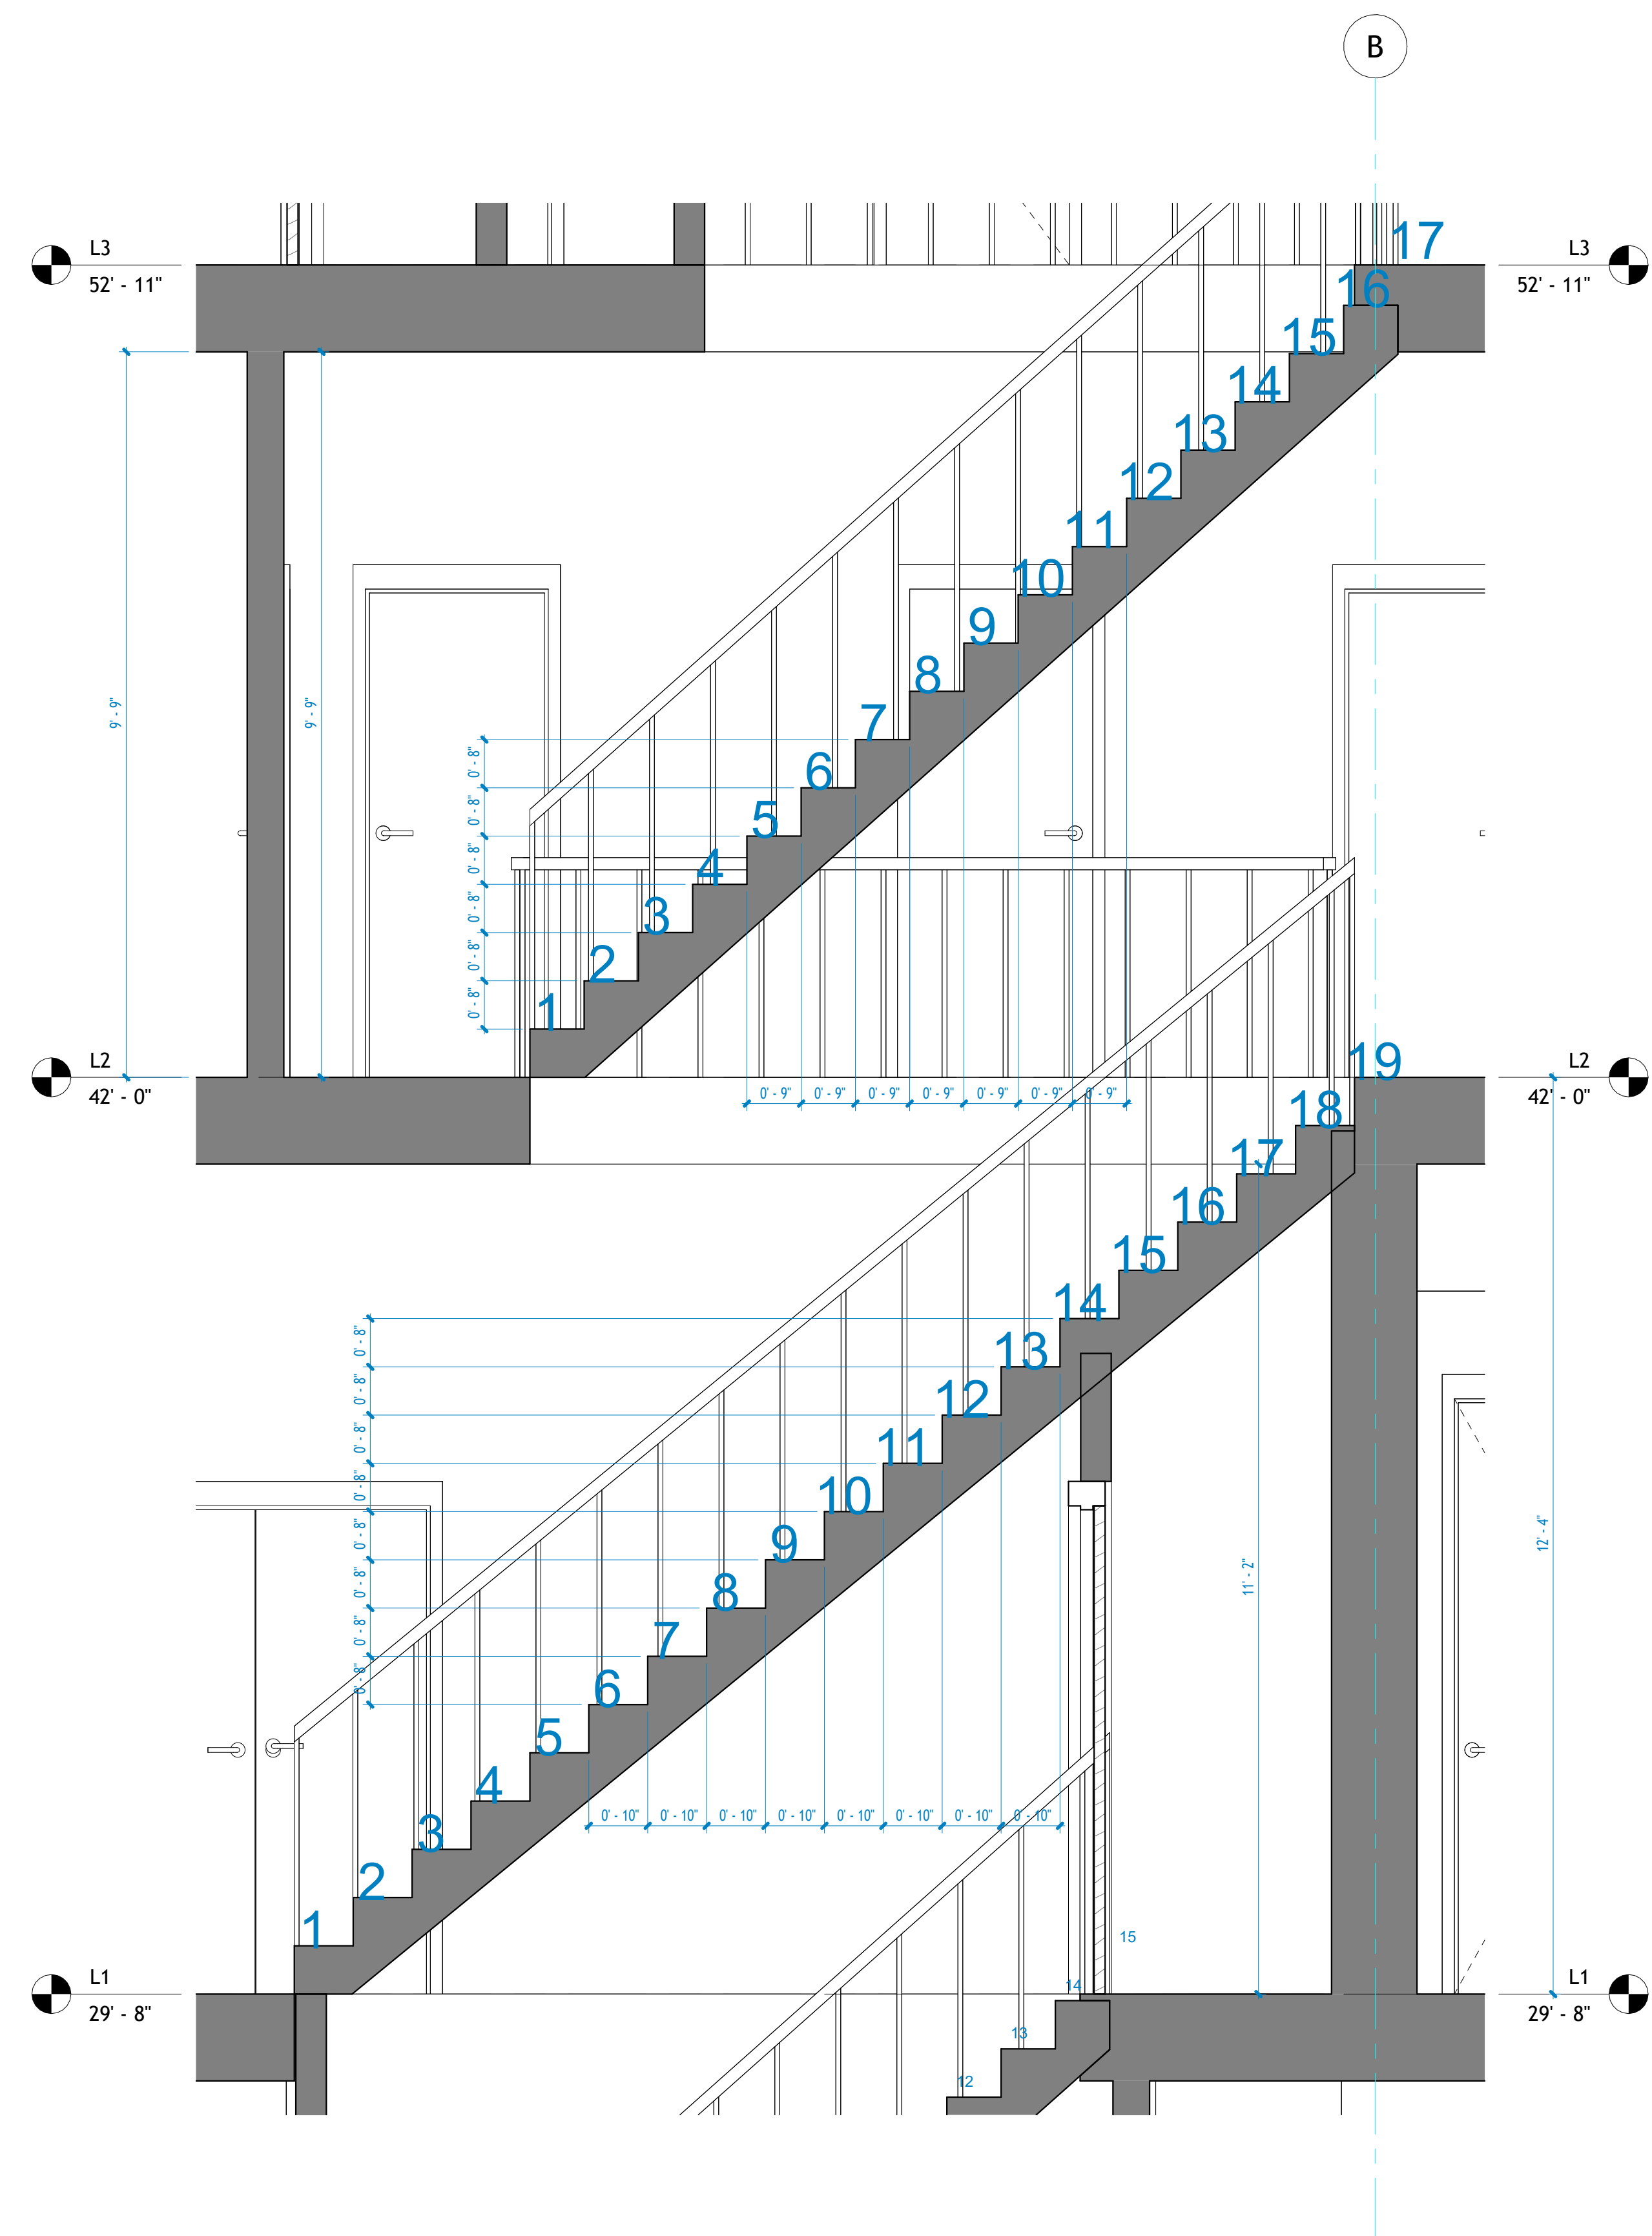

1 Section 1 ST
1 : 20

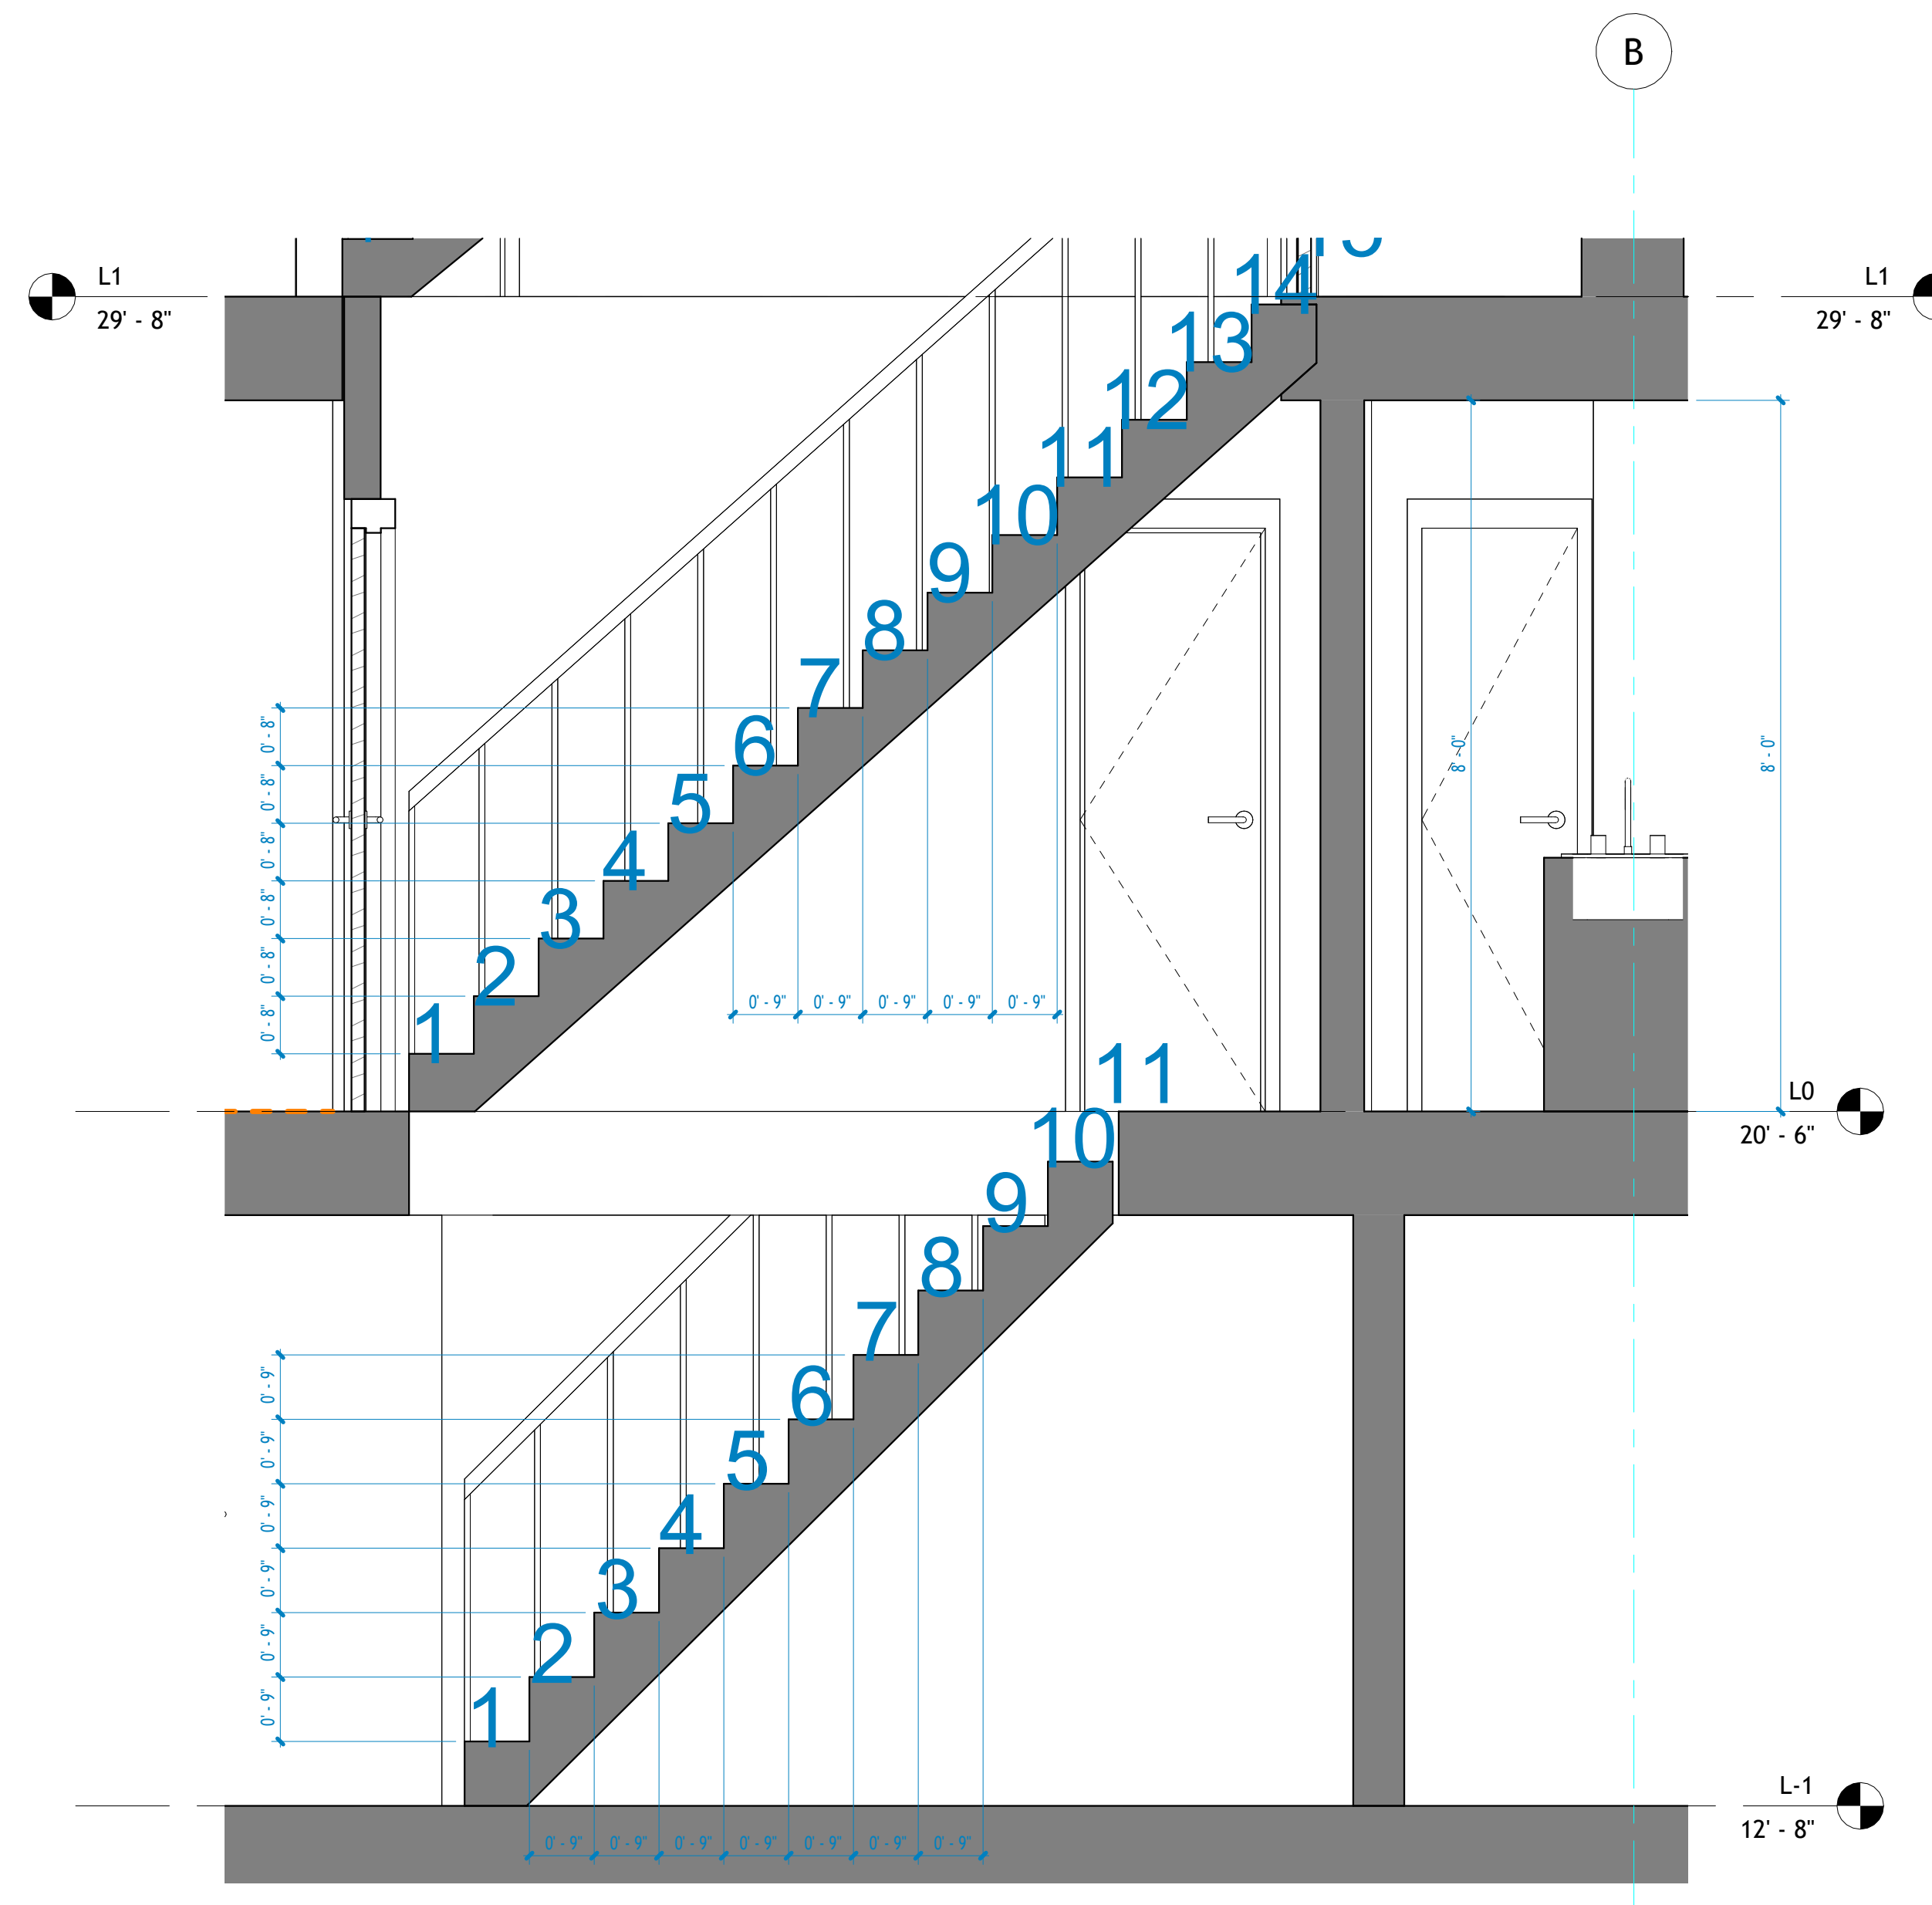

2 Section 1 ST2
1 : 20



TECHSCAN
Surveying As Builds and Geospatial Solutions

365 Greene Ave, Brooklyn

Architectural Details

Project number 001

Date Issue Date

Checked by Checker

A501


Scale 1 : 20




18 Spencer St, Brooklyn,
NY 11205
info@TechScanusa.com
TechScanusa.com
(929) 486 9091




TECHSCAN
Surveying As Builds and Geospatial Solutions

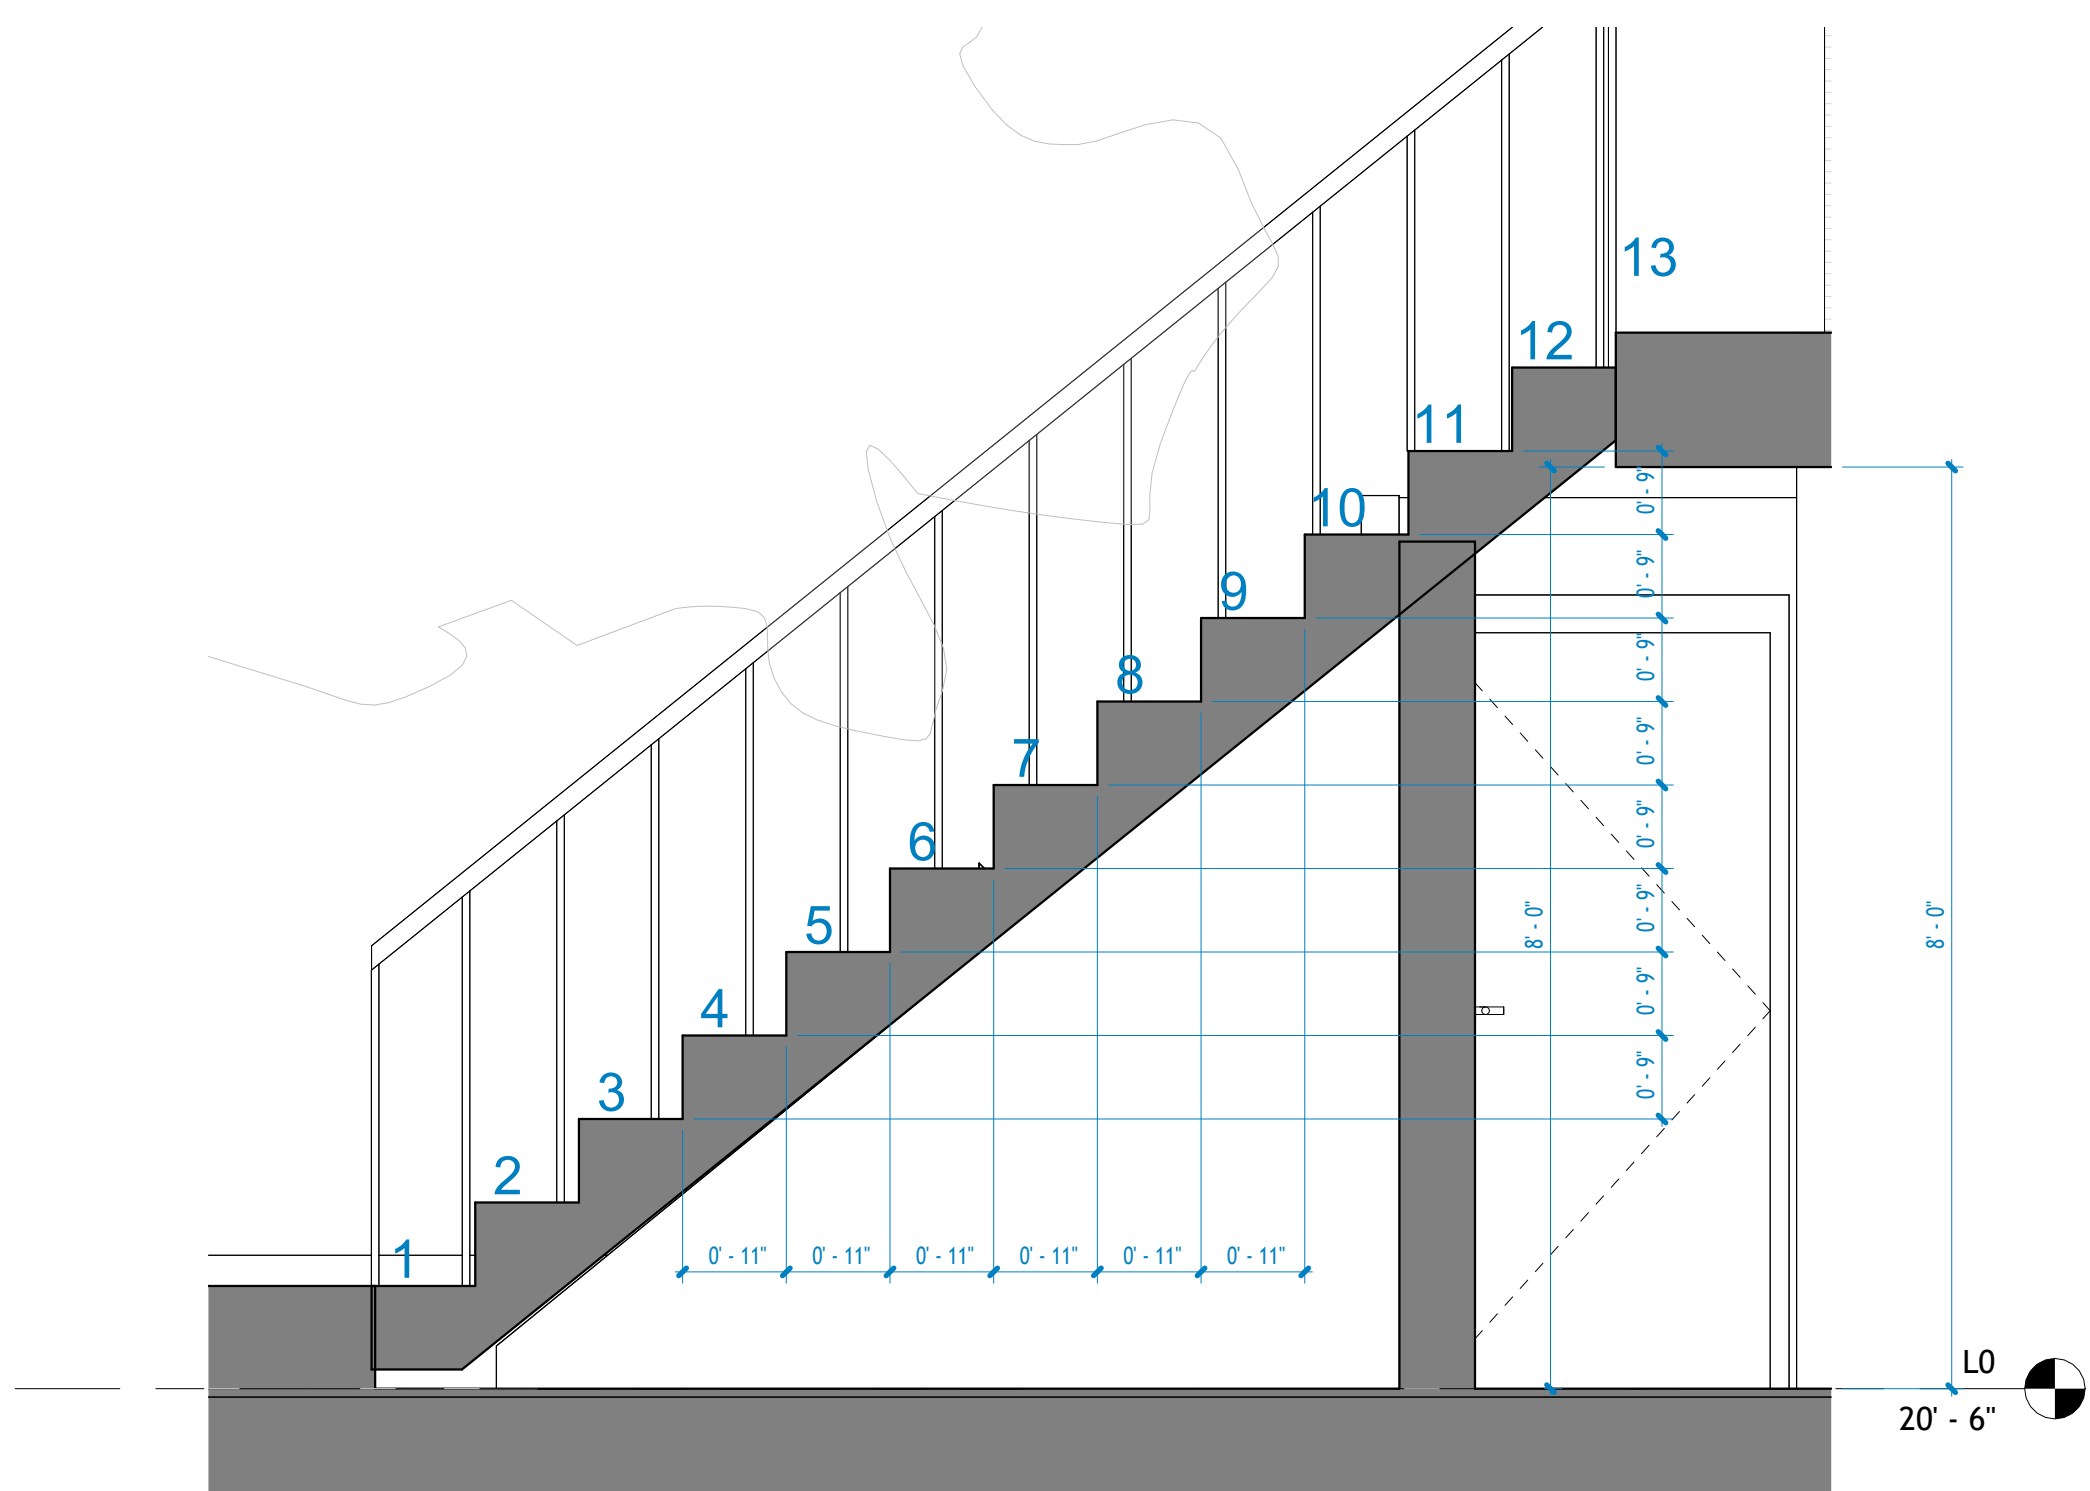

1 Section 1 ST3
1 : 20

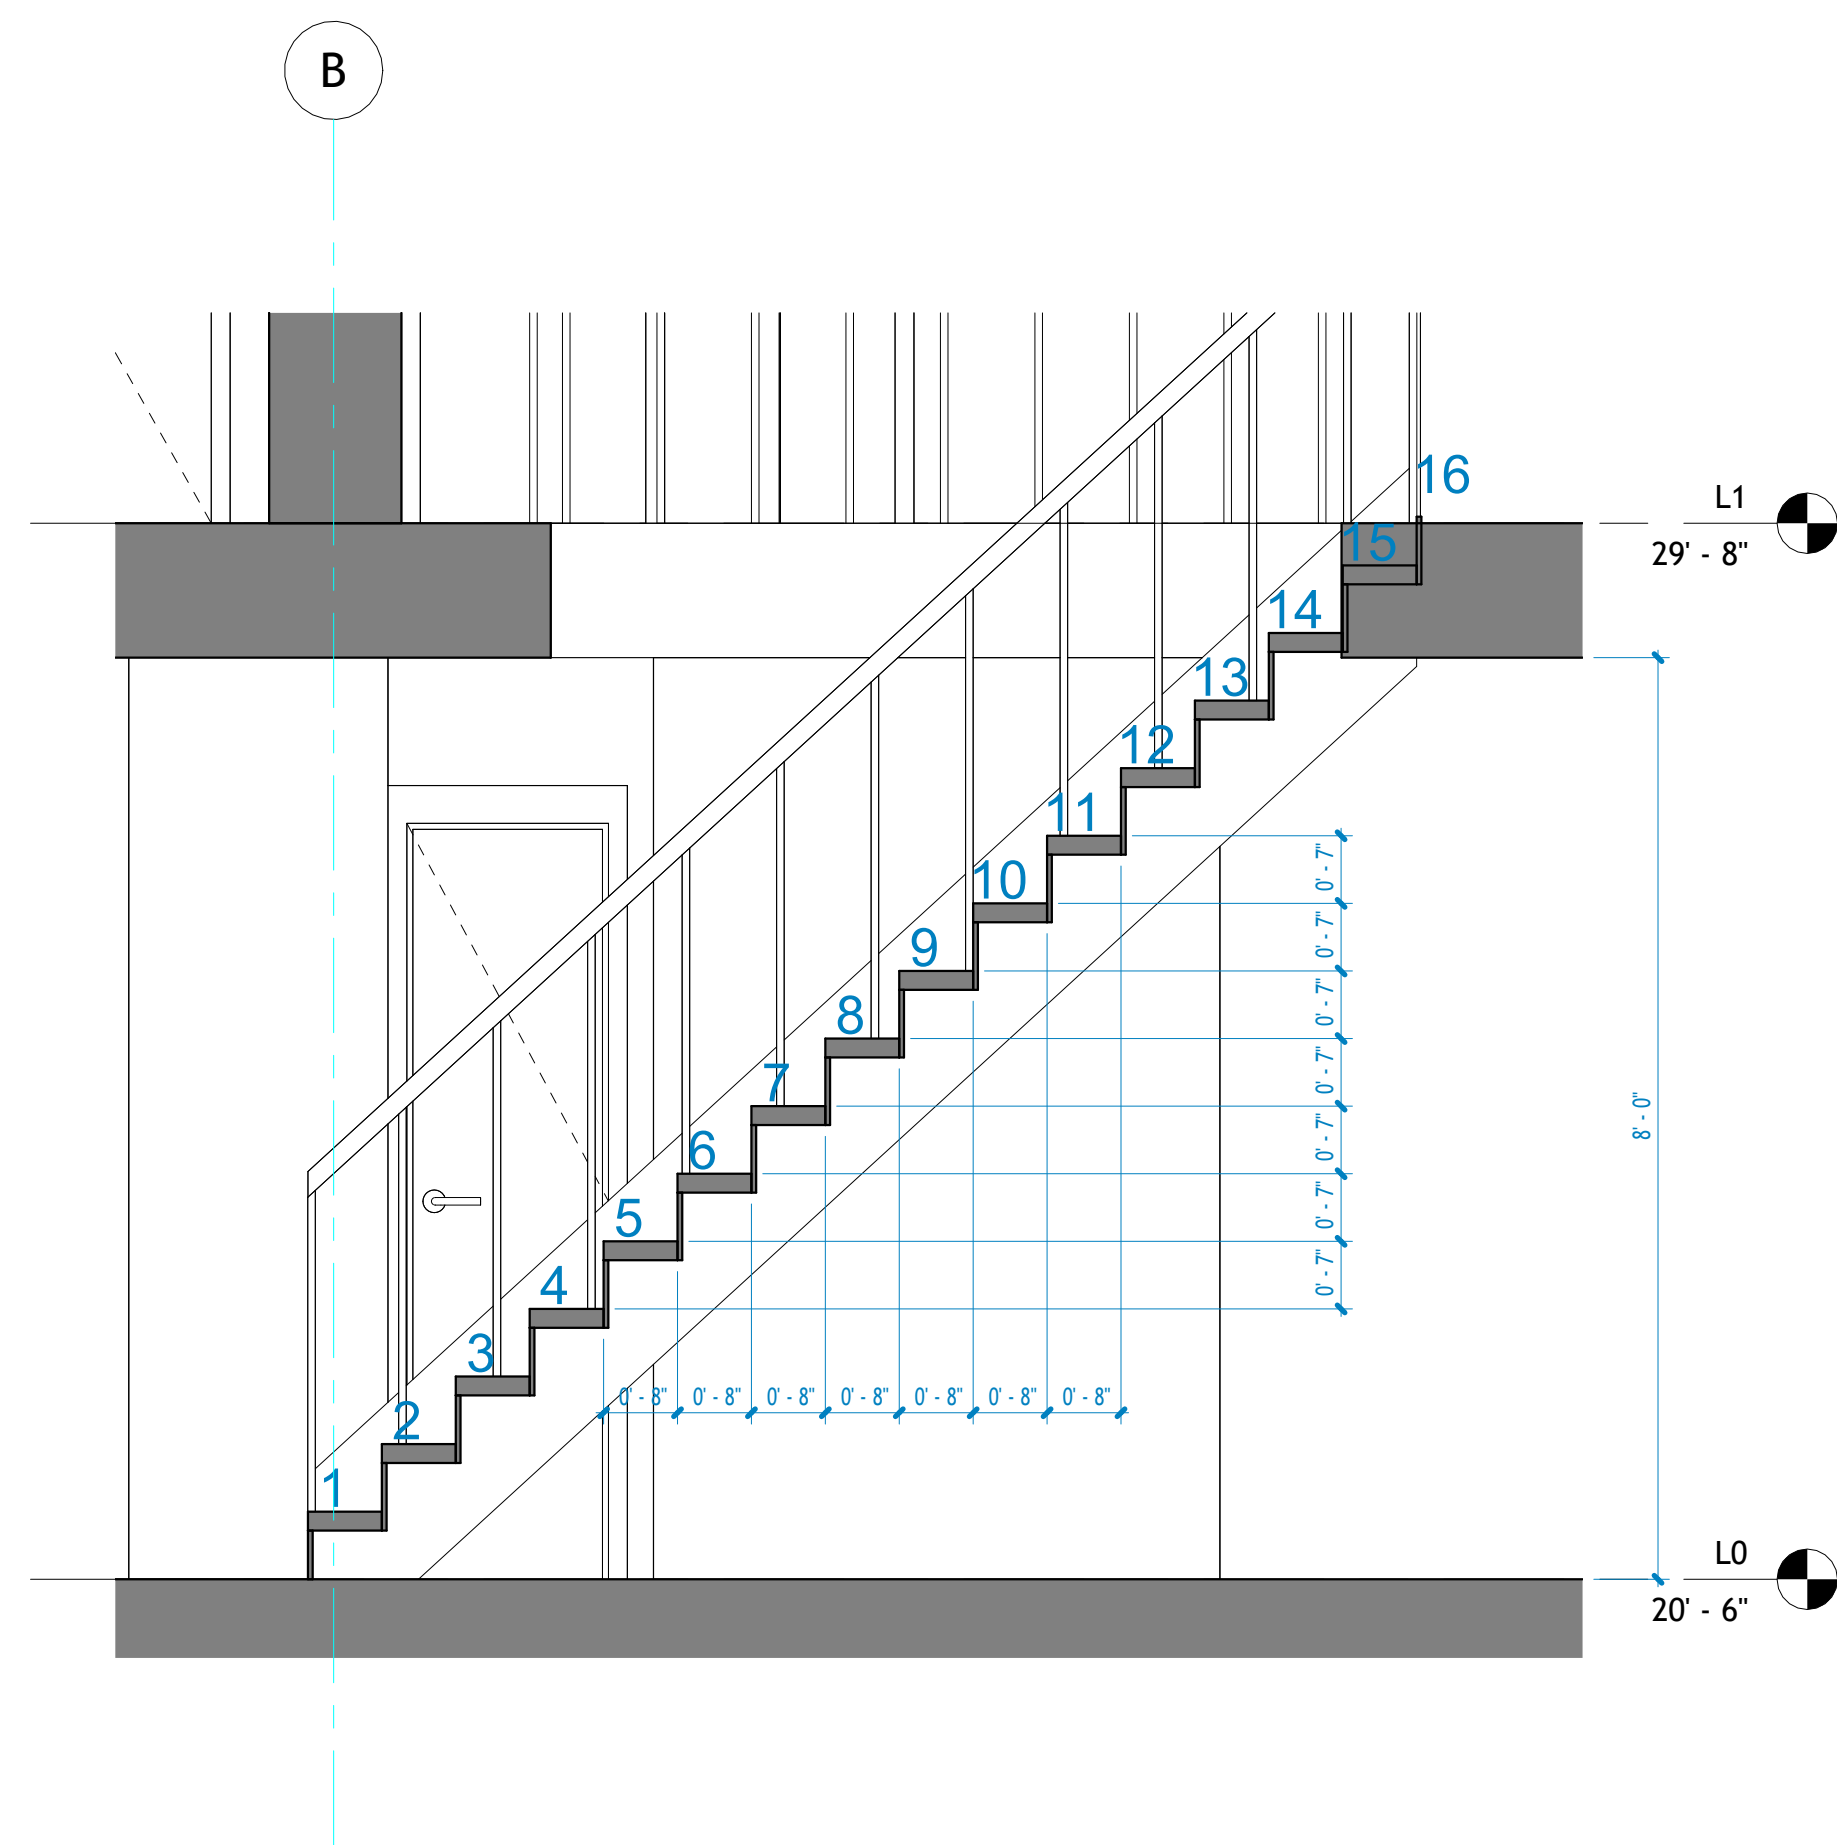

2 Section 3 ST
1 : 20

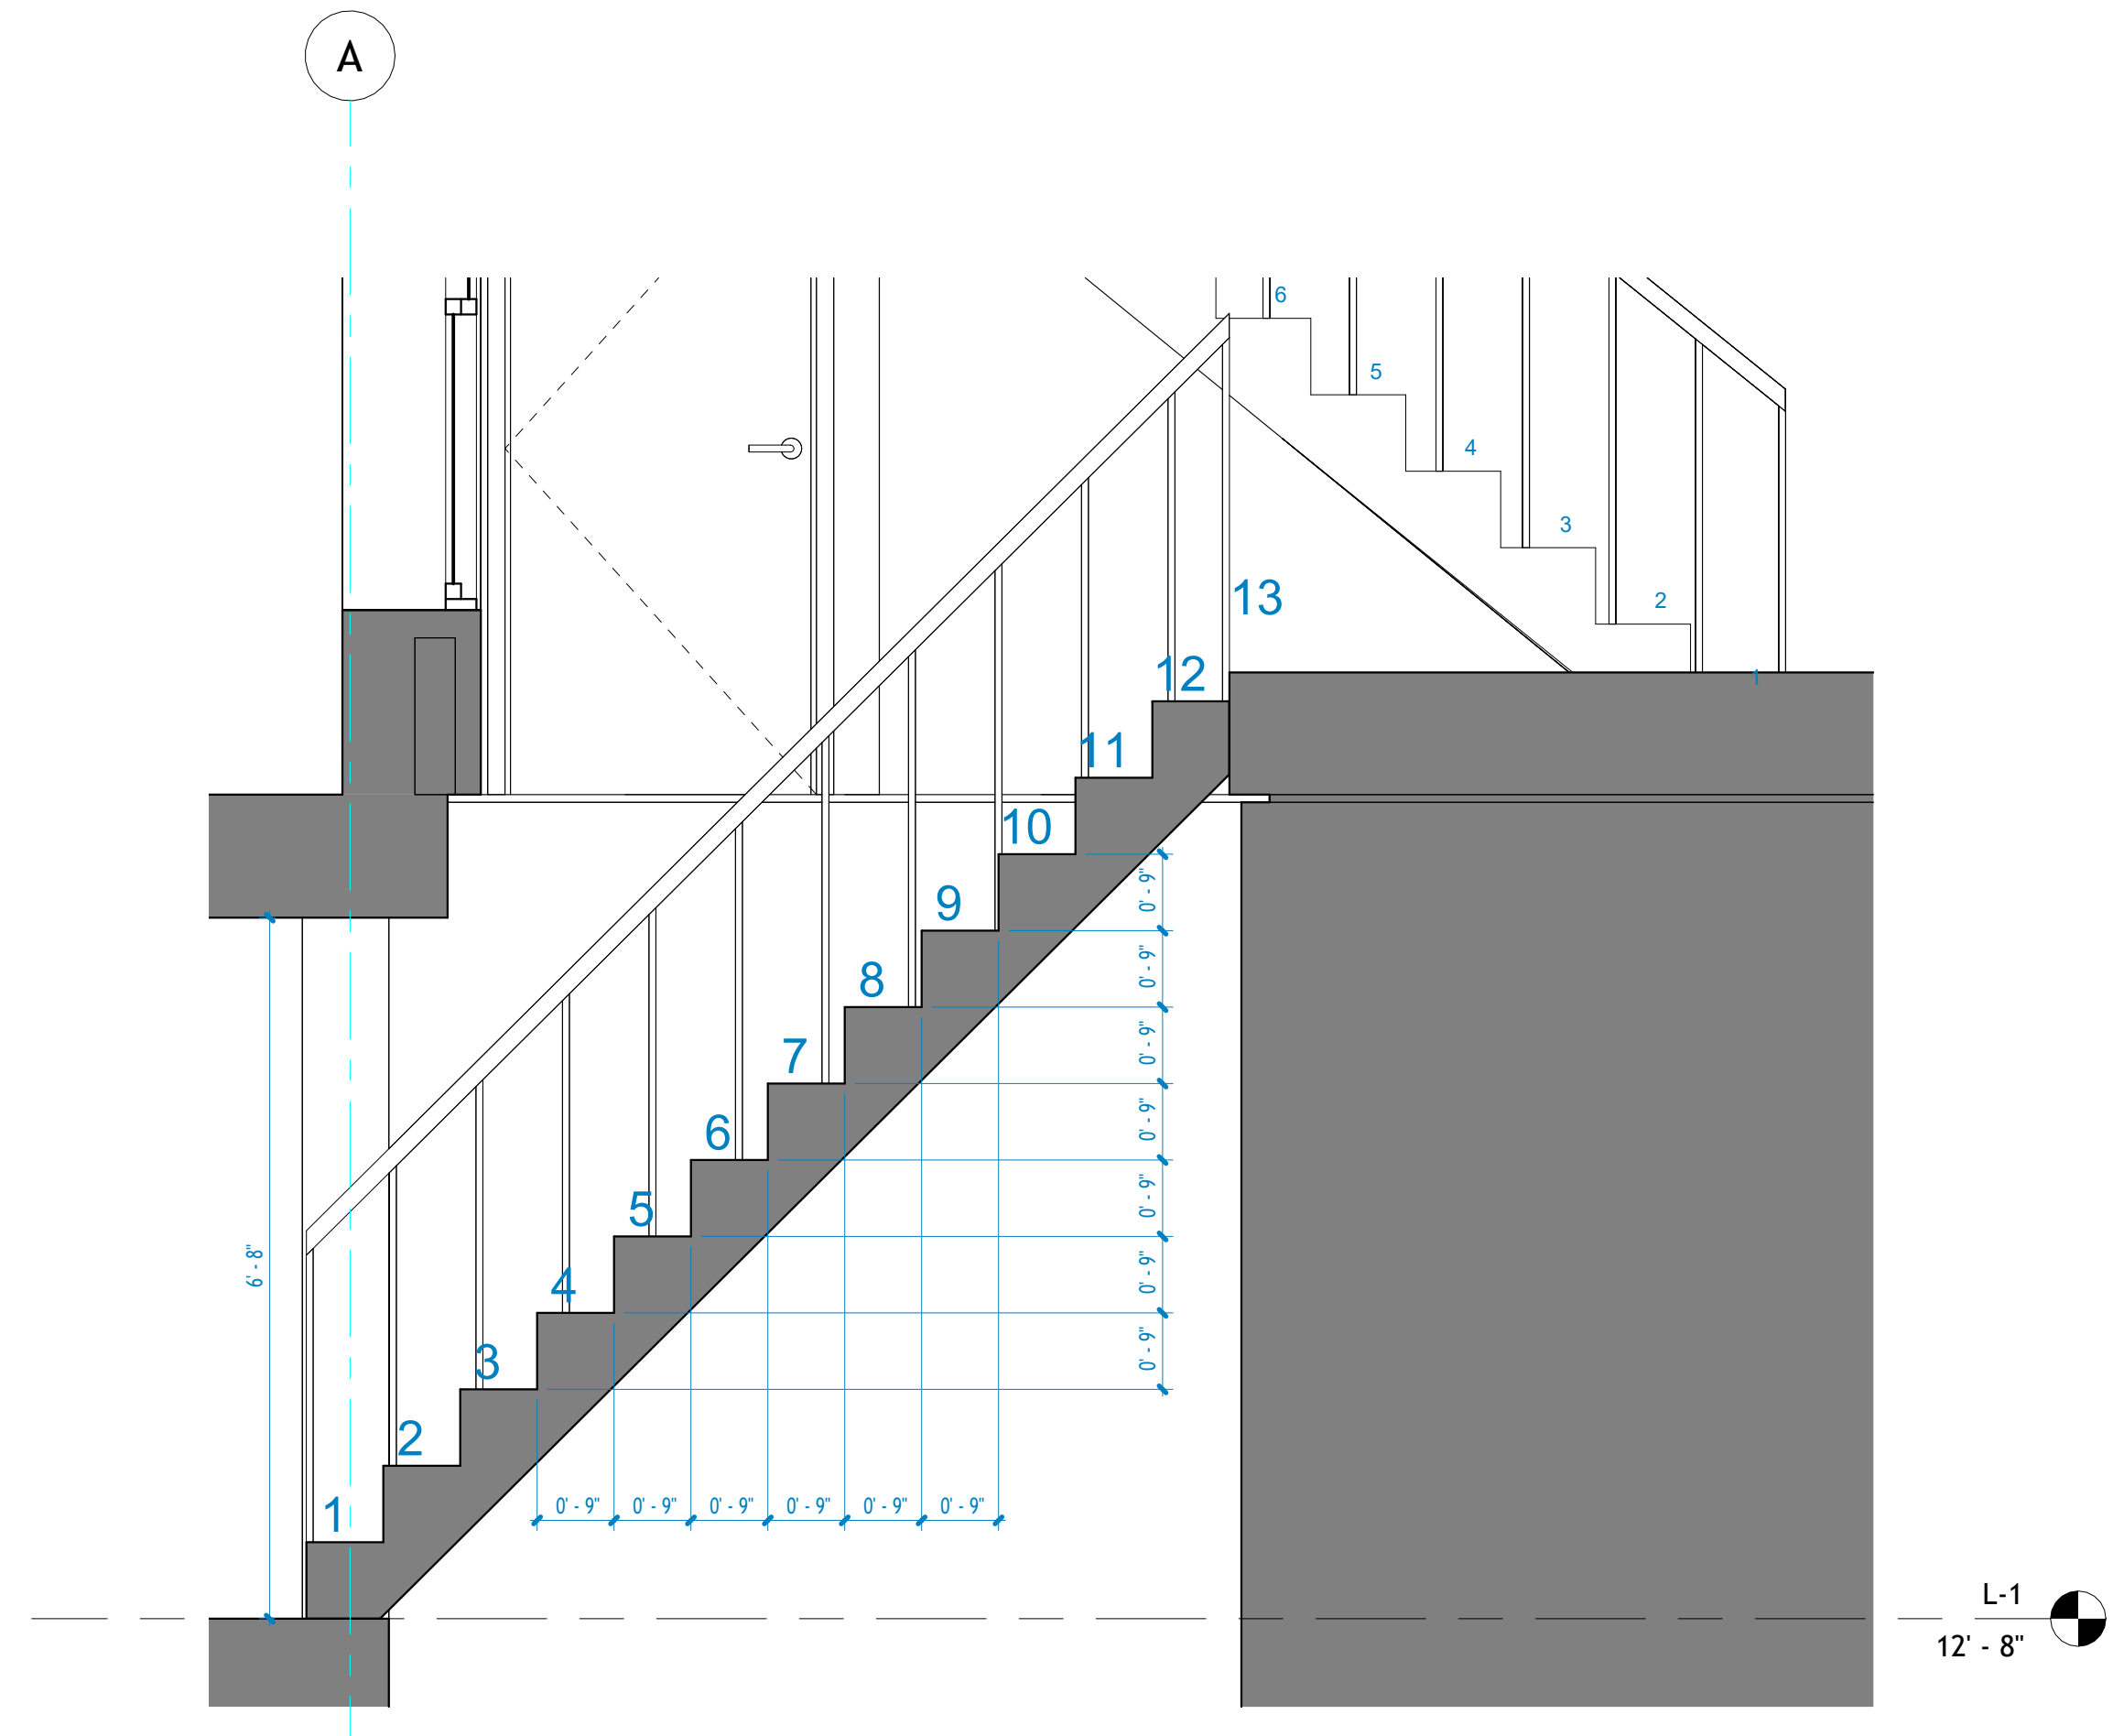

3 Section 3 ST 2
1 : 20

365 Greene Ave, Brooklyn

Architectural Details

Project number 001

Date Issue Date


Checked by Checker

A502

Scale 1 : 20



18 Spencer St, Brooklyn,
NY 11205
info@TechScanusa.com
TechScanusa.com
(929) 486 9091

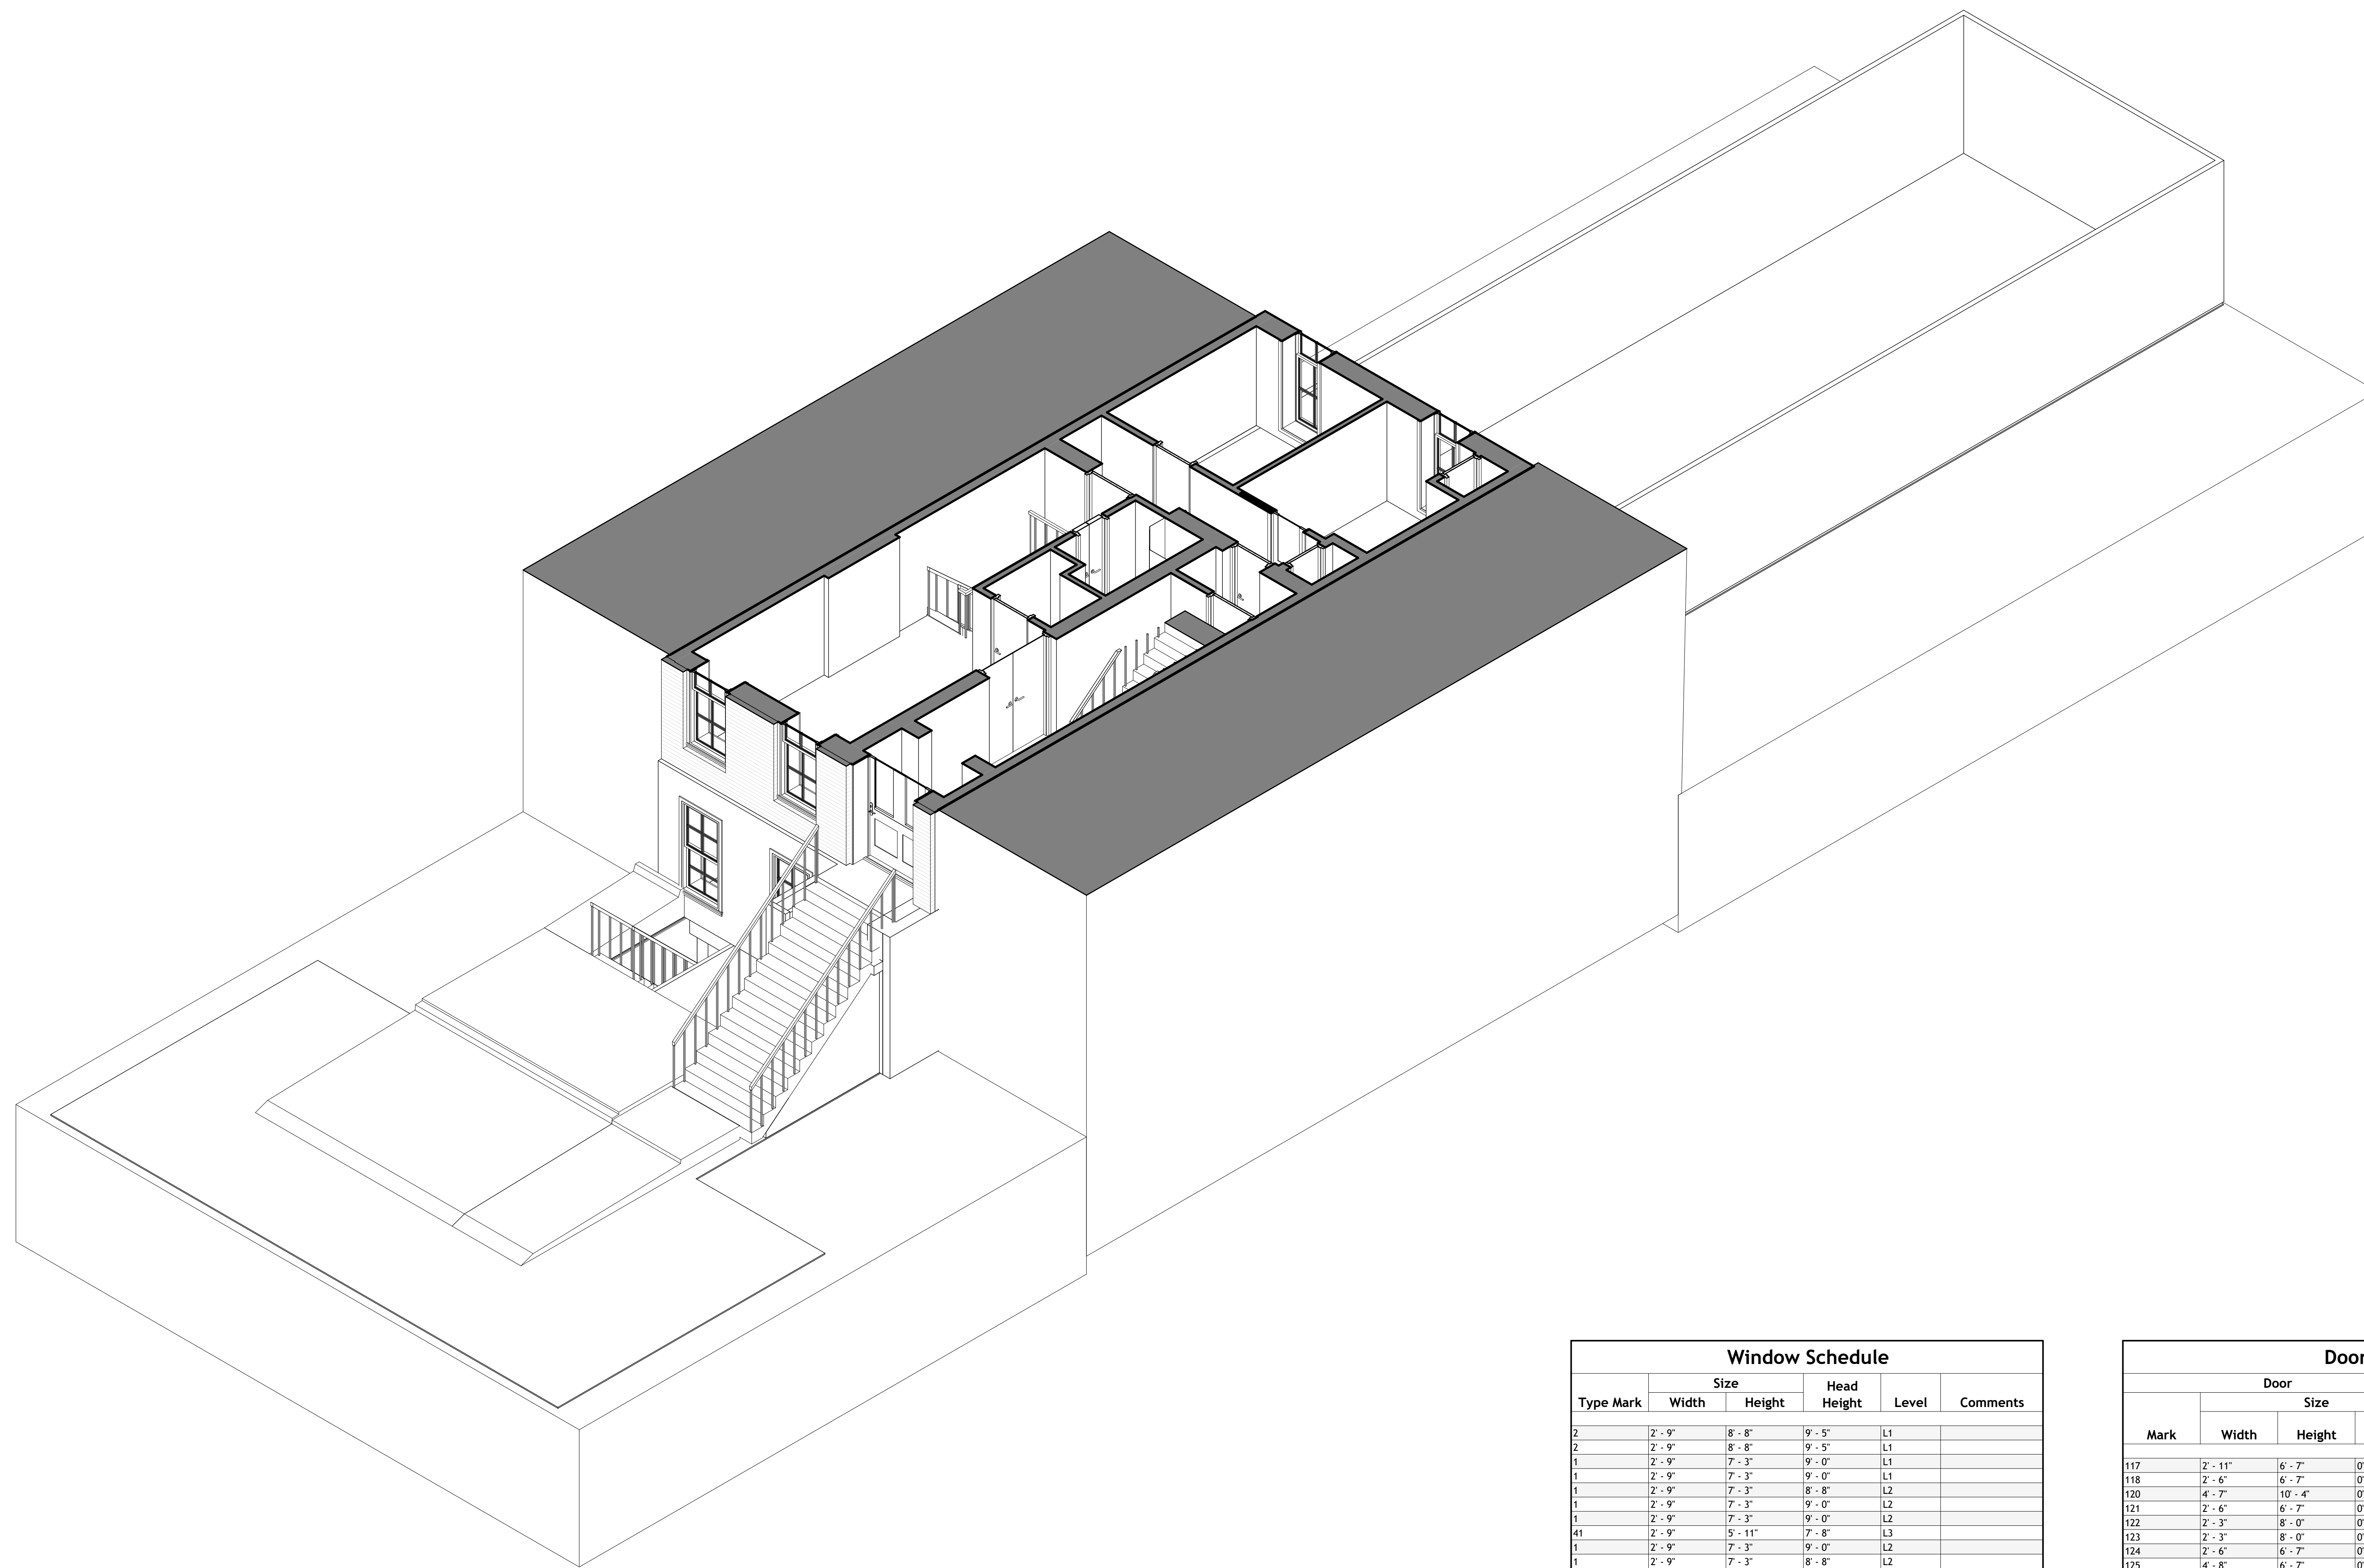

Window Schedule					
Type Mark	Size		Head Height	Level	Comments
	Width	Height			
2	2'-9"	8'-8"	9'-5"	L1	
2	2'-9"	8'-8"	9'-5"	L1	
1	2'-9"	7'-3"	9'-0"	L1	
1	2'-9"	7'-3"	9'-0"	L1	
1	2'-9"	7'-3"	8'-8"	L2	
1	2'-9"	7'-3"	9'-0"	L2	
1	2'-9"	7'-3"	9'-0"	L2	
41	2'-9"	5'-11"	7'-8"	L3	
1	2'-9"	7'-3"	9'-0"	L2	
1	2'-9"	7'-3"	8'-8"	L2	
1	2'-9"	7'-3"	8'-8"	L2	
1	2'-9"	7'-3"	8'-8"	L3	
1	2'-9"	7'-3"	8'-8"	L3	
41	2'-9"	5'-11"	18'-7"	L2	
41	2'-9"	5'-11"	18'-7"	L2	
42	2'-9"	5'-9"	7'-6"	L0	
42	2'-9"	5'-9"	7'-6"	L0	
42	2'-9"	5'-9"	7'-11"	L0	
42	2'-9"	5'-9"	7'-11"	L0	

Door Schedule						
Mark	Size			Level	Hardware From Room Number	Comments
	Width	Height	Thickness			
117	2'-11"	6'-7"	0'-2"	L1	109	
118	2'-6"	6'-7"	0'-2"	L1	116	
120	4'-7"	10'-4"	0'-1"	L1	110	
121	2'-6"	6'-7"	0'-2"	L1	114	
122	2'-3"	8'-0"	0'-2"	L1		
123	2'-3"	8'-0"	0'-2"	L1		
124	2'-6"	6'-7"	0'-2"	L1	111	
125	4'-8"	6'-7"	0'-2"	L1	109	
126	2'-11"	6'-7"	0'-2"	L1	110	
127	2'-0"	6'-7"	0'-2"	L1	113	
128	2'-5"	7'-0"	0'-1"	L1	112	
131	2'-6"	6'-7"	0'-2"	L2		
132	2'-6"	6'-7"	0'-2"	L2	122	
133	2'-6"	6'-7"	0'-2"	L2	122	
134	2'-1"	6'-7"	0'-2"	L2	121	
135	2'-1"	6'-7"	0'-2"	L2	120	
136	2'-6"	6'-7"	0'-2"	L2		
137	1'-9"	6'-7"	0'-2"	L2	124	
138	2'-6"	6'-7"	0'-2"	L2	123	
139	2'-6"	6'-7"	0'-2"	L2	122	
140	2'-6"	6'-7"	0'-2"	L3	141	
141	2'-6"	6'-7"	0'-2"	L3	137	
142	2'-6"	6'-7"	0'-2"	L3	141	
144	2'-6"	6'-7"	0'-2"	L3	141	
145	2'-6"	6'-7"	0'-2"	L3	141	
146	2'-6"	6'-7"	0'-2"	L3	138	
147	2'-1"	6'-7"	0'-2"	L3		
148	2'-1"	6'-7"	0'-2"	L0		
149	1'-9"	6'-7"	0'-2"	L0	125	
151	2'-11"	6'-7"	0'-2"	L0	127	
152	2'-6"	6'-7"	0'-2"	L0		
153	2'-3"	7'-0"	0'-2"	L0		
154	2'-11"	6'-7"	0'-2"	L0		
155	8'-0"	8'-0"	0'-2"	L0	126	
156	2'-6"	6'-7"	0'-2"	L0	128	
157	2'-1"	6'-7"	0'-2"	L0		
158	2'-6"	6'-7"	0'-2"	L-1	134	
159	3'-9"	6'-7"	0'-2"	L-1		
160	2'-6"	6'-7"	0'-2"	L-1	132	
161	2'-3"	6'-0"	0'-2"	L-1	133	



TECHSCAN
Surveying As Builds and Geospatial Solutions

365 Greene Ave, Brooklyn

Architectural Details

Project number 001

Date Issue Date

Checked by Checker

A503

Scale



18 Spencer St, Brooklyn,
NY 11205
info@TechScanusa.com
TechScanusa.com
(929) 486 9091