


AS-BUILT DOCUMENTATION 89-19 171st St #6m, Jamaica, NY 11432, USA

- A1, A2, A3, A4 & A5 THESE DOCUMENTS ARE THE PROPERTY OF THE DESIGNER AND SHALL NOT BE COPIED, DUPLICATED, ALTERED, MODIFIED OR REVISED IN ANY WAY WITHOUT THE WRITTEN APPROVAL OF THE DESIGNER.
- CONTRACTOR SHALL VERIFY ALL CONDITIONS AND DIMENSIONS AT THE SITE AND ALL INCONSISTENCIES SHALL BE BROUGHT TO THE ATTENTION OF THE DEVELOPER AND THE DESIGNER BEFORE PROCEEDING WITH THE WORK.
- ANY ERRORS OR OMISSIONS FOUND IN THESE DRAWINGS SHALL BE BROUGHT TO DEVELOPERS AND DESIGNERS ATTENTION IMMEDIATELY.
- DO NOT SCALE DRAWINGS. WRITTEN DIMENSIONS TAKE PRECEDENCE OVER SCALED DIMENSIONS.
- ALL DIMENSIONS ARE TO FACE OF STUD OR TO FACE OF FRAMING UNLESS OTHERWISE NOTED.
- ALL TRUSS DRAWINGS TO BE REVIEWED AND APPROVED BY THE STRUCTURAL ENGINEER PRIOR TO ISSUANCE OF BUILDING PERMIT.
- ALL OR EQUAL SUBSTITUTIONS MUST BE SUBMITTED TO AND APPROVED BY CITY BUILDING OFFICIAL PRIOR TO INSTALLATION.
- ALL ELECTRICAL AND MECHANICAL EQUIPMENT AND METERS ARE SUBJECT TO RELOCATION DUE TO FIELD CONDITIONS, CONTRACTOR TO VERIFY.
- DAMP PROOFING - ONE COAT CONTINUOUS ELASTOMERIC WATERPROOFING FROM GRADE LEVEL TO BOTTOM OF FOUNDATION.
- SHOP DRAWING REVIEW AND DISTRIBUTION, ALONG WITH PRODUCT SUBMITTALS, REQUESTED IN THE CONSTRUCTION DOCUMENTS, SHALL BE THE SOLE RESPONSIBILITY OF THE GENERAL CONTRACTOR, UNLESS DIRECTED OTHERWISE UNDER A SEPARATE AGREEMENT.
- DEVIATIONS FROM THESE DOCUMENTS IN THE CONSTRUCTION PHASE SHALL BE REVIEWED BY THE DESIGNER AND THE OWNER PRIOR TO THE START OF WORK IN QUESTION. ANY DEVIATIONS FROM THESE DOCUMENTS WITHOUT PRIOR REVIEW, SHALL BE THE SOLE RESPONSIBILITY OF THE GENERAL CONTRACTOR.
- THE GENERAL CONTRACTOR SHALL BE RESPONSIBLE FOR ALL WORK AND MATERIALS REPRESENTED ON THESE DOCUMENTS INCLUDING THE WORK AND MATERIALS FURNISHED BY SUBCONTRACTORS AND VENDORS.
- THE BUILDER SHALL FURNISH ART AND ALL REPORTS RECEIVED FROM THE GEOTECHNICAL ENGINEER (SOILS REPORT), ON THE STUDY OF THE PROPOSED SITE, TO THE DESIGNER, STRUCTURAL ENGINEER, AND GENERAL CONTRACTOR. IN THE EVENT THE GEOTECHNICAL REPORTS DO NOT EXIST, THE SOILS CONDITION SHALL BE ASSUMED TO BE A MINIMUM DESIGN SOIL PRESSURE STATED BY THE STRUCTURAL ENGINEER OF RECORD FOR THE PURPOSE OF STRUCTURAL DESIGN. GENERAL CONTRACTOR SHALL ASSURE THE SOIL CONDITIONS MEET OR EXCEED THE CRITERIA.
- ALL WORK PERFORMED BY THE GENERAL CONTRACTOR SHALL COMPLY AND CONFORM WITH LOCAL AND STATE BUILDING CODES, ORDINANCES AND REGULATIONS, ALONG WITH ALL OTHER AUTHORITIES HAVING JURISDICTION. THE GENERAL CONTRACTOR IS RESPONSIBLE TO BE AWARE OF THESE REQUIREMENTS AND GOVERNING REGULATIONS.
- WINDOW SUPPLIER TO VERIFY AT LEAST ONE WINDOW IN ALL BEDROOMS TO HAVE A CLEAR EGRESS OPENING OF 5.7 SQ FT WITH MIN. DIMENSION OF 24" IN HEIGHT AND 20" IN WIDTH.


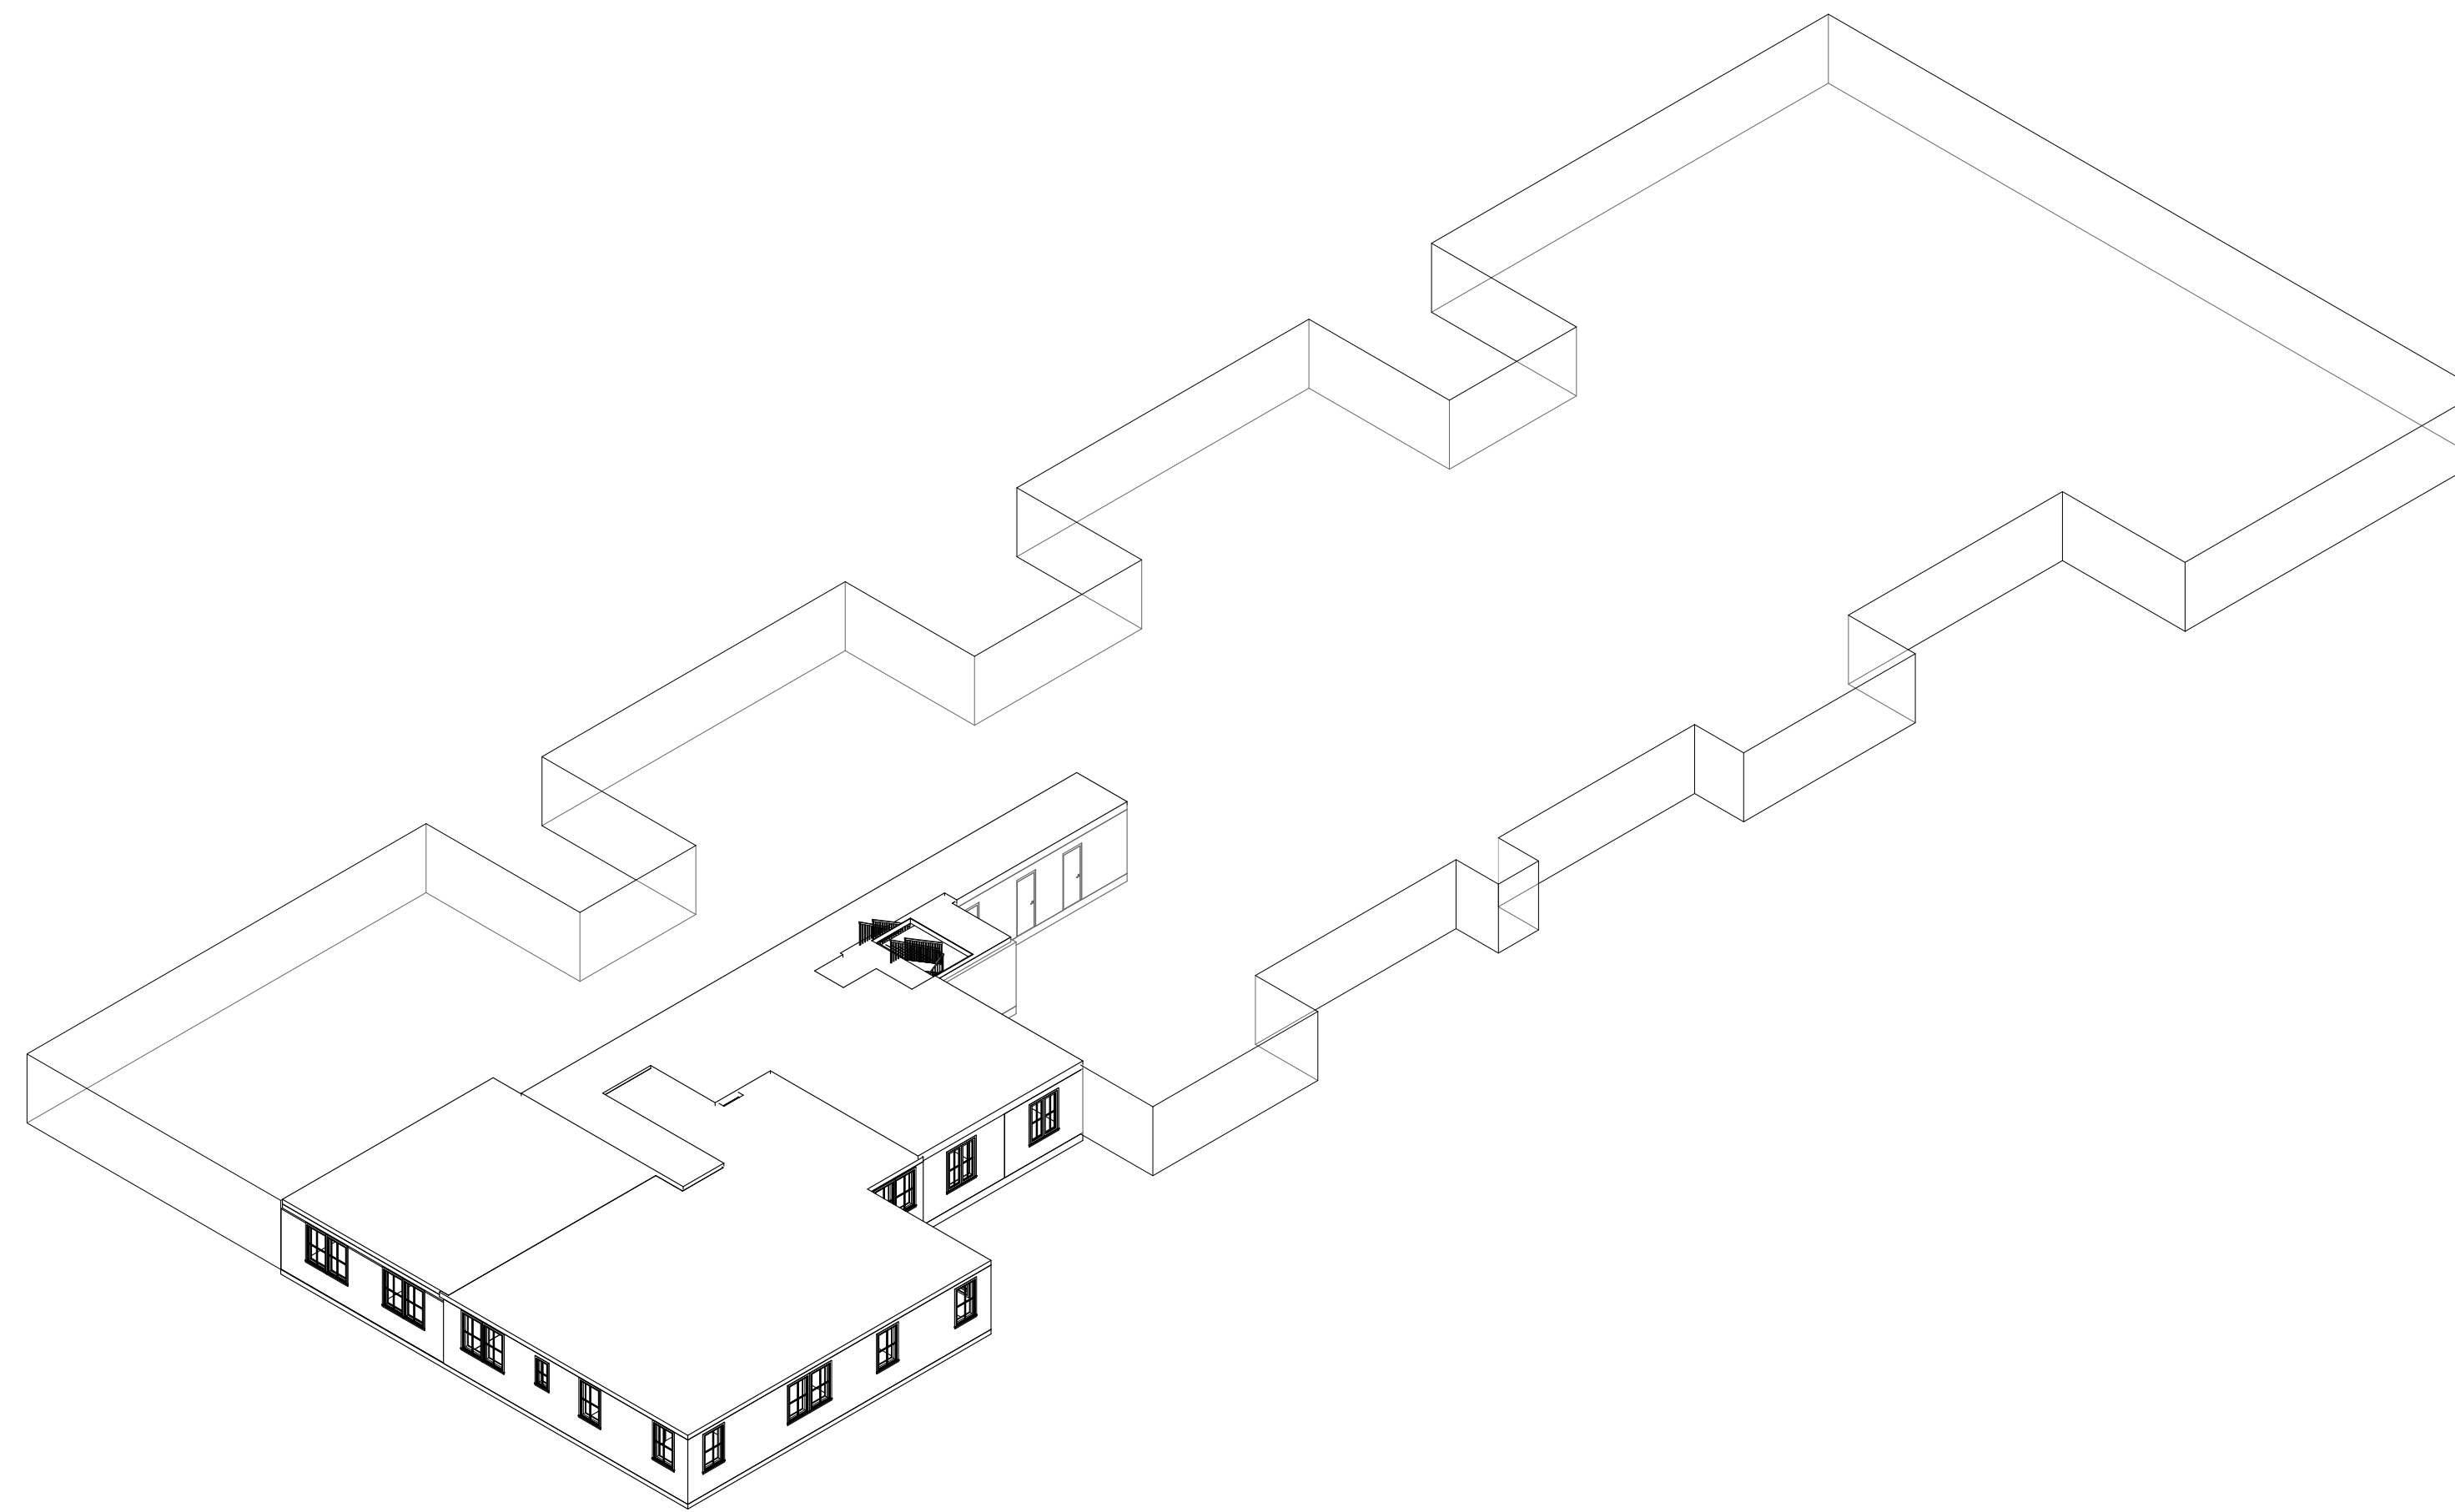


1 {3D}

Working Sheet List			
Sheet Number	Sheet Name	Sheet Sort	Sheet Group
A000	Cover	000	General
A101	Architectural Floor Plans	070	Architectural
A201	Architectural Building Elevations	070	Architectural
A301	Architectural Building Sections	070	Architectural
A401	Architectural Enlarged Views	070	Architectural
A501	Architectural Details	070	Architectural
A502	Architectural Details	070	Architectural

Level Schedule					
Name	Elevation Base	Elevation	Structural	Story Above	Workset
L1	Project Base Point	0' - 0"	No	Default	
L1-Roof	Project Base Point	8' - 2"	No	Default	
L2	Project Base Point	8' - 10"	No	Default	
L2-Roof	Project Base Point	17' - 1"	No	Default	

Room Finish Schedule				
Room Number	Room Name	Area	Level	
100	Bedroom	175 ft ²	L1	
101	Bath	34 ft ²	L1	
102	Kitchenette	88 ft ²	L1	
103	Bedroom	89 ft ²	L1	
104	Family Room	256 ft ²	L1	
105	Room	118 ft ²	L1	
106	Room	81 ft ²	L1	
107	Room	87 ft ²	L1	
108	Hall	26 ft ²	L1	
109	Hall	115 ft ²	L1	
110	W.I.C.	27 ft ²	L1	
111	Bath	46 ft ²	L1	
112	Kitchen	68 ft ²	L1	
113	Primary Bedroom	304 ft ²	L1	
114	Hall	132 ft ²	L1	
115	Hall	Not Placed	Not Placed	
116	Hall	153 ft ²	L1	
117	Hall	Not Placed	Not Placed	
118	Bedroom	Not Enclosed	L2	
119	Bedroom	Not Enclosed	L2	
120	Kitchen	Not Enclosed	L2	
121	Bath	Not Enclosed	L2	
122	Living Room	Not Enclosed	L2	
123	Dinning Area	Not Enclosed	L2	
124	Room Name	Not Enclosed	L2	
125	Hall	Not Enclosed	L2	
126	Room Name	Not Placed	Not Placed	
127	Hall	Not Enclosed	L2	
128	Bedroom	177 ft ²	L1	
129	Bedroom	167 ft ²	L1	
130	Living Room	90 ft ²	L1	
131	Bath	35 ft ²	L1	
132	Kitchen	56 ft ²	L1	
133	Hall	28 ft ²	L1	
134	Room Name	501 ft ²	L1	
135	Dinning area	81 ft ²	L1	
136	Living room	350 ft ²	L1	
137	Bedroom	182 ft ²	L1	
138	Kitchen	66 ft ²	L1	
139	Bathroom	35 ft ²	L1	
140	Storage	21 ft ²	L1	
141	Storage	19 ft ²	L1	

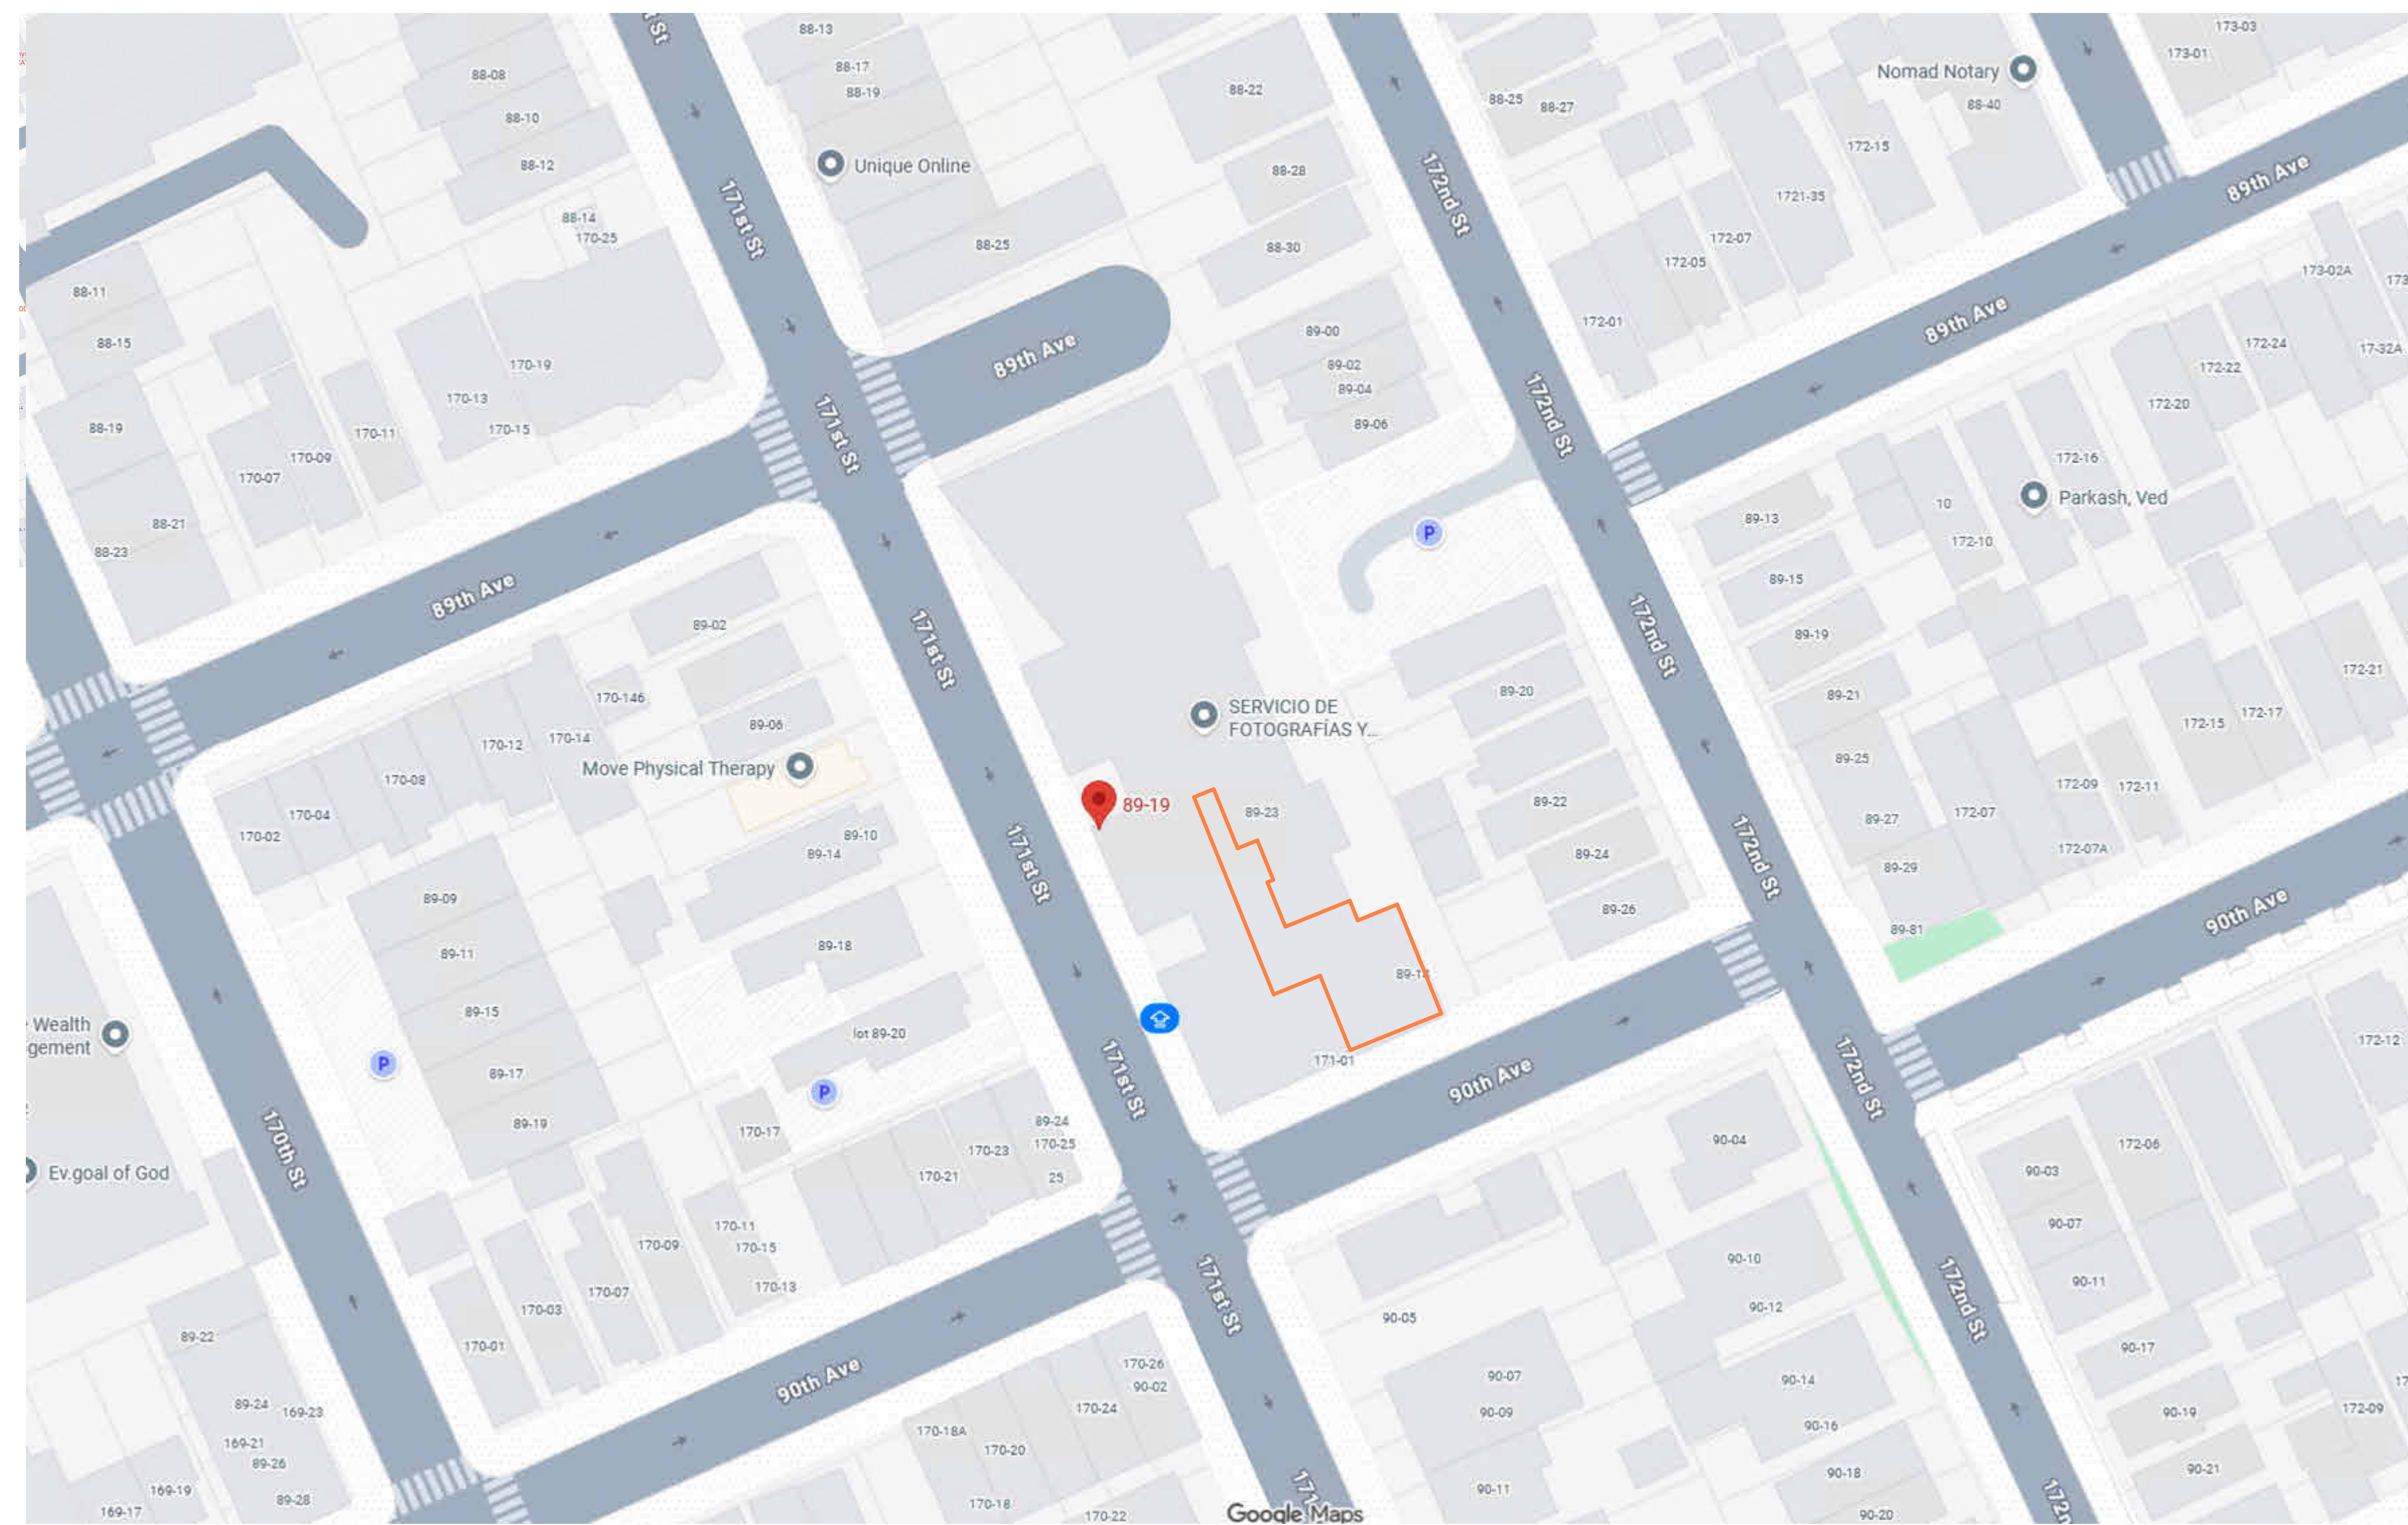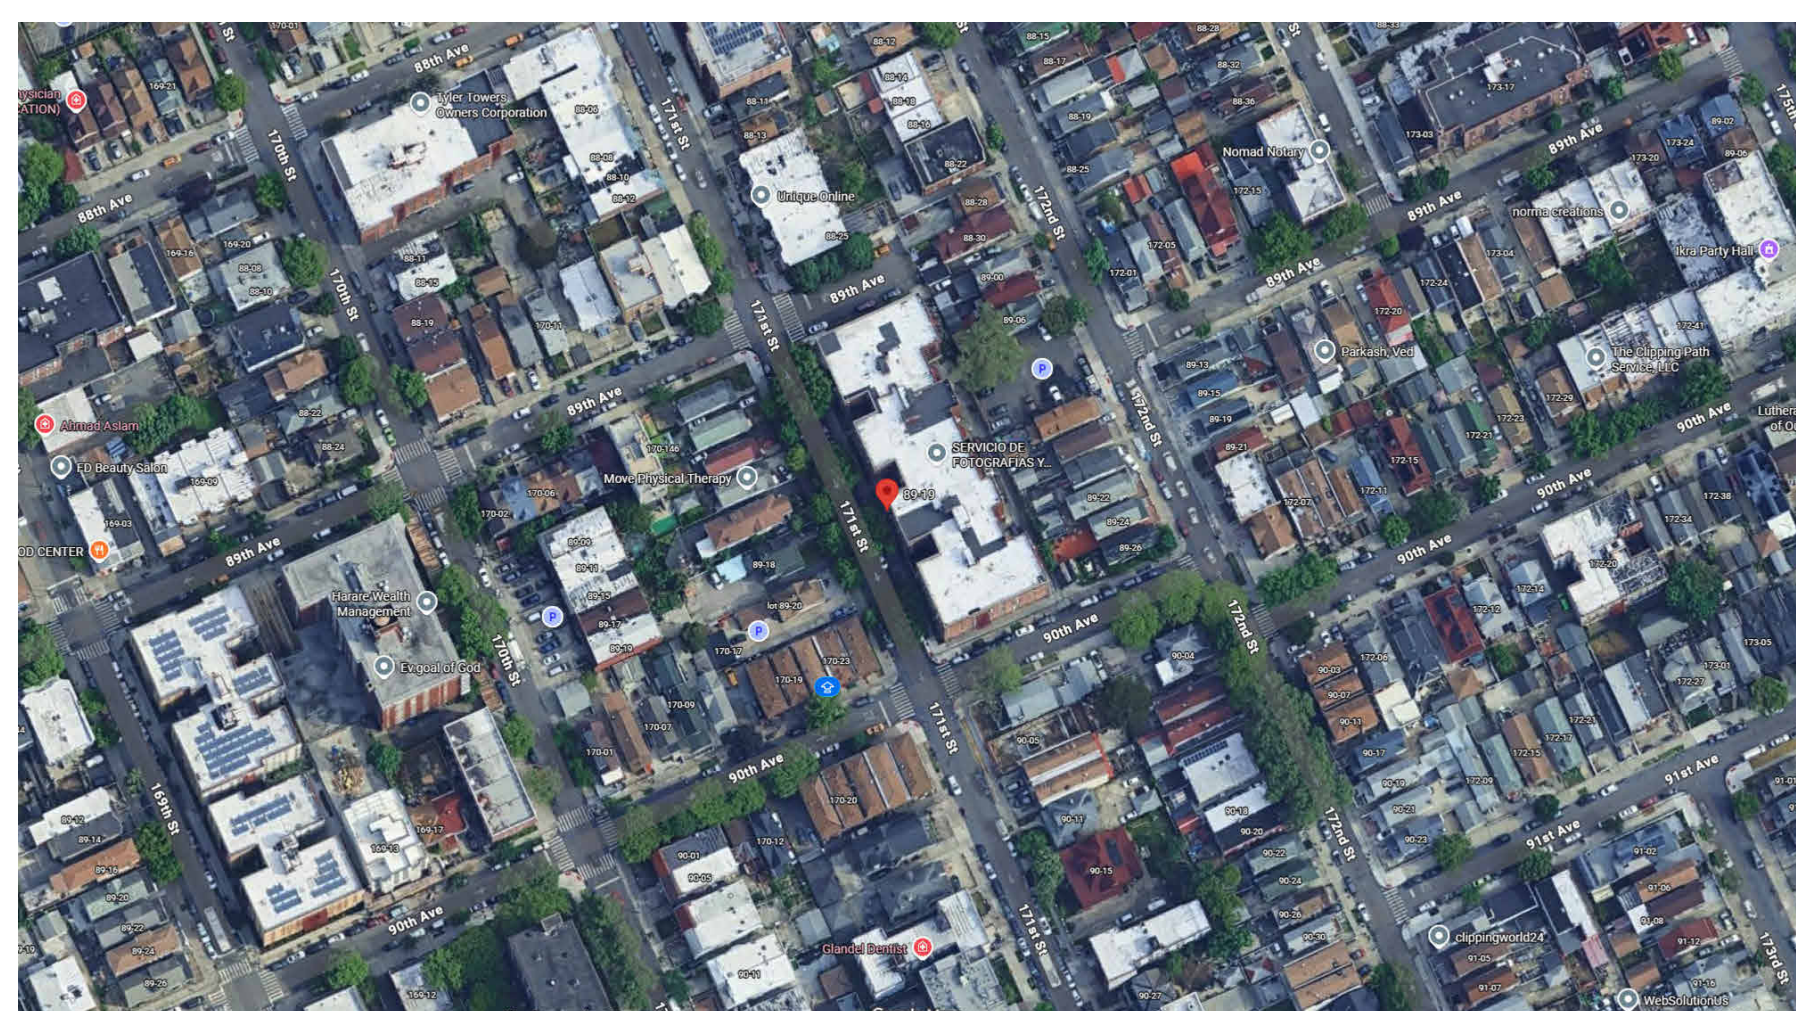

TECHSCAN
Surveying As-Built and Geospatial Solutions

Project Name	Cover
Project number	Project Number
Date	Issue Date
Checked by	Checker
	A000
Scale	



18 Spencer St, Brooklyn, NY 11205
info@techscanusa.com
TechScanusa.com
(929) 486-9091

AS-BUILT DOCUMENTATION

Symbols Legend

General

	Section Head
	Centerline
	Section Head - Triangle
	Interior Elevation Marker
	Elevation Marker
	Room Tag
	Grid Head
	Elevation Marker
	North Marker
	Revision tag
	Section Head
	Section tail
	Spot elevation
	View reference
	View title
	Windows tag

Note:

Although every attempt has been made to ensure the quality and accuracy of these asbuilt drawings, prior to the commencement of any office or fieldwork these as built drawings must be field verified for any discrepancies. Asbuilt Professionals must be notified within 30 days of the date of delivery in writing as to any discrepancies. The discovery of any discrepancies after 30 days or after the commencement of any office or fieldwork is the full responsibility of the client to remedy.

Reflected Ceiling Plan

	Exhaust vent
	Ceiling mounted light fixture
	Ceiling mounted directional light
	Recessed can light
	Eyeball or small can light
	Pendant light
	Individual floor, lay-in fixture 4 bulb
	Individual floor, hanging fixture 2 bulb
	Individual floor, flush mount fixture 4 bulb
	Camera
	Motion det.
	Supply vent
	Return vent
	Spaker

Fire protection

	Fire extinguisher
	Fire pull
	Fire alarm (horn/strobe)
	Smoke detector
	Smoke alarm speaker
	Sprinkler head ceiling mount
	Sprinkler head wall mount

MISC

	Bollard
	Spot elevation

Electric

	Data outlet		Basic switch
	Telephone jack		Occupancy sensor switch
	Electric switch		Dimmer switch
	Cable television outlet		Double pole switch
	Duplex receptacle outlet		Three-way switch
	Special purpose connection or outlet		Four-way switch
	Quadruplex receptacle outlet		Emergency switch
	Floor duplex receptacle outlet		Timmer switch
	Electric panel		GFCI receptacle
	Electric meter		Weatherproof receptacle
	Button switch		USB receptacle
	Disconnect switch		Wireless access point (WAP)
	Ground/floor light		Transformer
	Key pad		

MEP

	Thermostat		HVAC duct
	Floor drain		Rectangular duct
	Valve		Round duct
	Hose bib		Flexible duct
	Water supply		Duct shaft
	Suspended gas heater		



TECHSCAN
Surveying As Builds and Geospatial Solutions

89-19 171st St #6m

Cover

Project number 001

Date Issue Date

Checked by Checker

A001

Scale 1 : 50



18 Spencer St, Brooklyn,
NY 11205
info@TechScanusa.com
TechScanusa.com
(929) 486 9091



TECHSCAN
Surveying As Builds and Geospatial Solutions



Project Name

Architectural Floor Plans

Project number Project Number

Date Issue Date

Checked by Checker

A101

Scale 1 : 50



18 Spencer St, Brooklyn,
NY 11205
info@techscanusa.com
TechScanusa.com
(929) 486-9091

1 First Floor Architectural
Plan
1:50



1 South Architectural Building
Elevation
1:50



2 South Architectural Building
Elevation
1:50




TECHSCAN
Surveying As Builds and Geospatial Solutions


Project Name	Architectural Building Elevations
Project number	Project Number
Date	Issue Date
Checked by	Checker
	A201
Scale	1 : 50



18 Spencer St, Brooklyn,
NY 11205
info@techscanusa.com
TechScanusa.com
(929) 486-9031

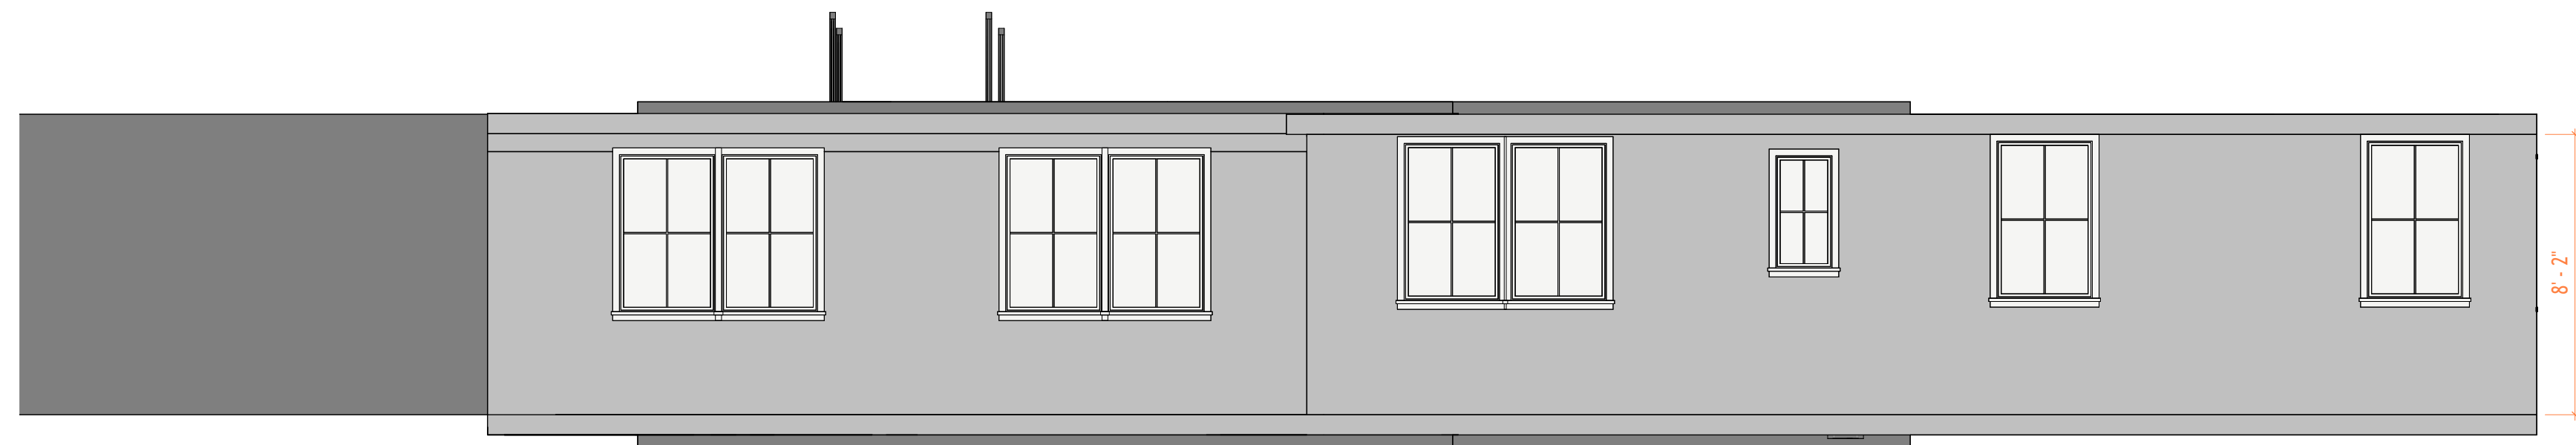

1 West Architectural Building
Elevation
1:50

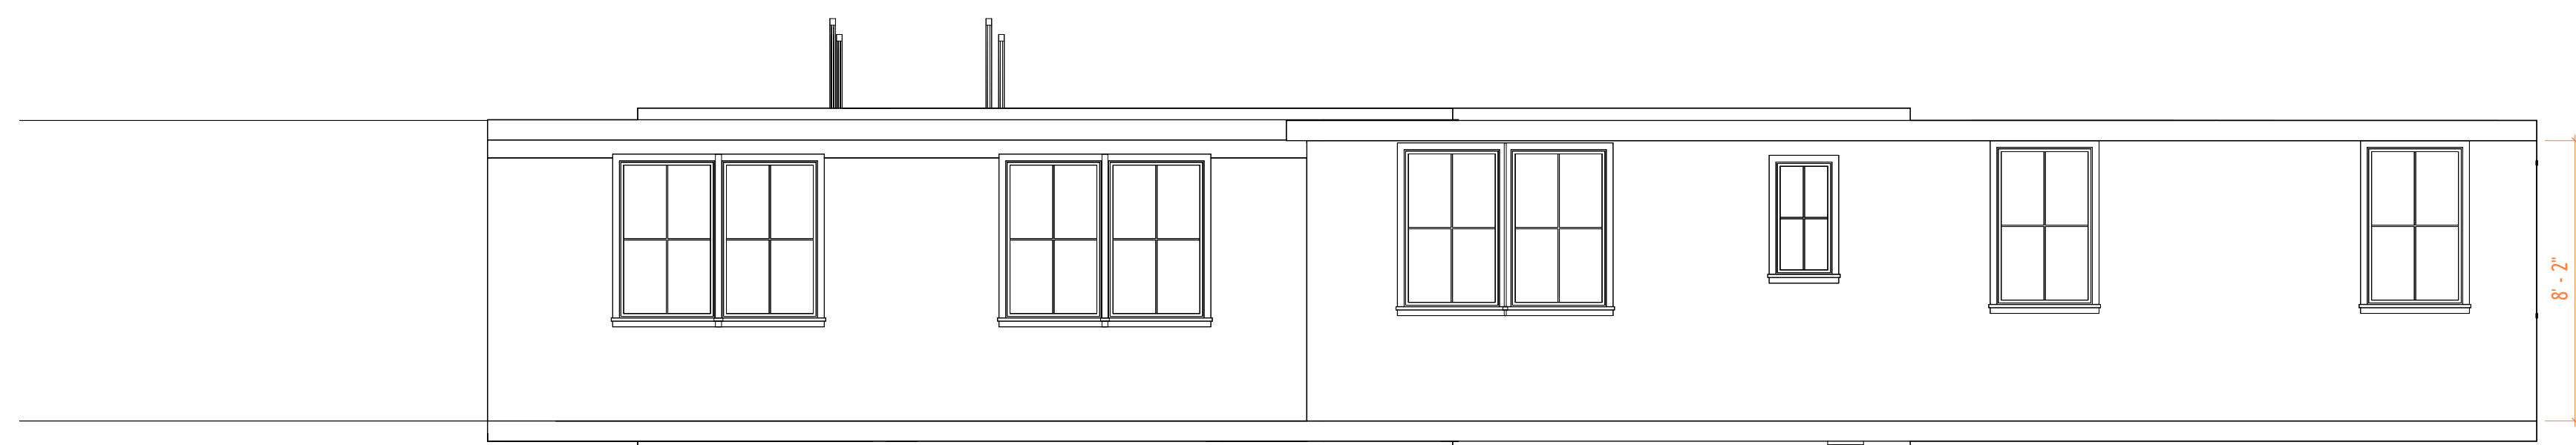

2 West Architectural Building
Elevation
1:50



TECHSCAN
Surveying As Builds and Geospatial Solutions

Project Name	Architectural Building Elevations
Project number	Project Number
Date	Issue Date
Checked by	Checker
	A202
Scale	1 : 50



18 Spencer St, Brooklyn,
NY 11205
info@techscanusa.com
TechScanusa.com
(929) 486-9031



TECHSCAN
Surveying As Builds and Geospatial Solutions

Project Name

Architectural Building
Sections

Project number Project Number

Date Issue Date

Checked by Checker

A301


Scale 1 : 50




18 Spencer St, Brooklyn,
NY 11205
info@techscanusa.com
TechScanusa.com
(929) 486-9031




1 Section 1
1 : 50

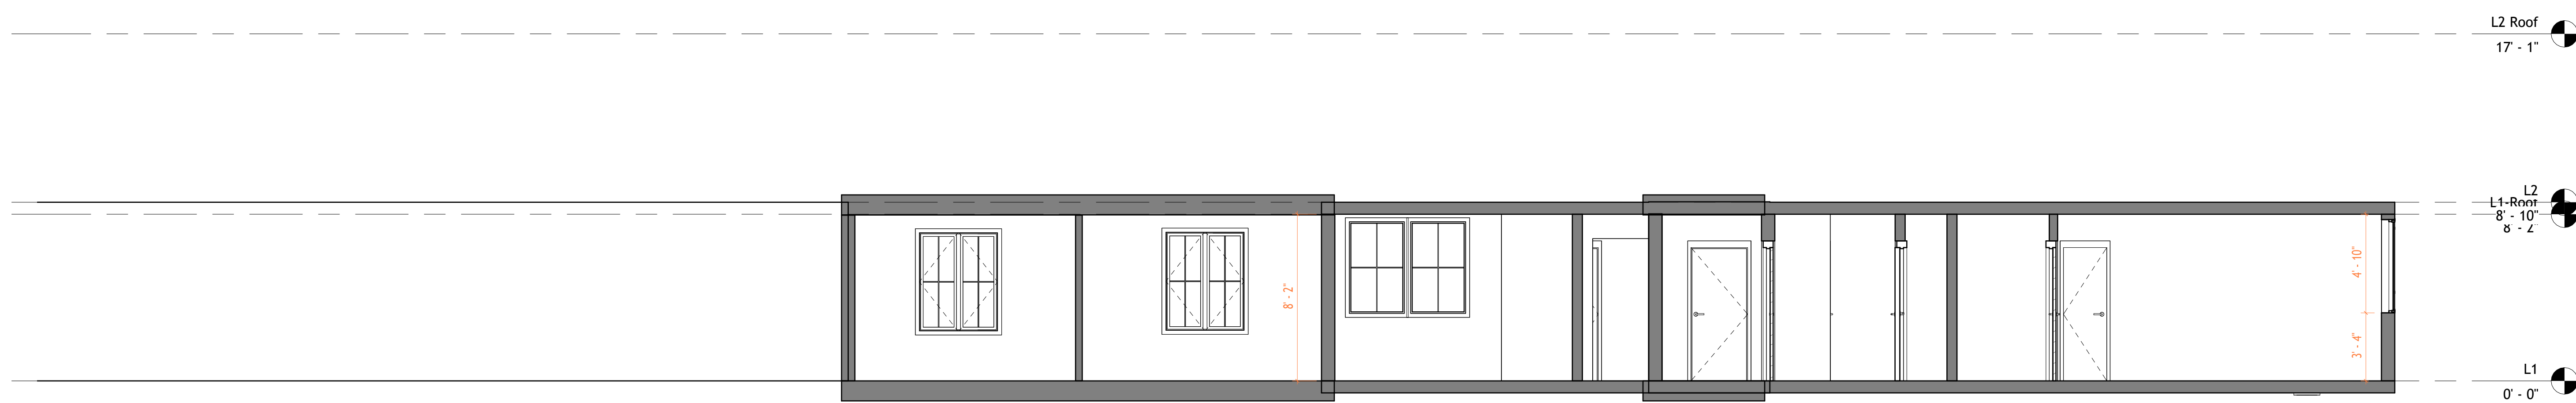

2 Section 3
1 : 50

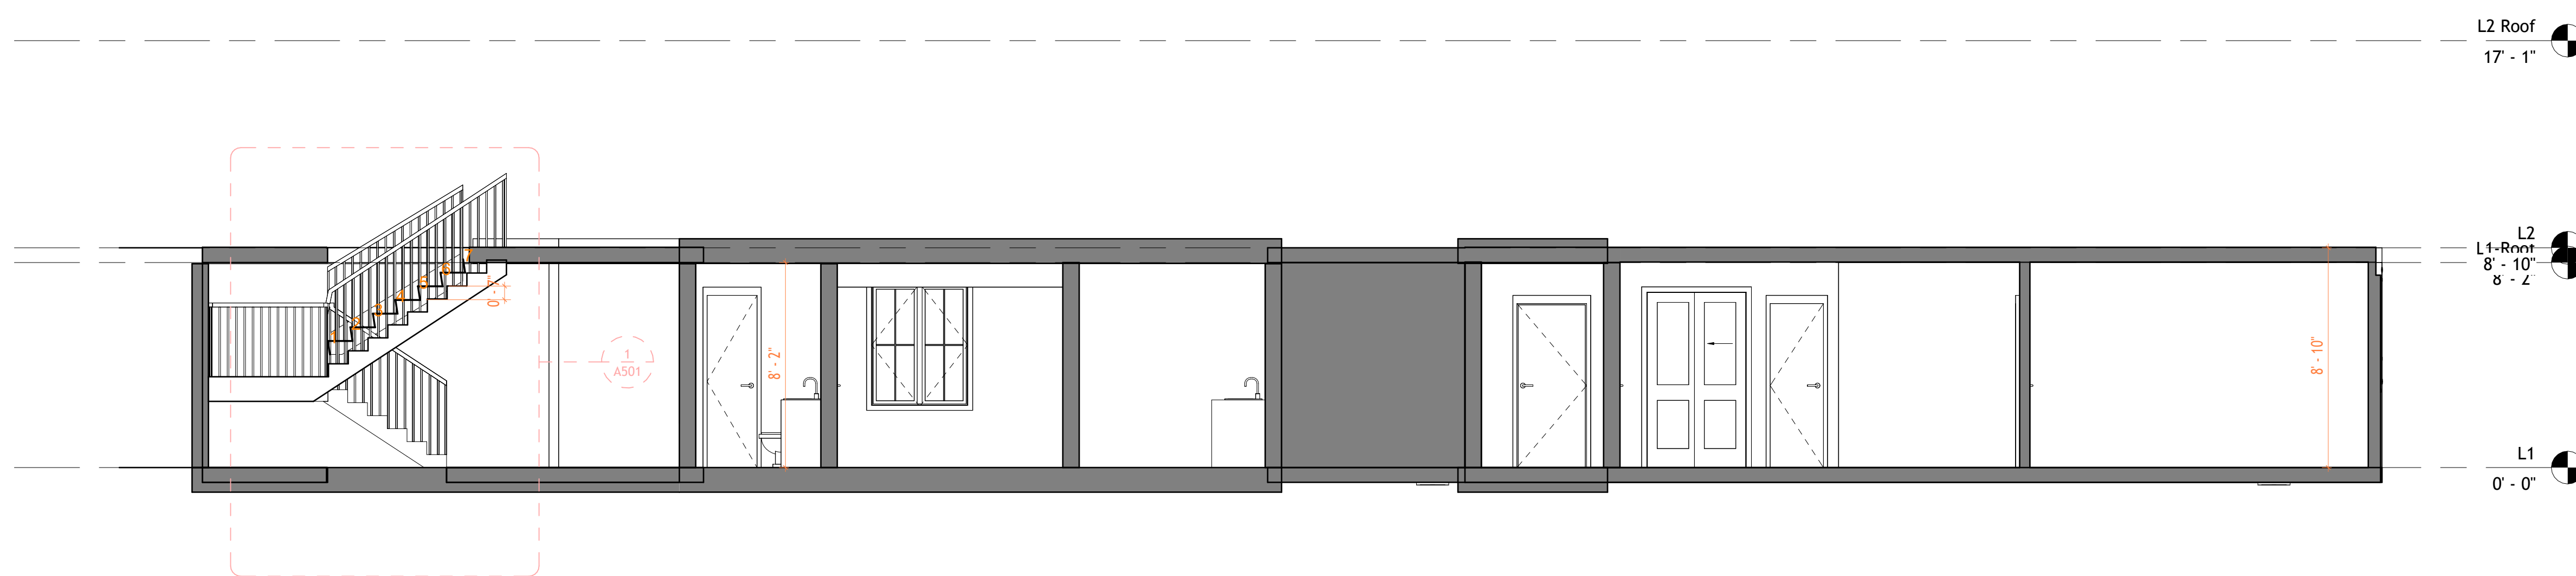


3 Section 5
1 : 50

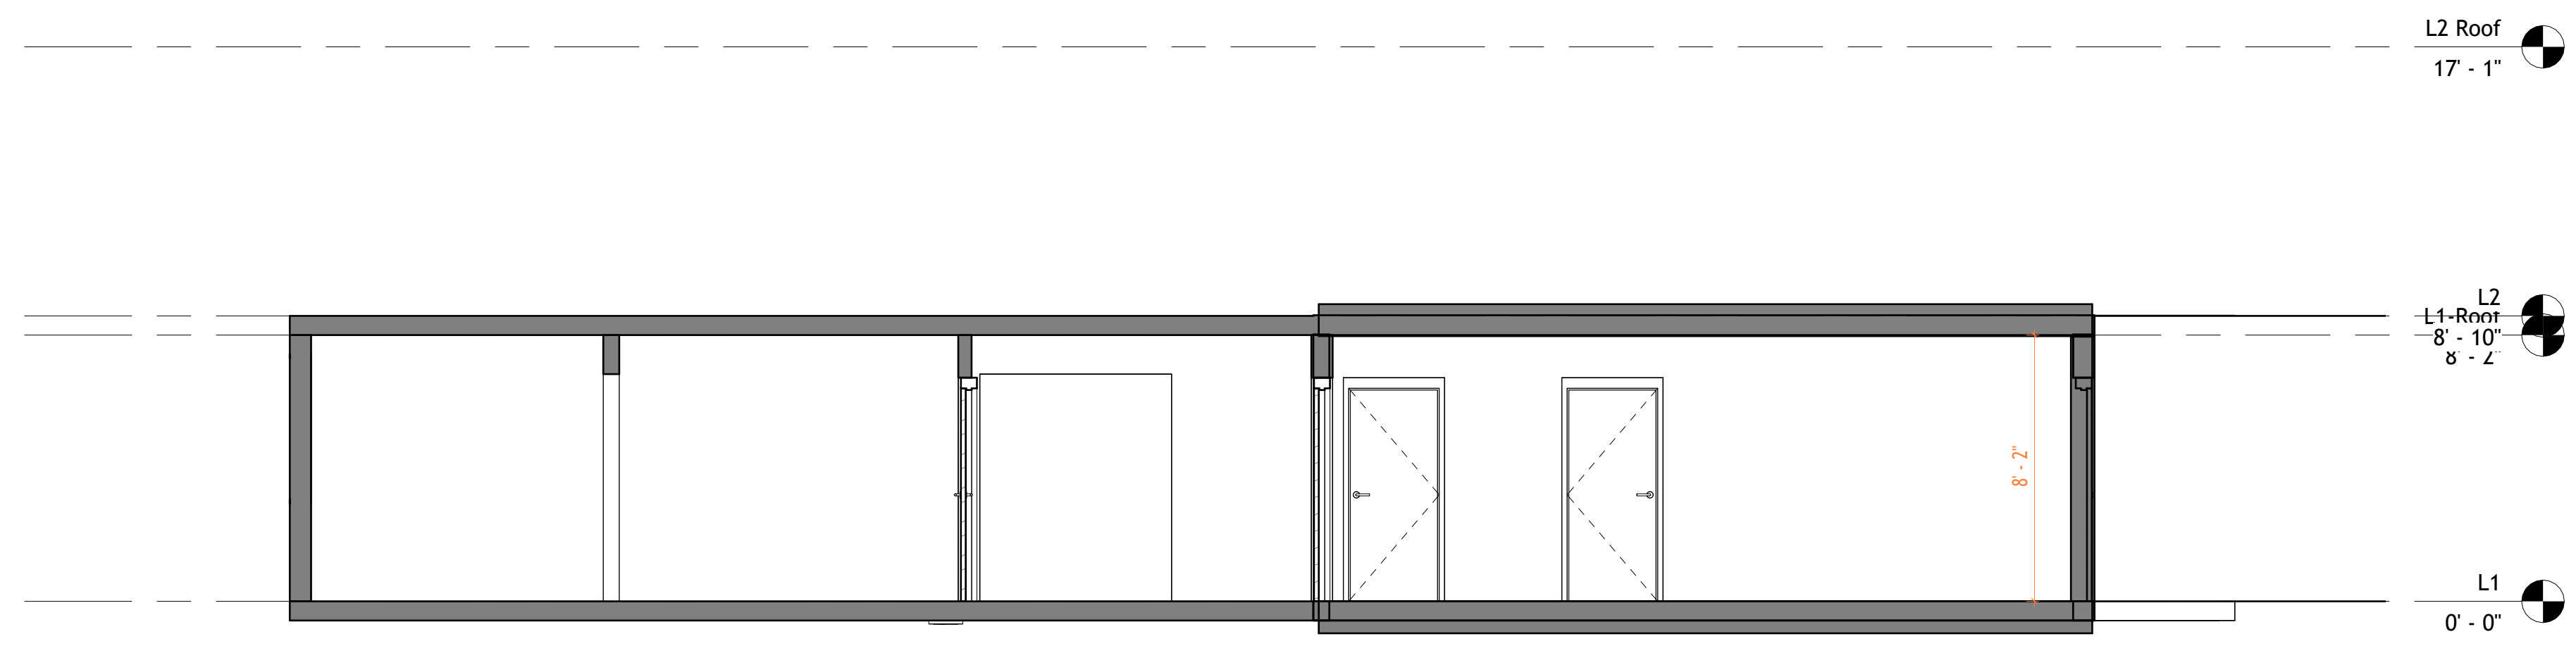

1 Section 2
1 : 50



2 Section 4
1 : 50

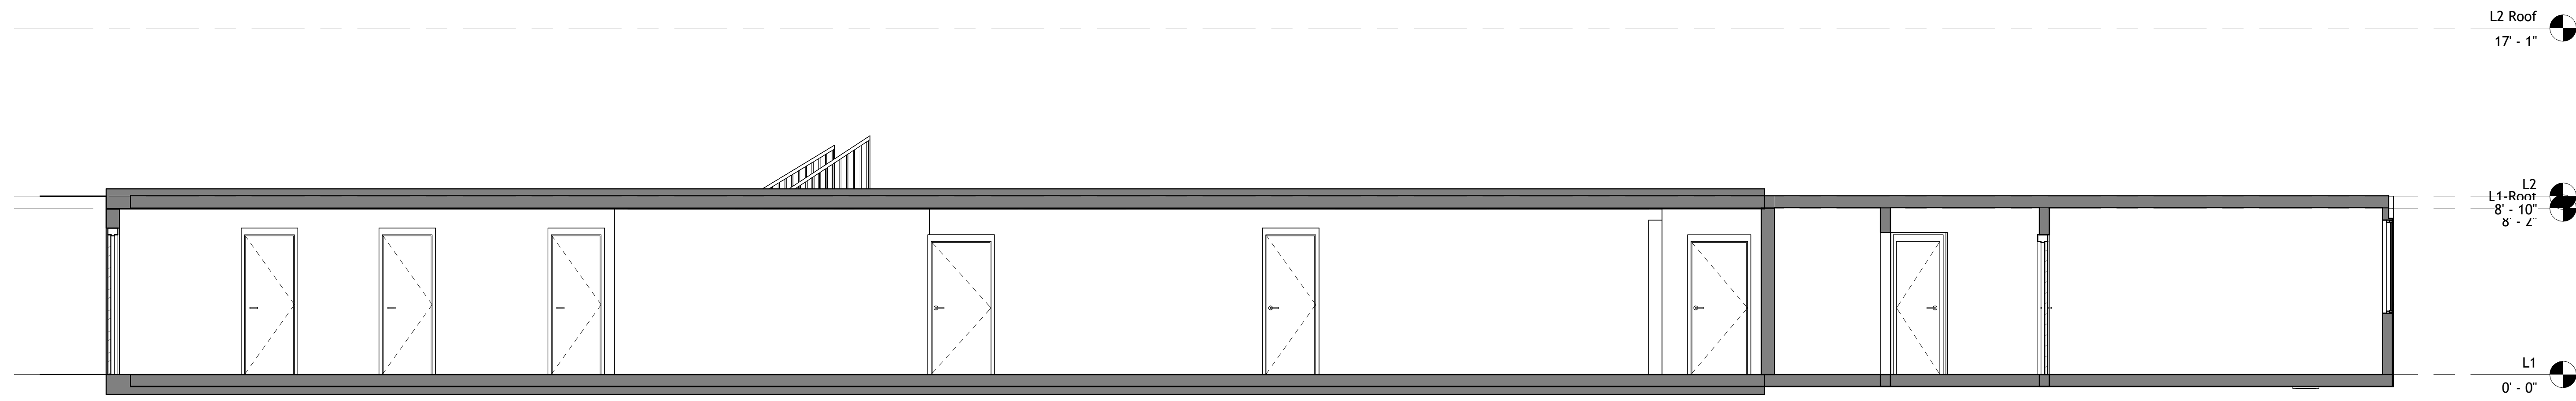

3 Section 6
1 : 50




TECHSCAN
Surveying As Builds and Geospatial Solutions

Project Name	
Architectural Building Sections	
Project number	Project Number
Date	Issue Date
Checked by	Checker
	A302
Scale	1 : 50



18 Spencer St, Brooklyn, NY 11205
info@techscanusa.com
TechScanusa.com
 (929) 486-9091

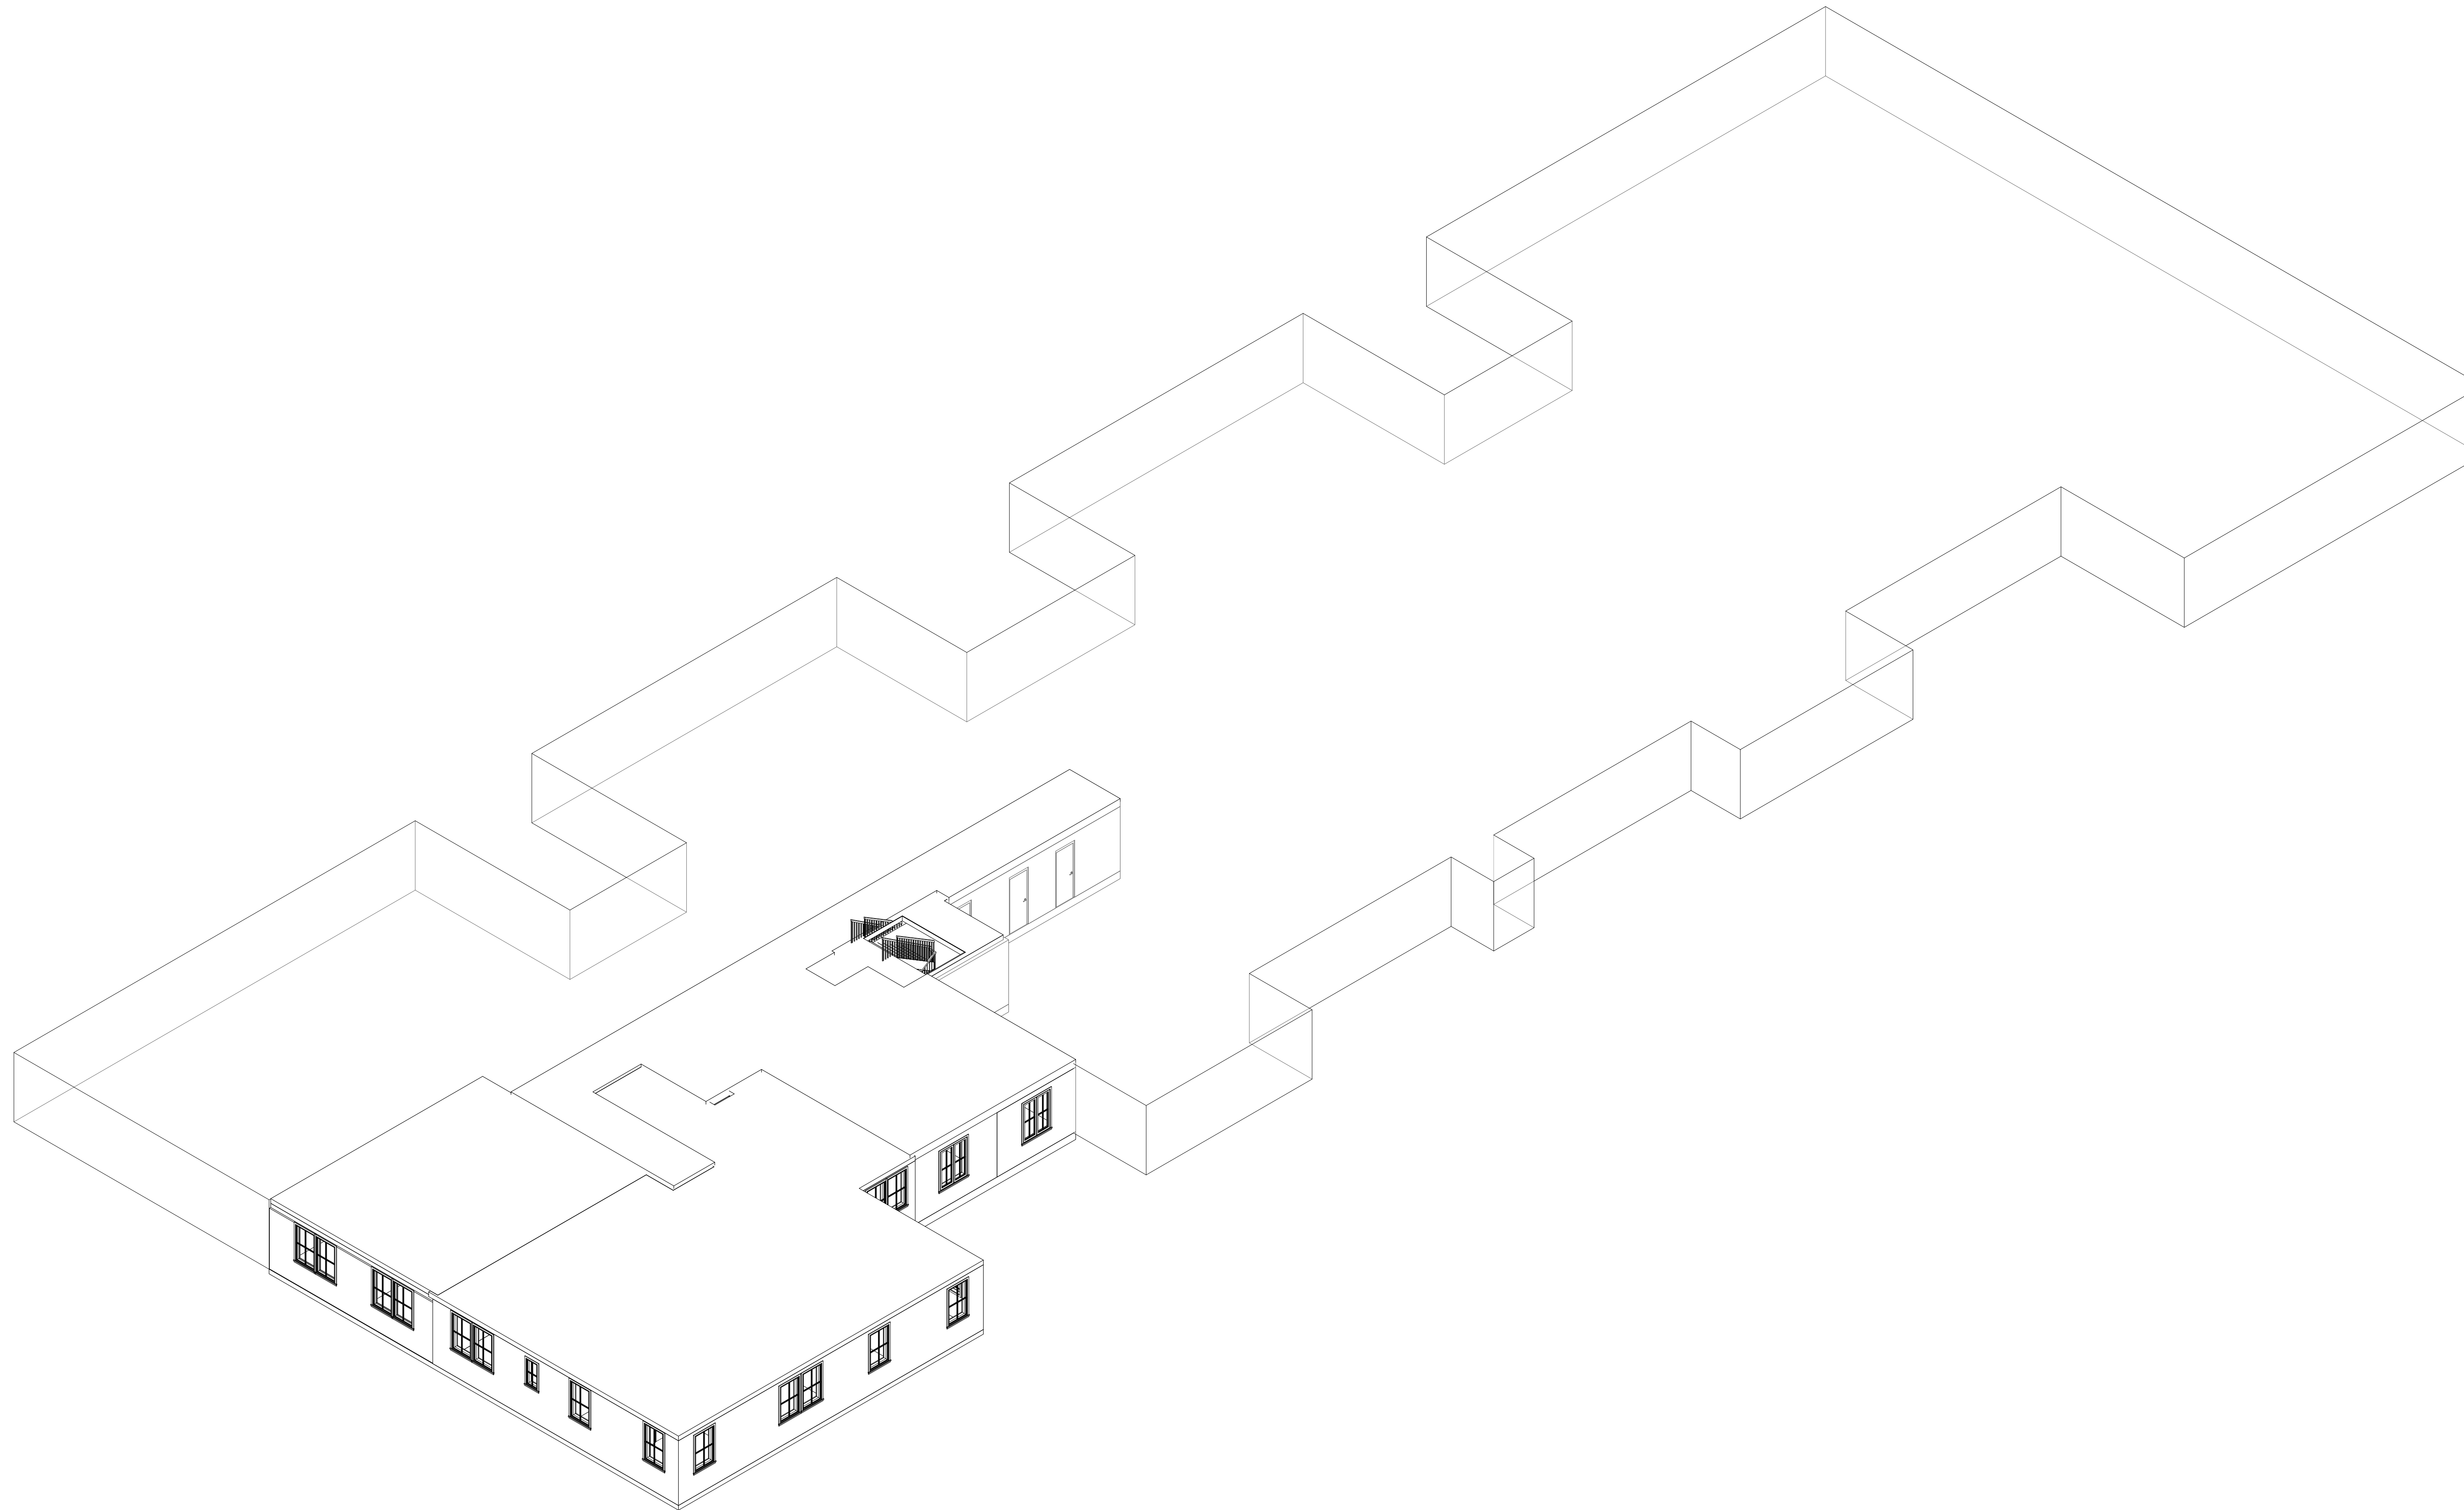

1 {3D} Copy 1




TECHSCAN
Surveying As Builds and Geospatial Solutions

Project Name	
Architectural Enlarged Views	
Project number	Project Number
Date	Issue Date
Checked by	Checker
	A401
Scale	



18 Spencer St, Brooklyn,
NY 11205
info@techscanusa.com
TechScanusa.com
(929) 486-9038

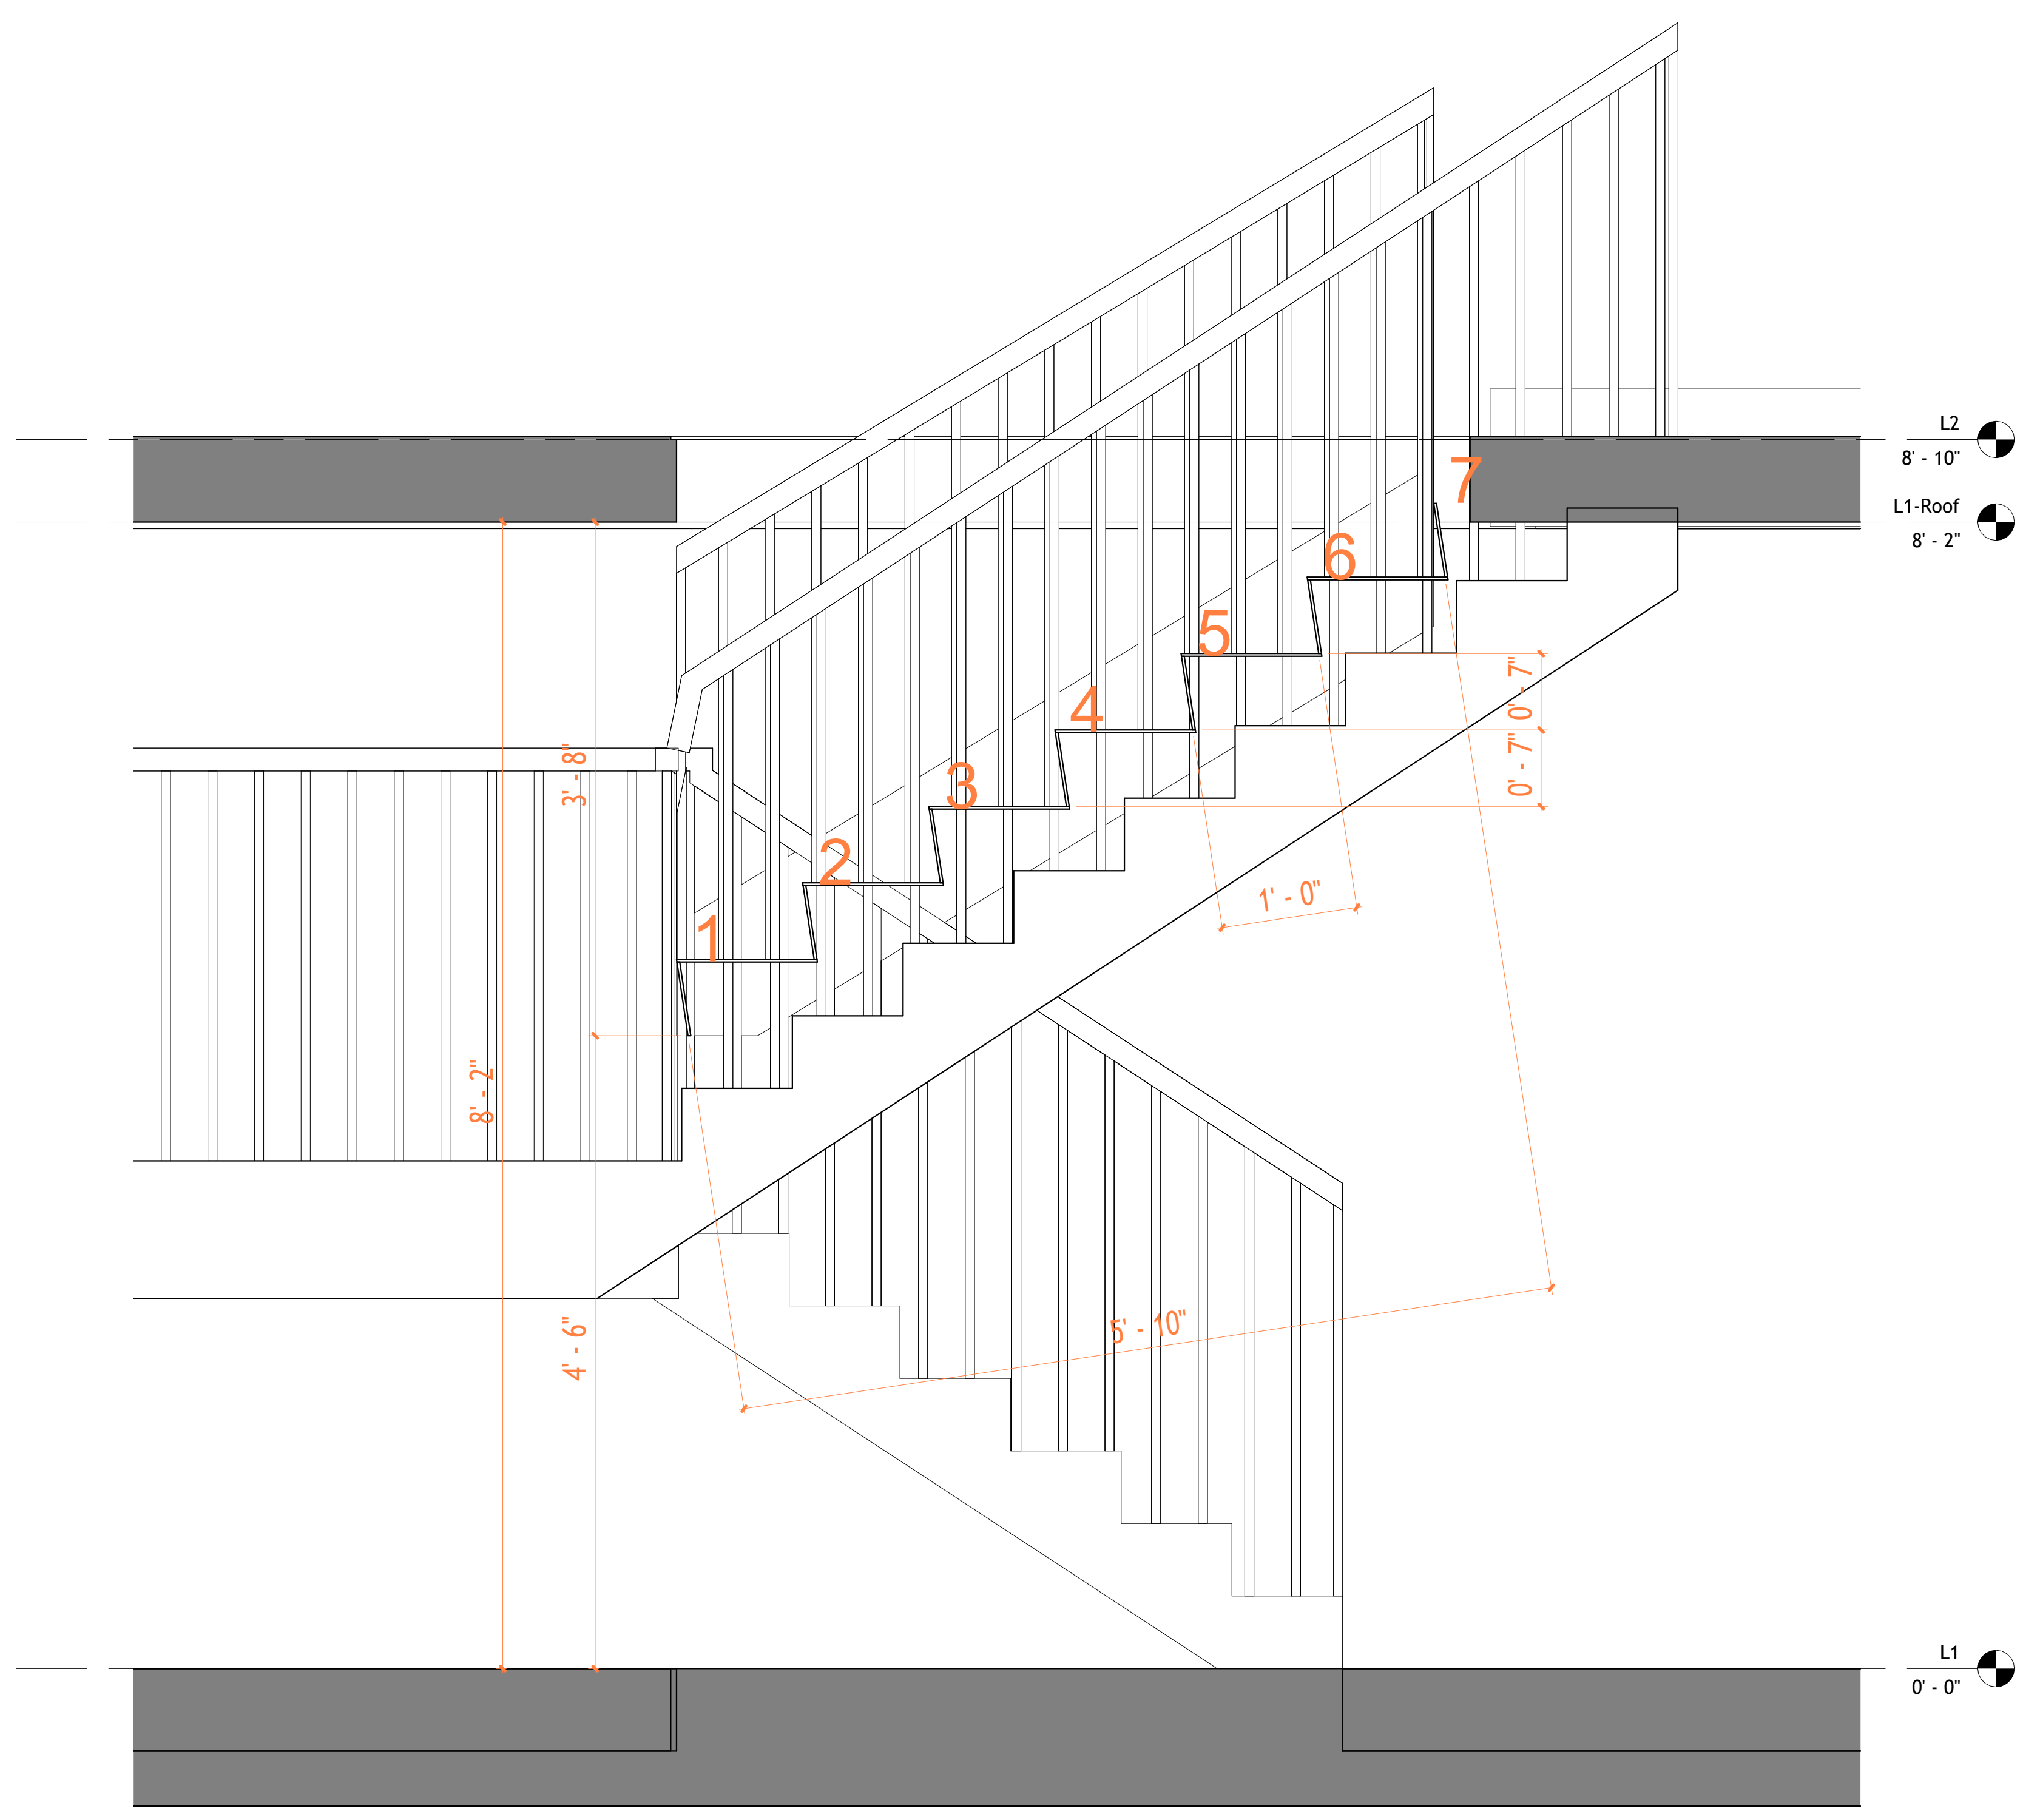

1 Section 5 Copy 1
1 : 10



TECHSCAN
Surveying As Builds and Geospatial Solutions


Project Name	
Architectural Details	
Project number	Project Number
Date	Issue Date
Checked by	Checker
A501	
Scale	1 : 10



18 Spencer St, Brooklyn,
NY 11205
info@techscanusa.com
TechScanusa.com
(929) 486-9031

AS-BUILT DOCUMENTATION 89-19 171st St #6m, Jamaica, NY 11432, USA

1. A1, A2, A3, A4 & A5 THESE DOCUMENTS ARE THE PROPERTY OF THE DESIGNER AND SHALL NOT BE COPIED, DUPLICATED, ALTERED, MODIFIED OR REVISED IN ANY WAY WITHOUT THE WRITTEN APPROVAL OF THE DESIGNER.
2. CONTRACTOR SHALL VERIFY ALL CONDITIONS AND DIMENSIONS AT THE SITE AND ALL INCONSISTENCIES SHALL BE BROUGHT TO THE ATTENTION OF THE DEVELOPER AND THE DESIGNER BEFORE PROCEEDING WITH THE WORK.
3. ANY ERRORS OR OMISSIONS FOUND IN THESE DRAWINGS SHALL BE BROUGHT TO DEVELOPERS AND DESIGNERS ATTENTION IMMEDIATELY.
4. DO NOT SCALE DRAWINGS. WRITTEN DIMENSIONS TAKE PRECEDENCE OVER SCALED DIMENSIONS.
5. ALL DIMENSIONS ARE TO FACE OF STUD OR TO FACE OF FRAMING UNLESS OTHERWISE NOTED.
6. ALL TRUSS DRAWINGS TO BE REVIEWED AND APPROVED BY THE STRUCTURAL ENGINEER PRIOR TO ISSUANCE OF BUILDING PERMIT.
7. ALL OR EQUAL SUBSTITUTIONS MUST BE SUBMITTED TO AND APPROVED BY CITY BUILDING OFFICIAL PRIOR TO INSTALLATION.
8. ALL ELECTRICAL AND MECHANICAL EQUIPMENT AND METERS ARE SUBJECT TO RELOCATION DUE TO FIELD CONDITIONS, CONTRACTOR TO VERIFY.
9. DAMP PROOFING - ONE COAT CONTINUOUS ELASTOMERIC WATERPROOFING FROM GRADE LEVEL TO BOTTOM OF FOUNDATION.
10. SHOP DRAWING REVIEW AND DISTRIBUTION, ALONG WITH PRODUCT SUBMITTALS, REQUESTED IN THE CONSTRUCTION DOCUMENTS, SHALL BE THE SOLE RESPONSIBILITY OF THE GENERAL CONTRACTOR, UNLESS DIRECTED OTHERWISE UNDER A SEPARATE AGREEMENT.
11. DEVIATIONS FROM THESE DOCUMENTS IN THE CONSTRUCTION PHASE SHALL BE REVIEWED BY THE DESIGNER AND THE OWNER PRIOR TO THE START OF WORK IN QUESTION. ANY DEVIATIONS FROM THESE DOCUMENTS WITHOUT PRIOR REVIEW, SHALL BE THE SOLE RESPONSIBILITY OF THE GENERAL CONTRACTOR.
12. THE GENERAL CONTRACTOR SHALL BE RESPONSIBLE FOR ALL WORK AND MATERIALS REPRESENTED ON THESE DOCUMENTS INCLUDING THE WORK AND MATERIALS FURNISHED BY SUBCONTRACTORS AND VENDORS.
13. THE BUILDER SHALL FURNISH ART AND ALL REPORTS RECEIVED FROM THE GEOTECHNICAL ENGINEER (SOILS REPORT), ON THE STUDY OF THE PROPOSED SITE, TO THE DESIGNER, STRUCTURAL ENGINEER, AND GENERAL CONTRACTOR. IN THE EVENT THE GEOTECHNICAL REPORTS DO NOT EXIST, THE SOILS CONDITION SHALL BE ASSUMED TO BE A MINIMUM DESIGN SOIL PRESSURE STATED BY THE STRUCTURAL ENGINEER OF RECORD FOR THE PURPOSE OF STRUCTURAL DESIGN. GENERAL CONTRACTOR SHALL ASSURE THE SOIL CONDITIONS MEET OR EXCEED THE CRITERIA.
14. ALL WORK PERFORMED BY THE GENERAL CONTRACTOR SHALL COMPLY AND CONFORM WITH LOCAL AND STATE BUILDING CODES, ORDINANCES AND REGULATIONS, ALONG WITH ALL OTHER AUTHORITIES HAVING JURISDICTION. THE GENERAL CONTRACTOR IS RESPONSIBLE TO BE AWARE OF THESE REQUIREMENTS AND GOVERNING REGULATIONS.
15. WINDOW SUPPLIER TO VERIFY AT LEAST ONE WINDOW IN ALL BEDROOMS TO HAVE A CLEAR EGRESS OPENING OF 5.7 SQ FT WITH MIN. DIMENSION OF 24" IN HEIGHT AND 20" IN WIDTH.

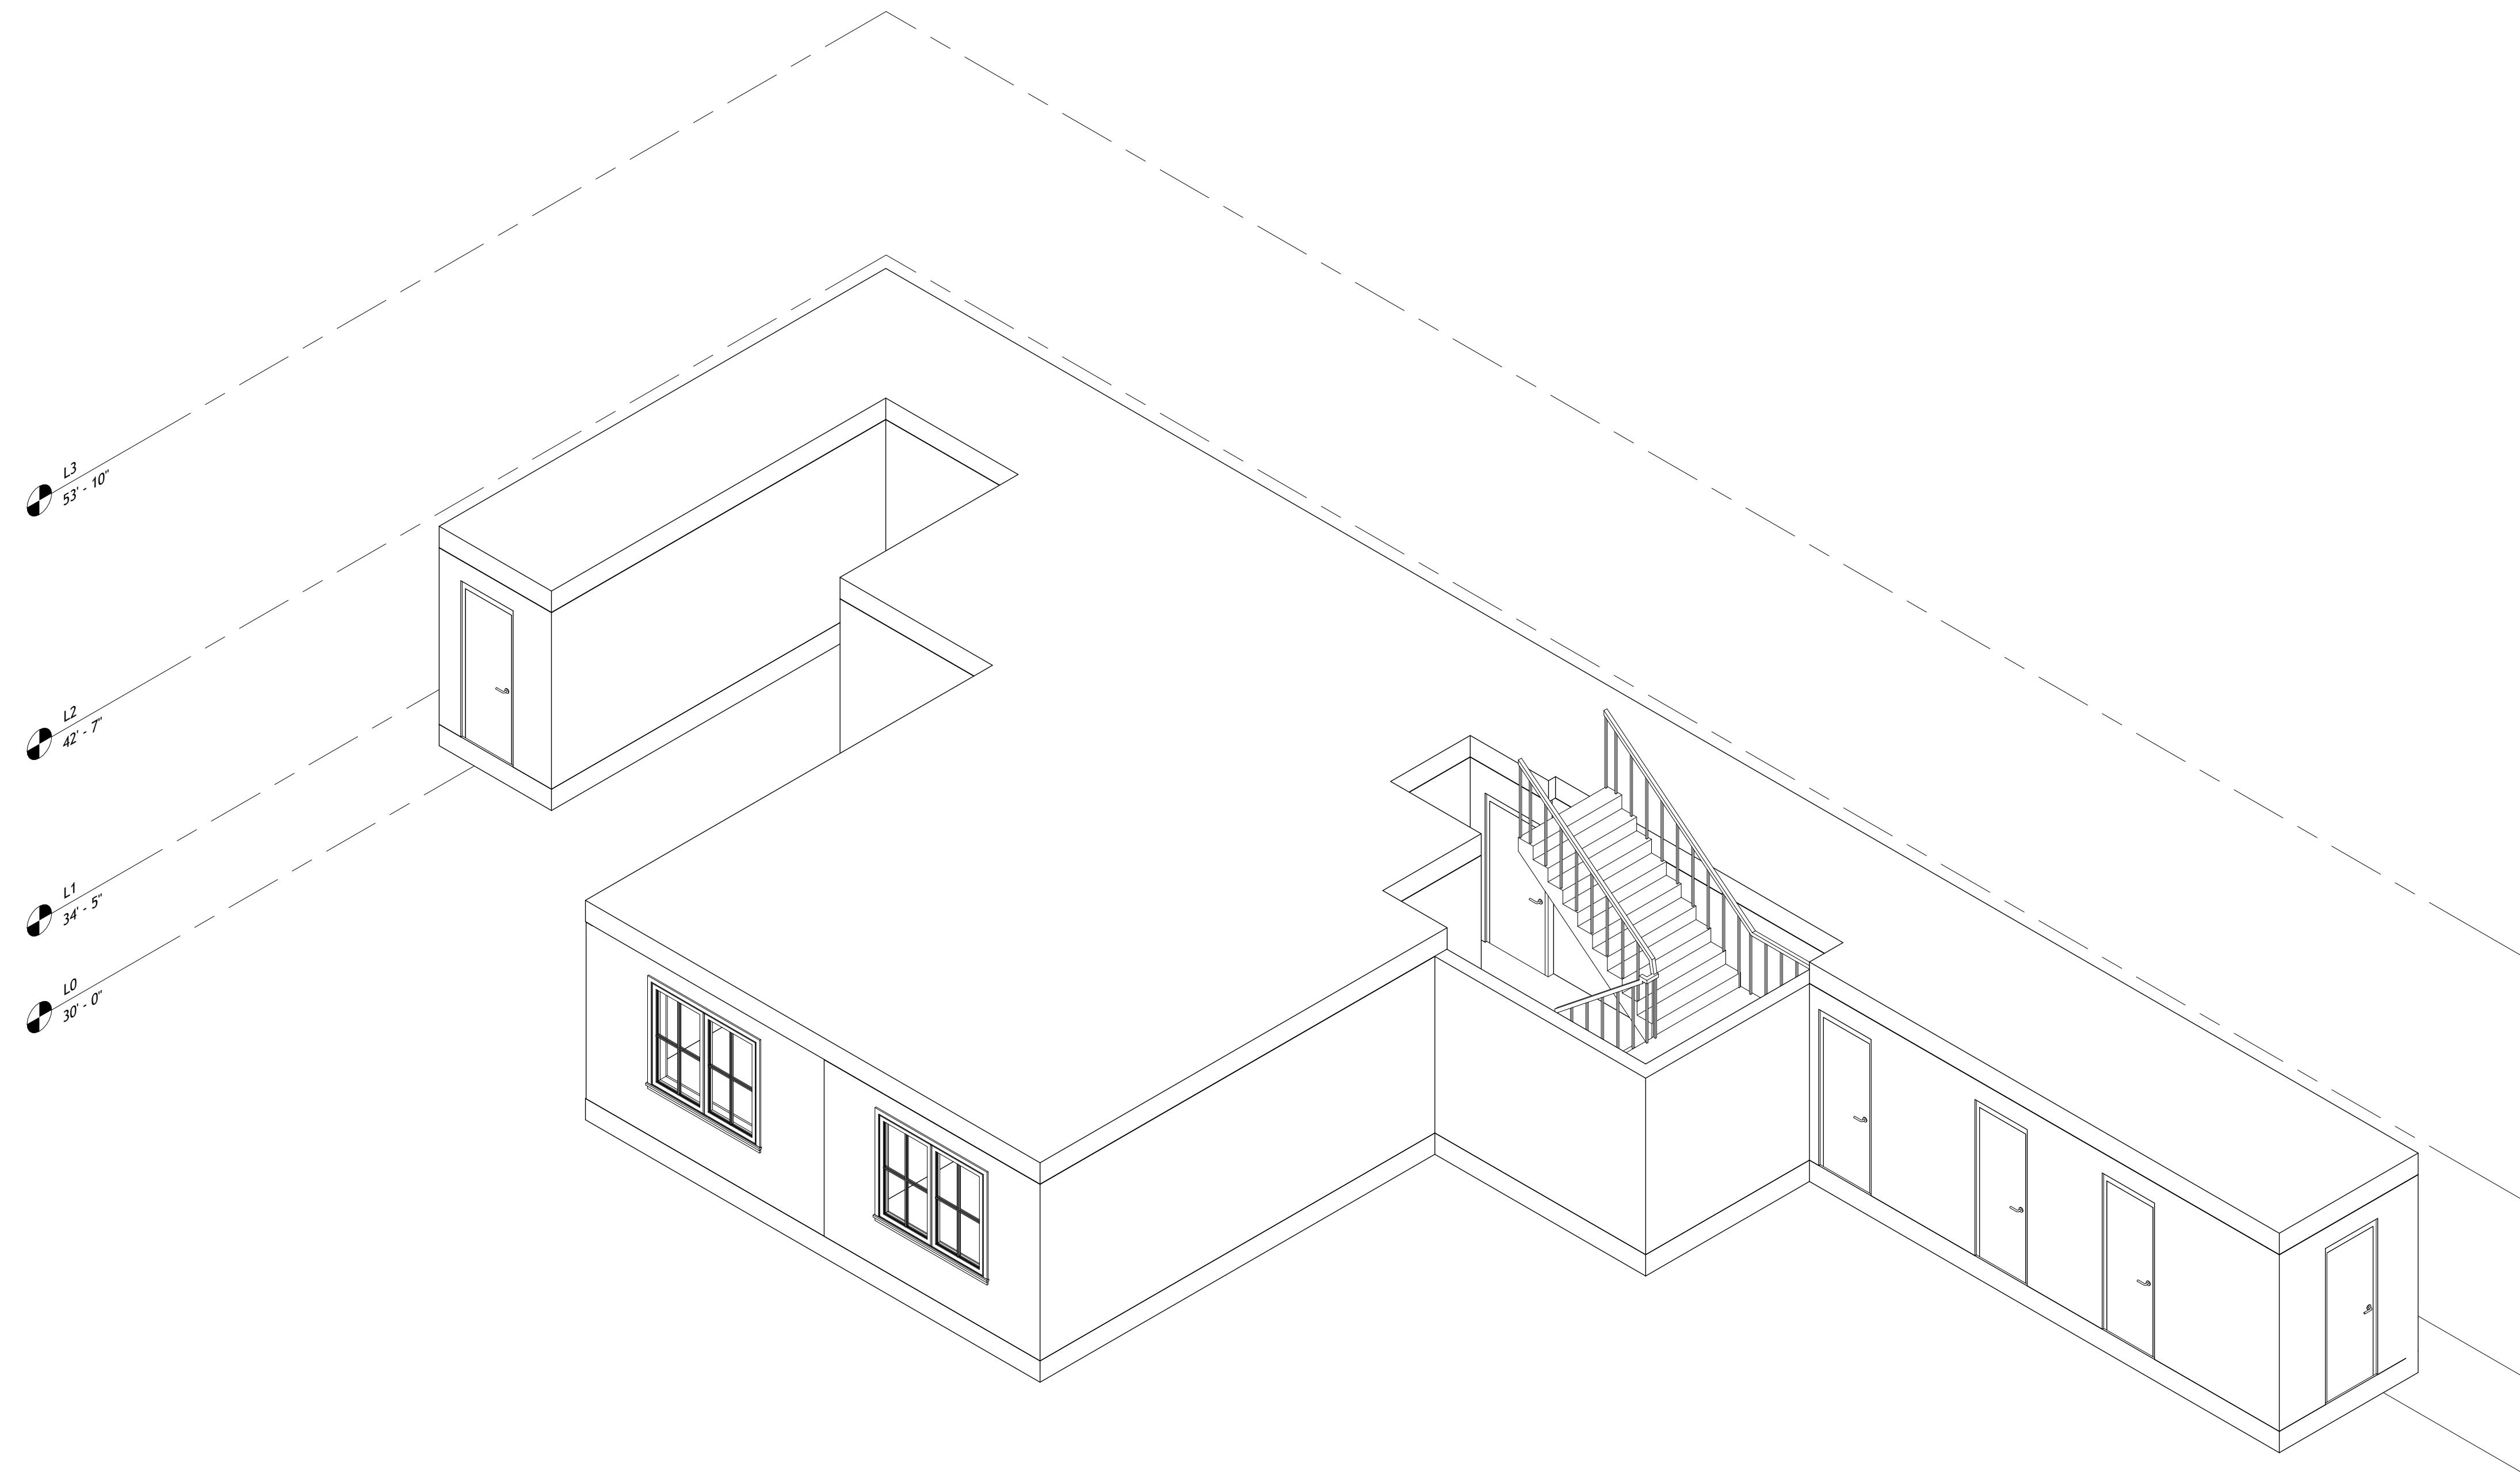


Working Sheet List			
Sheet Number	Sheet Name	Sheet Sort	Sheet Group
A000	Cover	000	General
A001	Cover	000	General
A101	Architectural Floor Plans	070	Architectural
A102	Architectural Floor Plans	070	Architectural
A201	Architectural Building Elevations	070	Architectural
A202	Architectural Building Elevations	070	Architectural
A203	Architectural Building Elevations	070	Architectural
A204	Architectural Building Elevations	070	Architectural
A301	Architectural Building Sections	070	Architectural
A302	Architectural Building Sections	070	Architectural
A401	Architectural Enlarged Views	070	Architectural
A402	Architectural Enlarged Views	070	Architectural
A403	Architectural Enlarged Views	070	Architectural
A601	Architectural RCP Plans	070	Architectural

Level Schedule					
Name	Elevation Base	Elevation	Structural	Story Above	Workset
L0	Project Base Point	30'-0"	No	Default	
L1	Project Base Point	34'-5"	No	Default	
L2	Project Base Point	42'-7"	No	Default	
L3	Project Base Point	53'-10"	No	Default	

Room Finish Schedule					
Room Number	Room Name	Area	Level	Count	Comments
100	Room	Not Placed	Not Placed	1	
101	Room	Not Placed	Not Placed	1	
102	Room	Not Placed	Not Placed	1	
103	Kitchen	Not Placed	Not Placed	1	
104	Garage	Not Placed	Not Placed	1	
105	Social area	Not Placed	Not Placed	1	
106	Bathroom	Not Placed	Not Placed	1	
107	Bathroom	Not Placed	Not Placed	1	
108	Room	Not Placed	Not Placed	1	
109	Circulation	493 ft ²	L1	1	
110	Kitchen	66 ft ²	L1	1	
111	Living Room	358 ft ²	L1	1	
112	Bed Room	182 ft ²	L1	1	
113	Circulation	159 ft ²	L1	1	
114	Bathroom	35 ft ²	L1	1	
115	Storage	21 ft ²	L1	1	
116	Storage	19 ft ²	L1	1	

1 COVER 3D

Site views

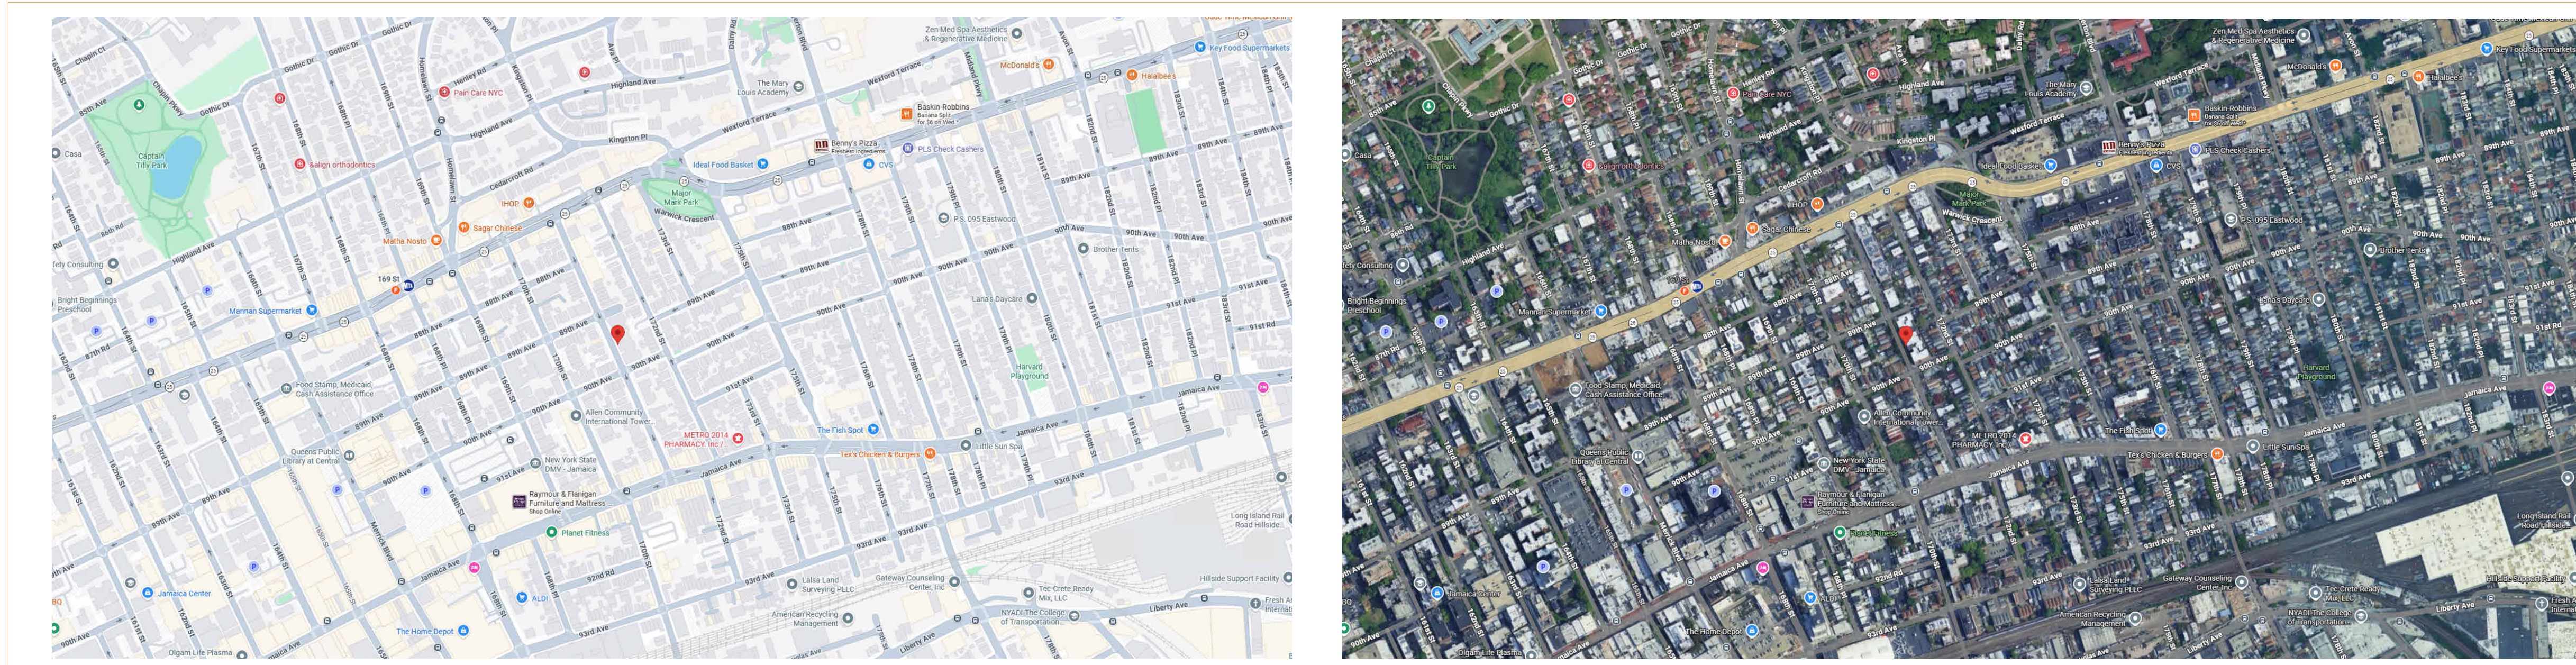

TECHSCAN
Surveying As Builds and Geospatial Solutions

89-19 171st St #6m

Cover

Project number 001

Date Issue Date

Checked by Checker

A000



Scale



18 Spencer St, Brooklyn,
NY 11205
info@techscanusa.com
TechScanusa.com
(929) 486 9091



TECHSCAN
 Surveying As Builds and Geospatial Solutions

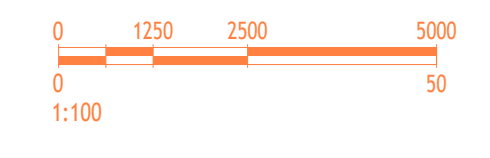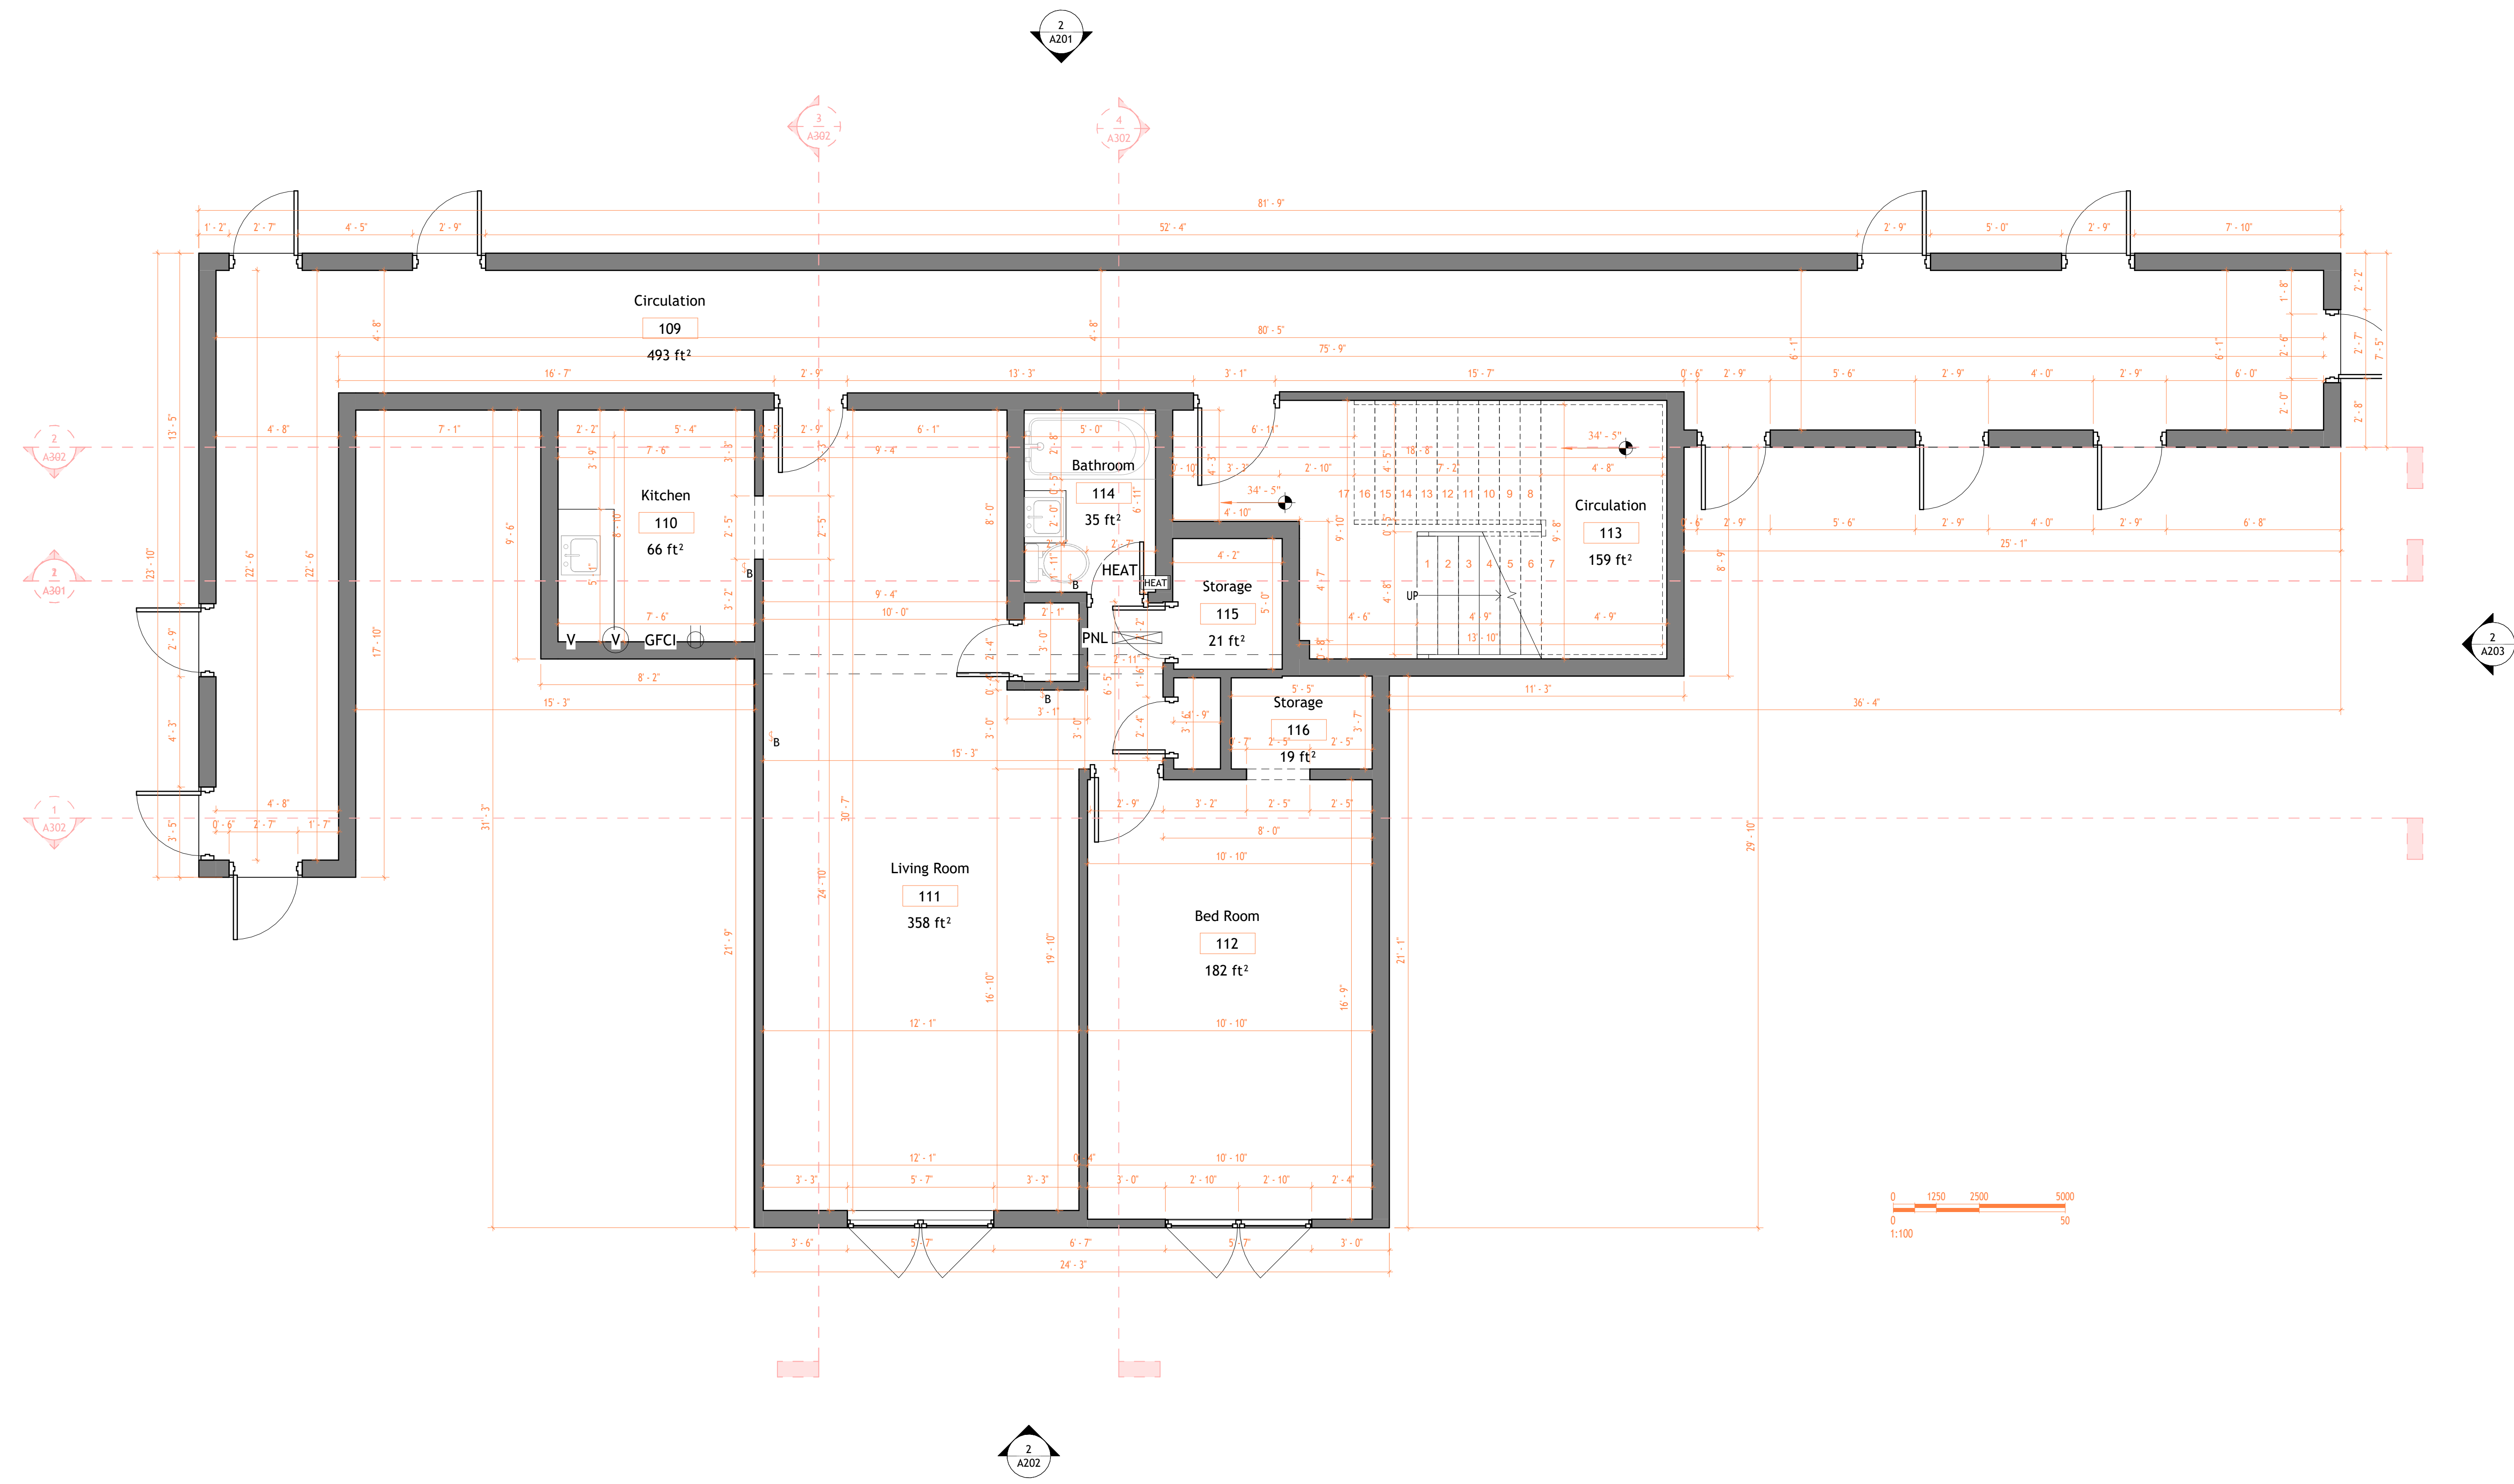

1 First Floor Architectural
 Plan
 1 : 40

Door Schedule				
Mark	Door			Hardware
	Width	Height	Thickness	
117	2'-6"	6'-11"	0'-2"	109
118	2'-11"	6'-7"	0'-2"	109
119	2'-6"	6'-11"	0'-2"	109
120	2'-6"	6'-11"	0'-2"	109
121	2'-6"	6'-11"	0'-2"	109
122	2'-6"	6'-11"	0'-2"	109
123	2'-6"	6'-11"	0'-2"	109
124	2'-6"	6'-11"	0'-2"	109
125	2'-6"	6'-11"	0'-2"	109
126	2'-6"	6'-11"	0'-2"	109
127	2'-6"	6'-11"	0'-2"	109
128	2'-6"	6'-11"	0'-2"	109
129	2'-6"	6'-11"	0'-2"	109
130	2'-0"	6'-11"	0'-2"	111
131	2'-6"	6'-11"	0'-2"	111
132	2'-0"	6'-11"	0'-2"	115
133	2'-0"	6'-11"	0'-2"	111
134	2'-0"	6'-11"	0'-2"	111
135	0'-0"	0'-0"	0'-0"	111
136	0'-0"	0'-0"	0'-0"	116

Window Schedule				
Type Mark	Size		Head Height	Comments
	Width	Height		
25	5'-7"	4'-9"	7'-2"	
26	5'-7"	4'-9"	7'-2"	

89-19 171st St #6m

Architectural Floor Plans

Project number 001

Date Issue Date


Checked by Checker

A101


Scale 1 : 40



18 Spencer St, Brooklyn,
 NY 11205
 info@TechScanusa.com
 TechScanusa.com
 (929) 486 9091

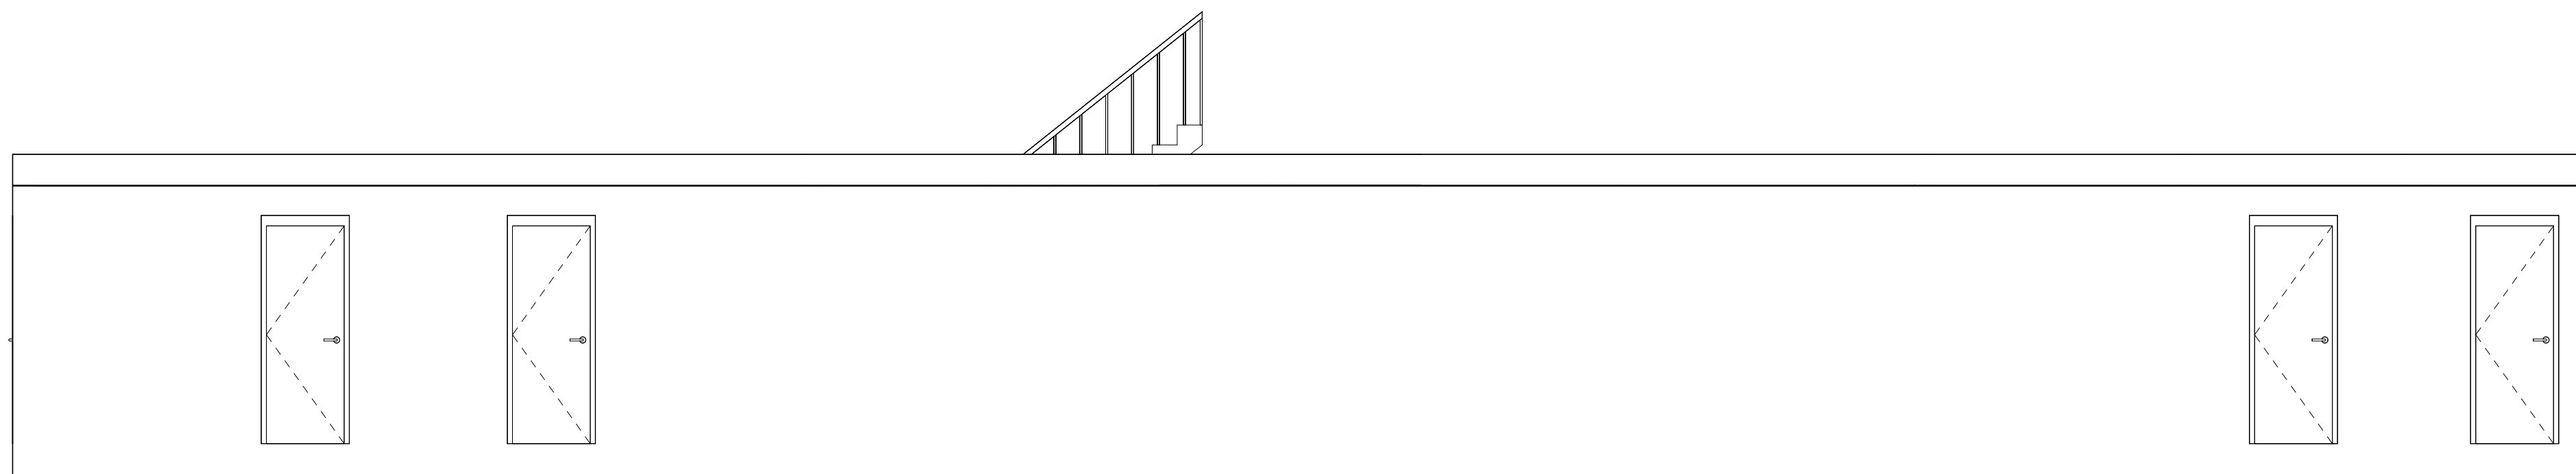

② North Architectural Building
Elevation
1:50

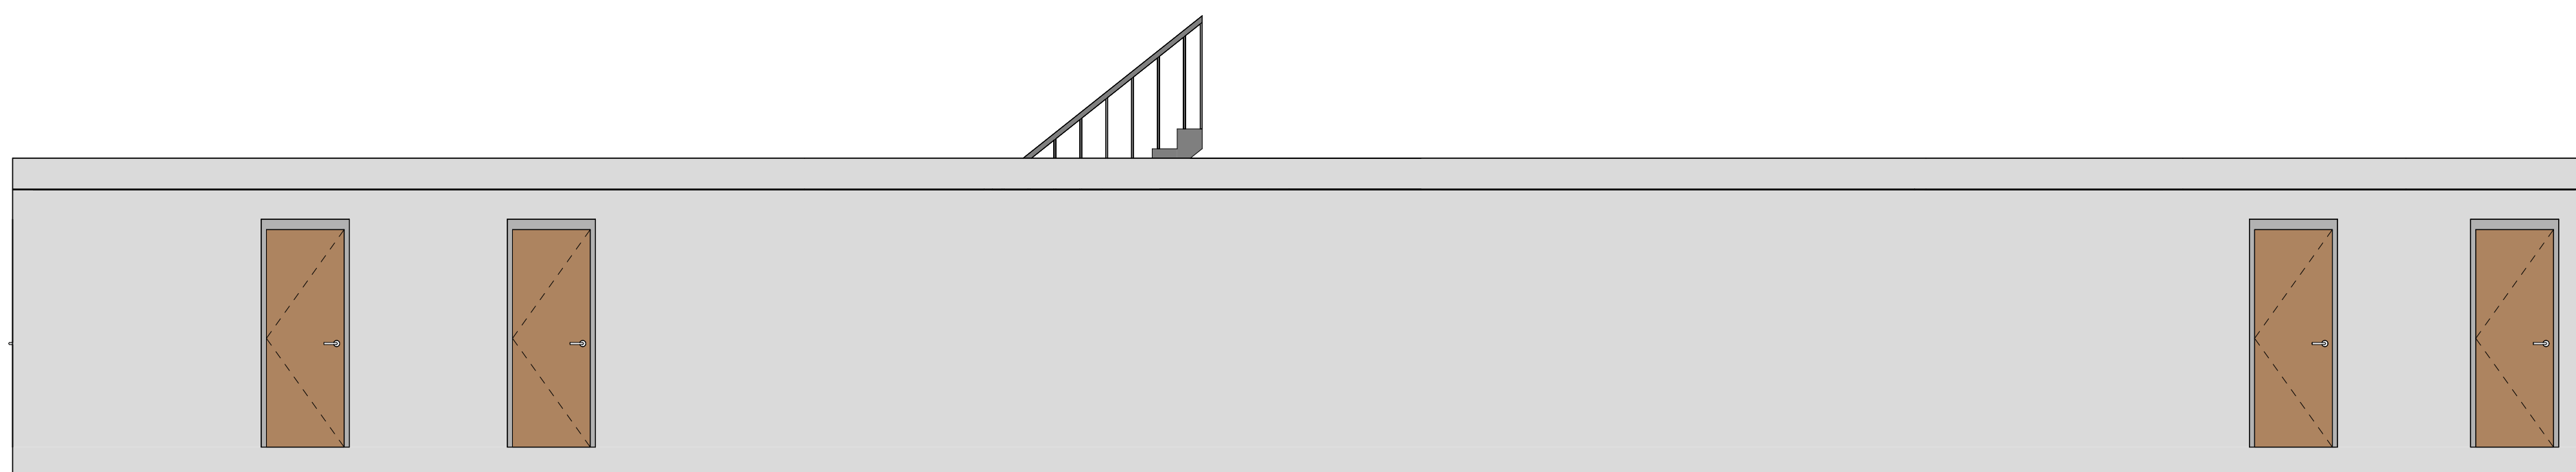

① North Architectural Building
Elevation
1:50



TECHSCAN
Surveying As Builds and Geospatial Solutions

89-19 171st St #6m

Architectural Building
Elevations

Project number 001

Date Issue Date


Checked by Checker

A201


Scale 1 : 50



18 Spencer St, Brooklyn,
NY 11205
info@TechScanusa.com
TechScanusa.com
(929) 486 9091

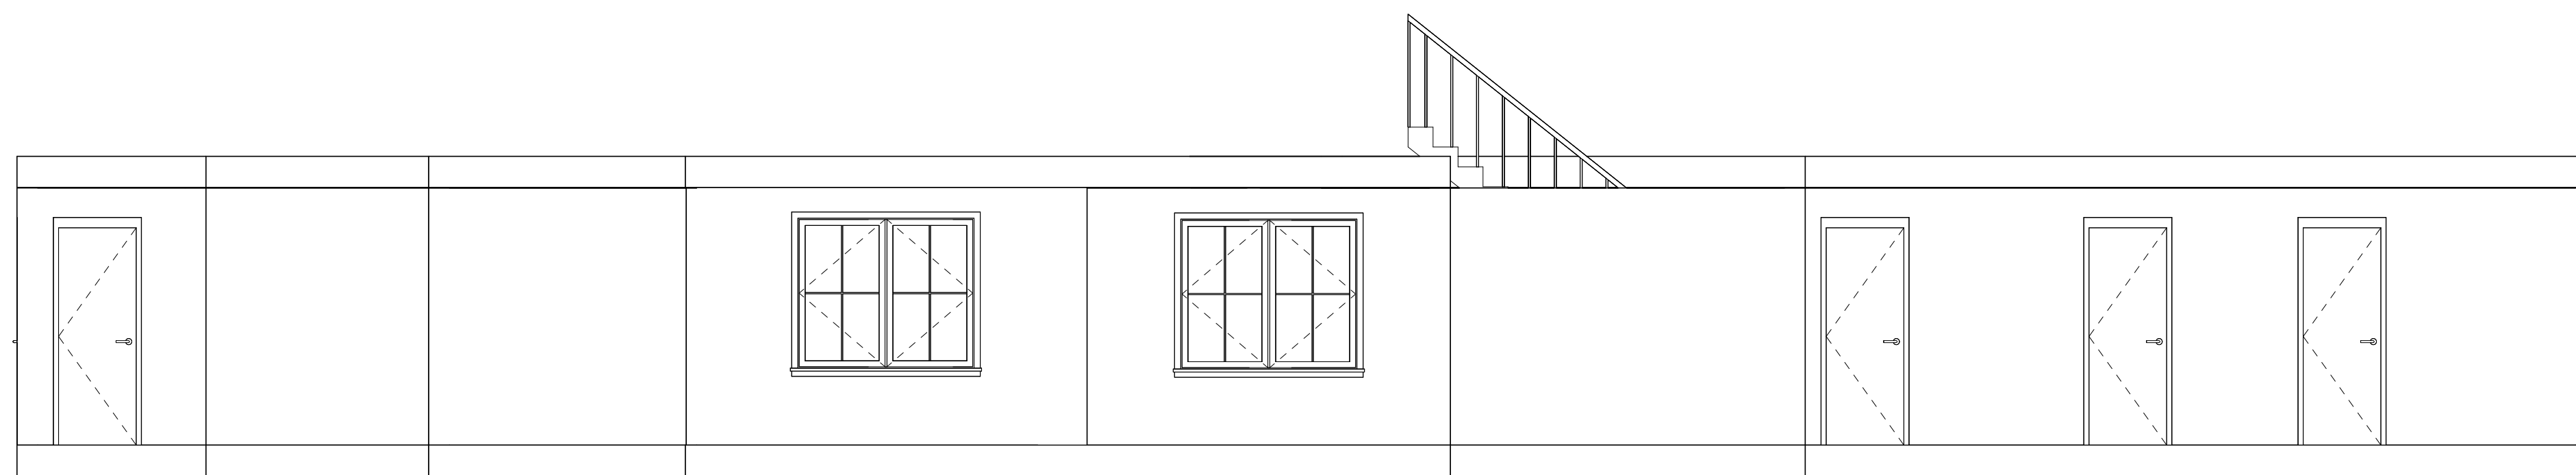

2 South Architectural Building
Elevation
1:50

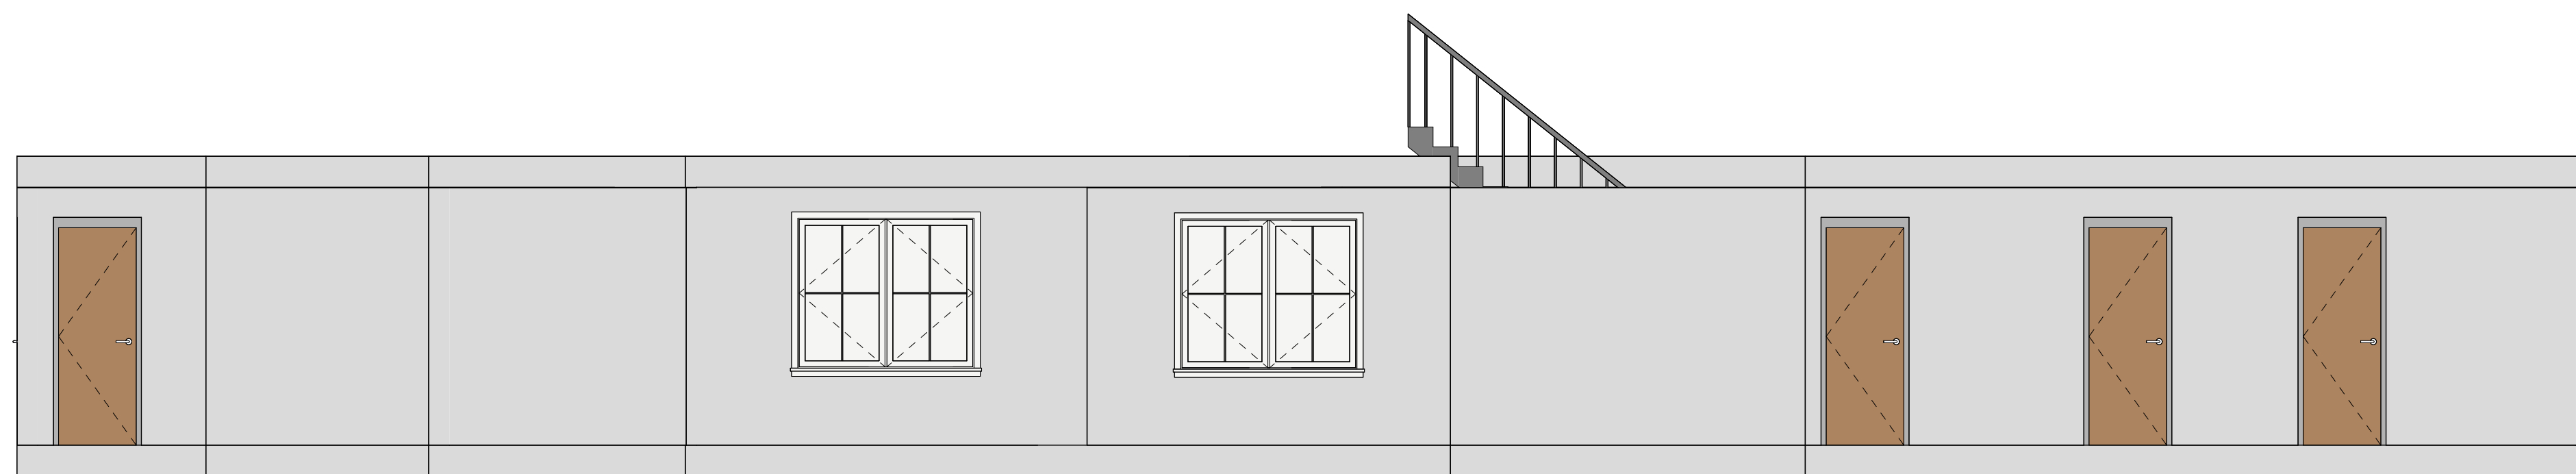

1 South Architectural Building
Elevation
1:50



TECHSCAN
Surveying As Builds and Geospatial Solutions

89-19 171st St #6m

Architectural Building
Elevations

Project number 001

Date Issue Date

Checked by Checker

A202

Scale 1 : 50




18 Spencer St, Brooklyn,
NY 11205


info@TechScanusa.com

TechScanusa.com

(929) 486 9091

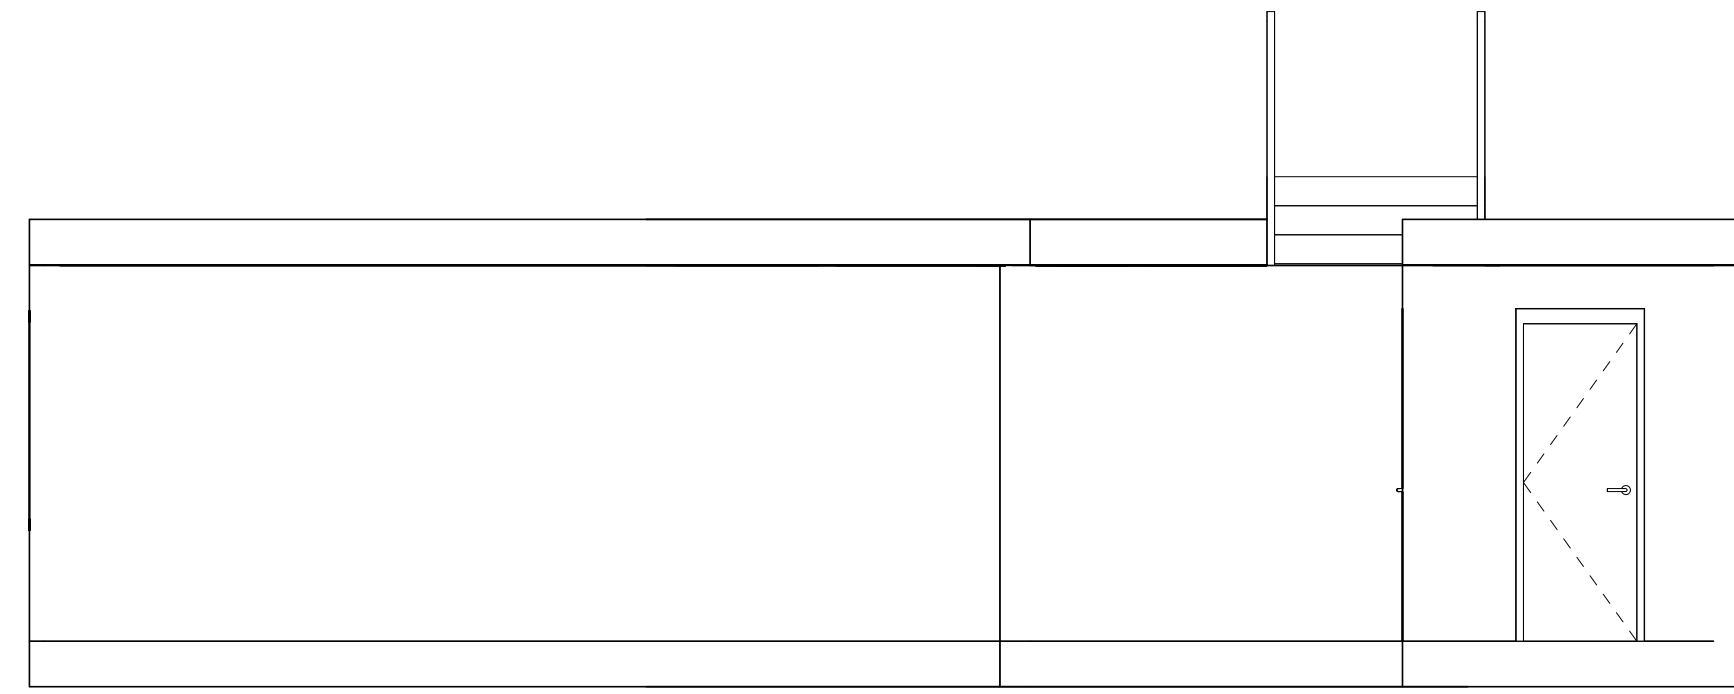

2 East Architectural Building
Elevation
1:50

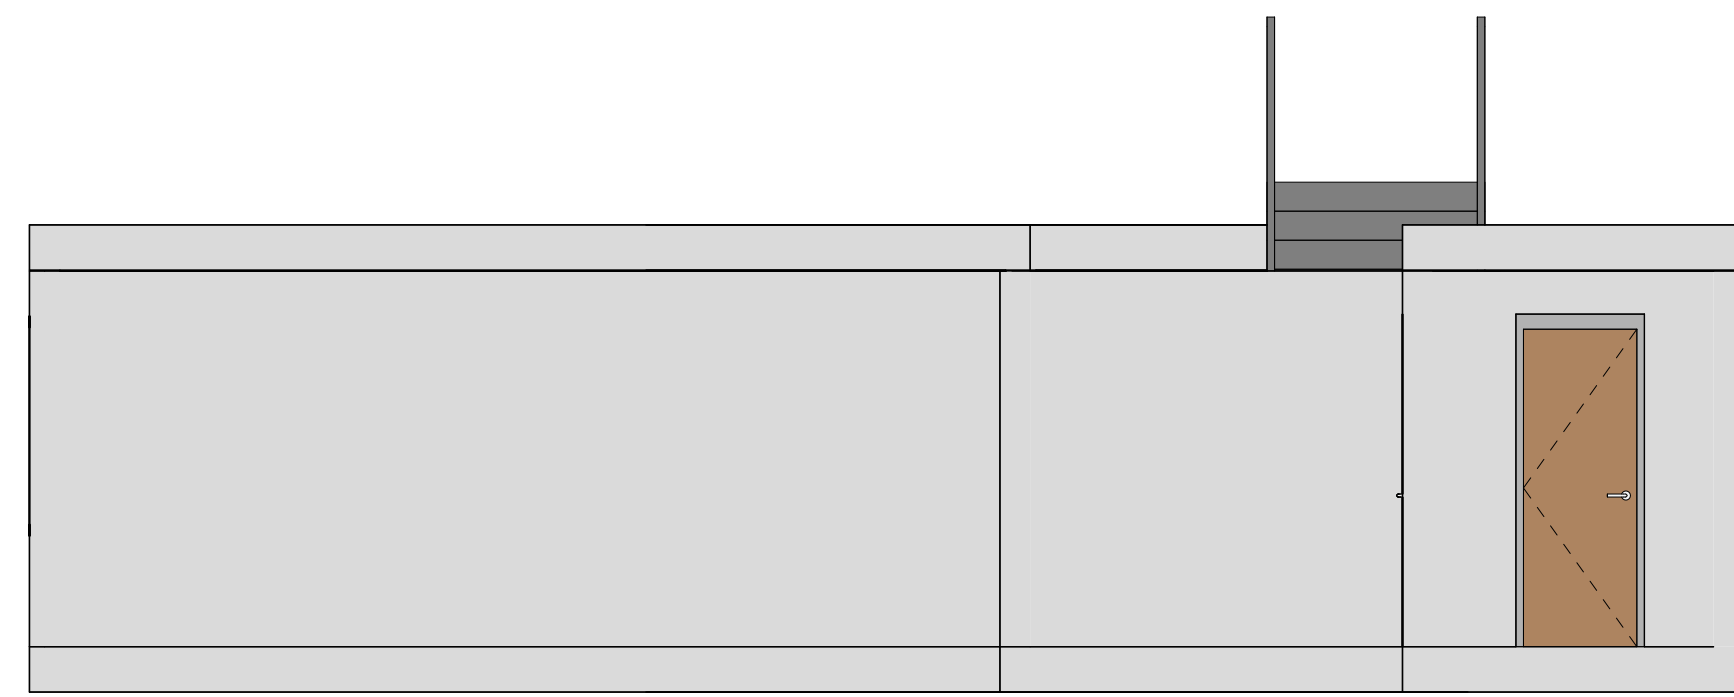

1 East Architectural Building
Elevation
1:50



TECHSCAN
Surveying As Builds and Geospatial Solutions

89-19 171st St #6m

Architectural Building
Elevations

Project number 001

Date Issue Date

Checked by Checker

A203

Scale 1 : 50




18 Spencer St, Brooklyn,
NY 11205


info@TechScanusa.com

TechScanusa.com

(929) 486 9091

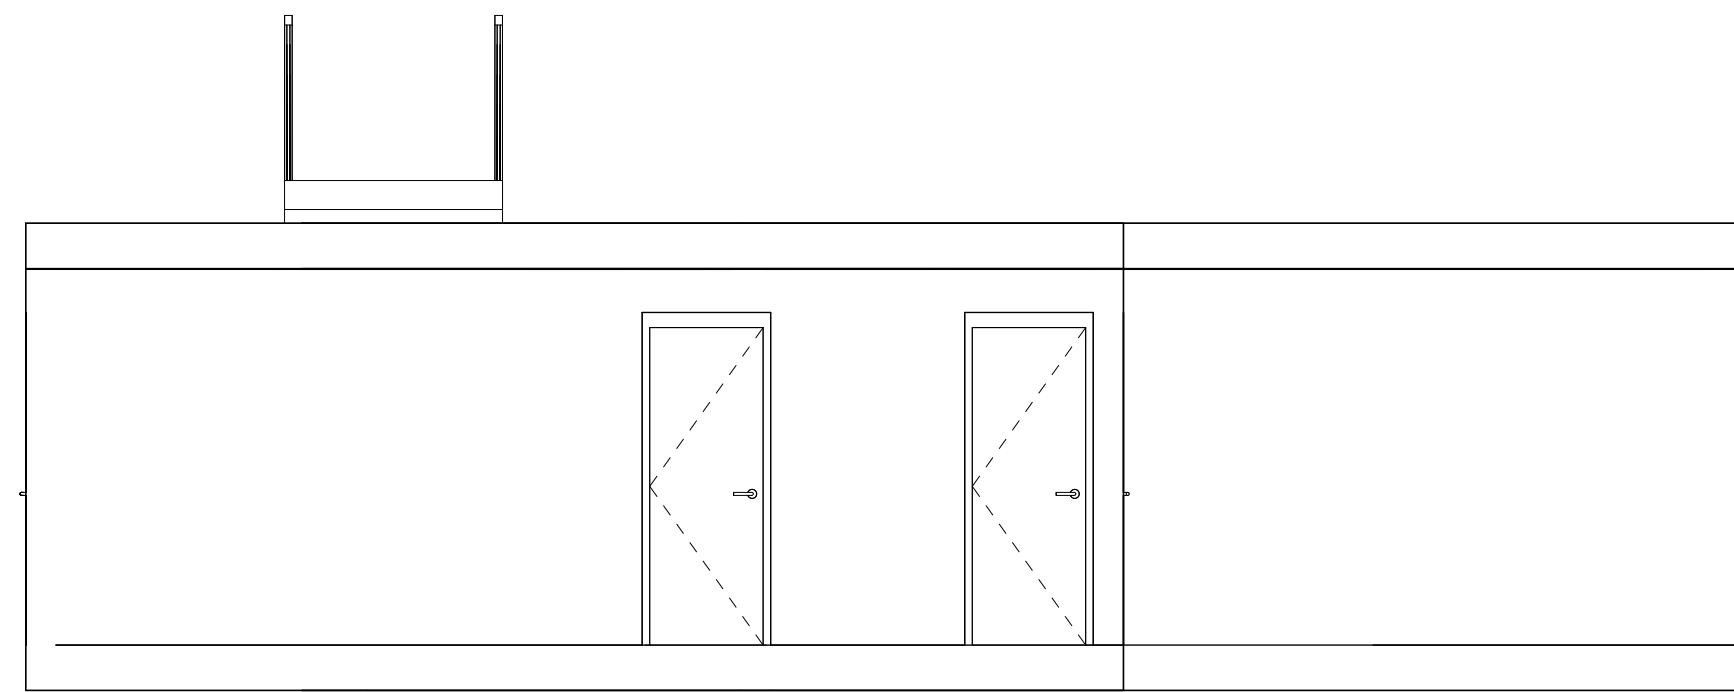

② West Architectural Building
Elevation
1:50

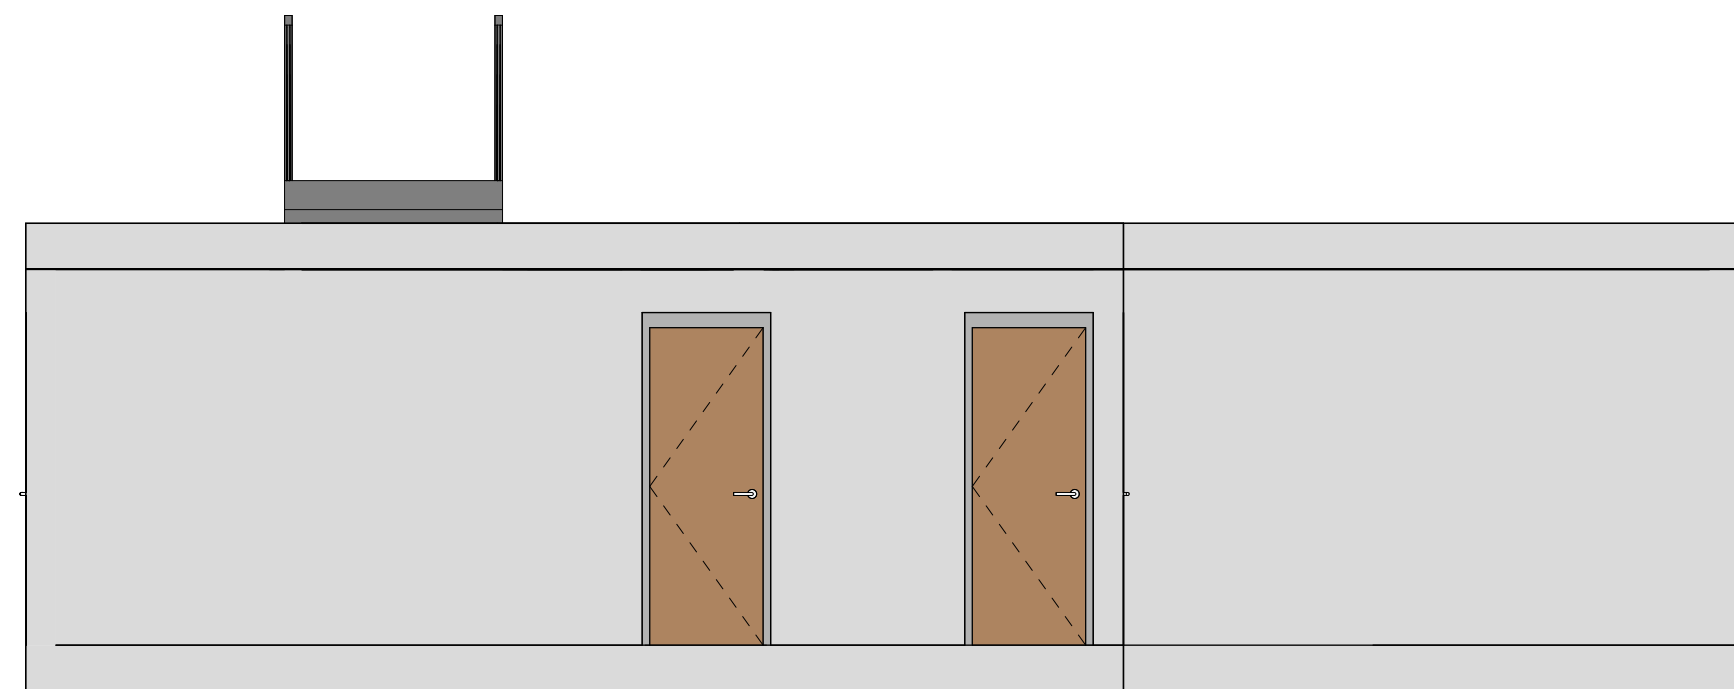

① West Architectural Building
Elevation
1:50



TECHSCAN
Surveying As Builds and Geospatial Solutions

89-19 171st St #6m

Architectural Building
Elevations

Project number 001

Date Issue Date

Checked by Checker

A204

Scale 1 : 50




18 Spencer St, Brooklyn,
NY 11205


info@TechScanusa.com

TechScanusa.com

(929) 486 9091

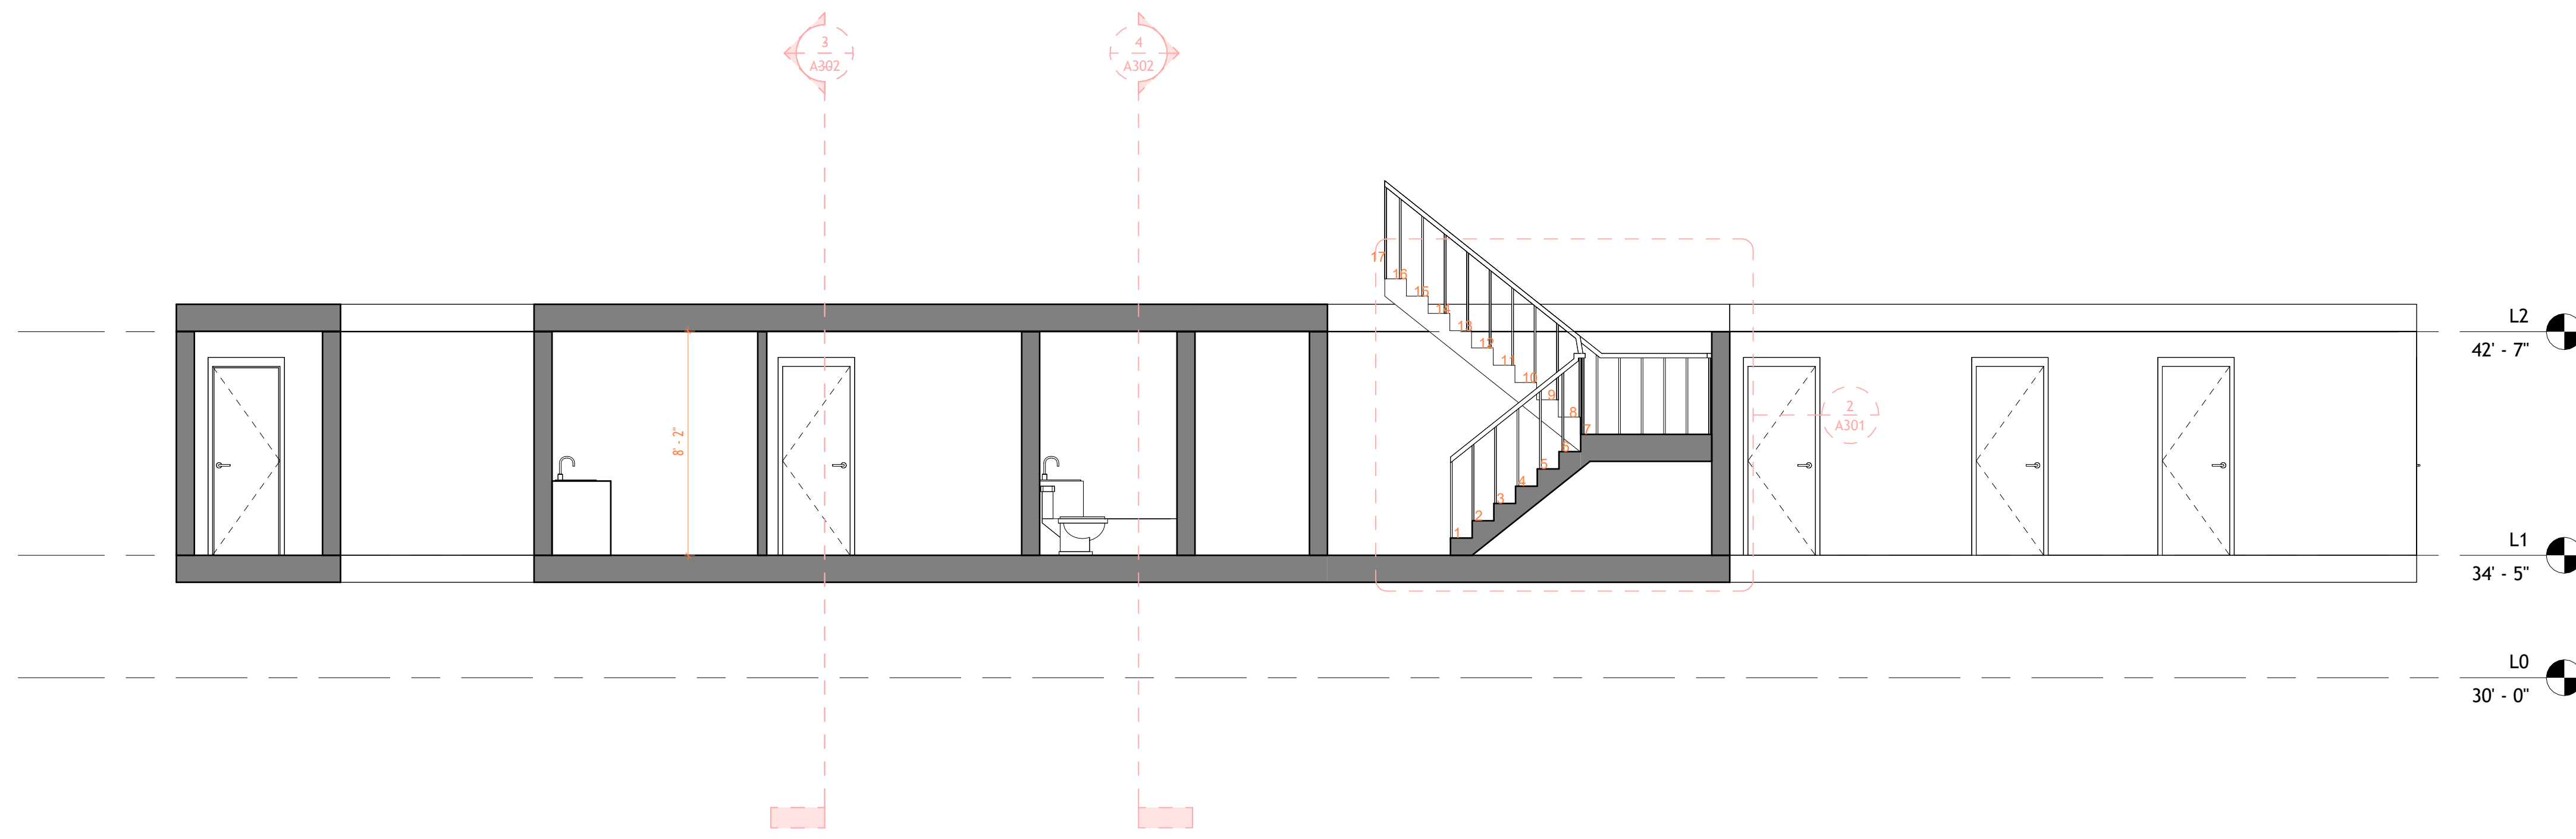

1 Section 1
1 : 50

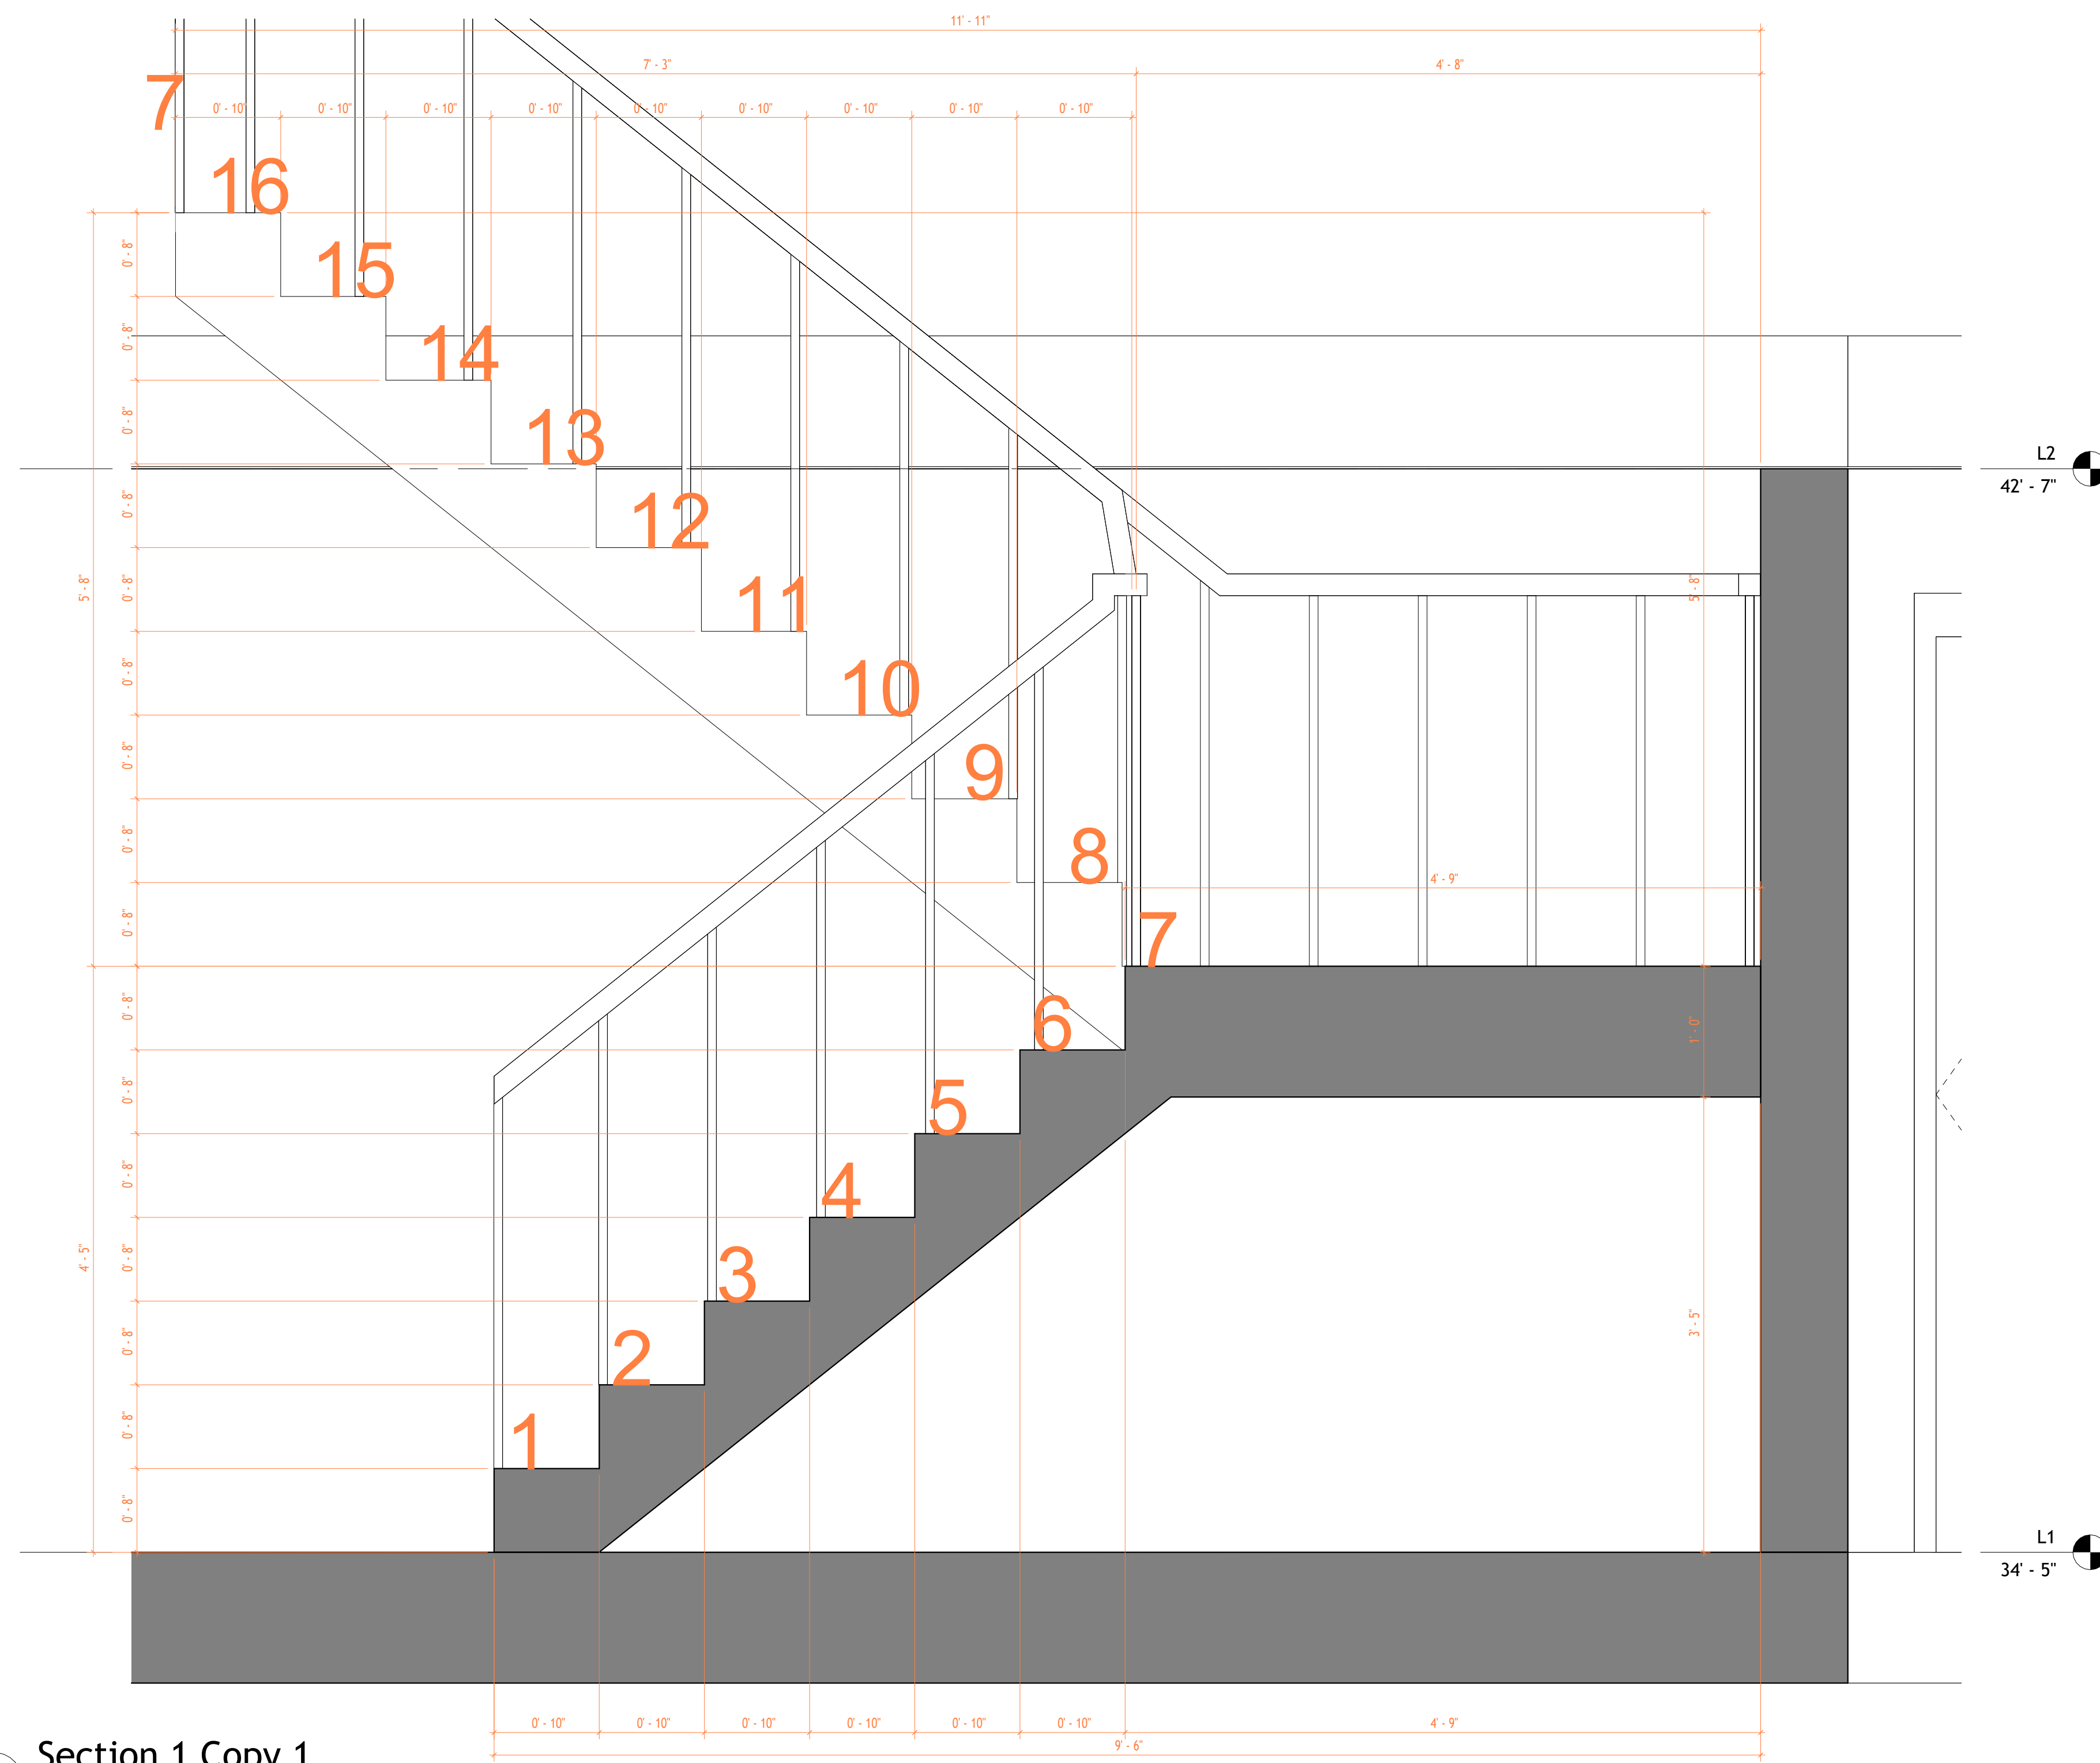

2 Section 1 Copy 1
1 : 10



TECHSCAN
Surveying As Builds and Geospatial Solutions

89-19 171st St #6m

Architectural Building Sections

Project number 001

Date Issue Date

Checked by Checker

A301

Scale As indicated




18 Spencer St, Brooklyn,
NY 11205


info@TechScanusa.com

TechScanusa.com


(929) 486 9091

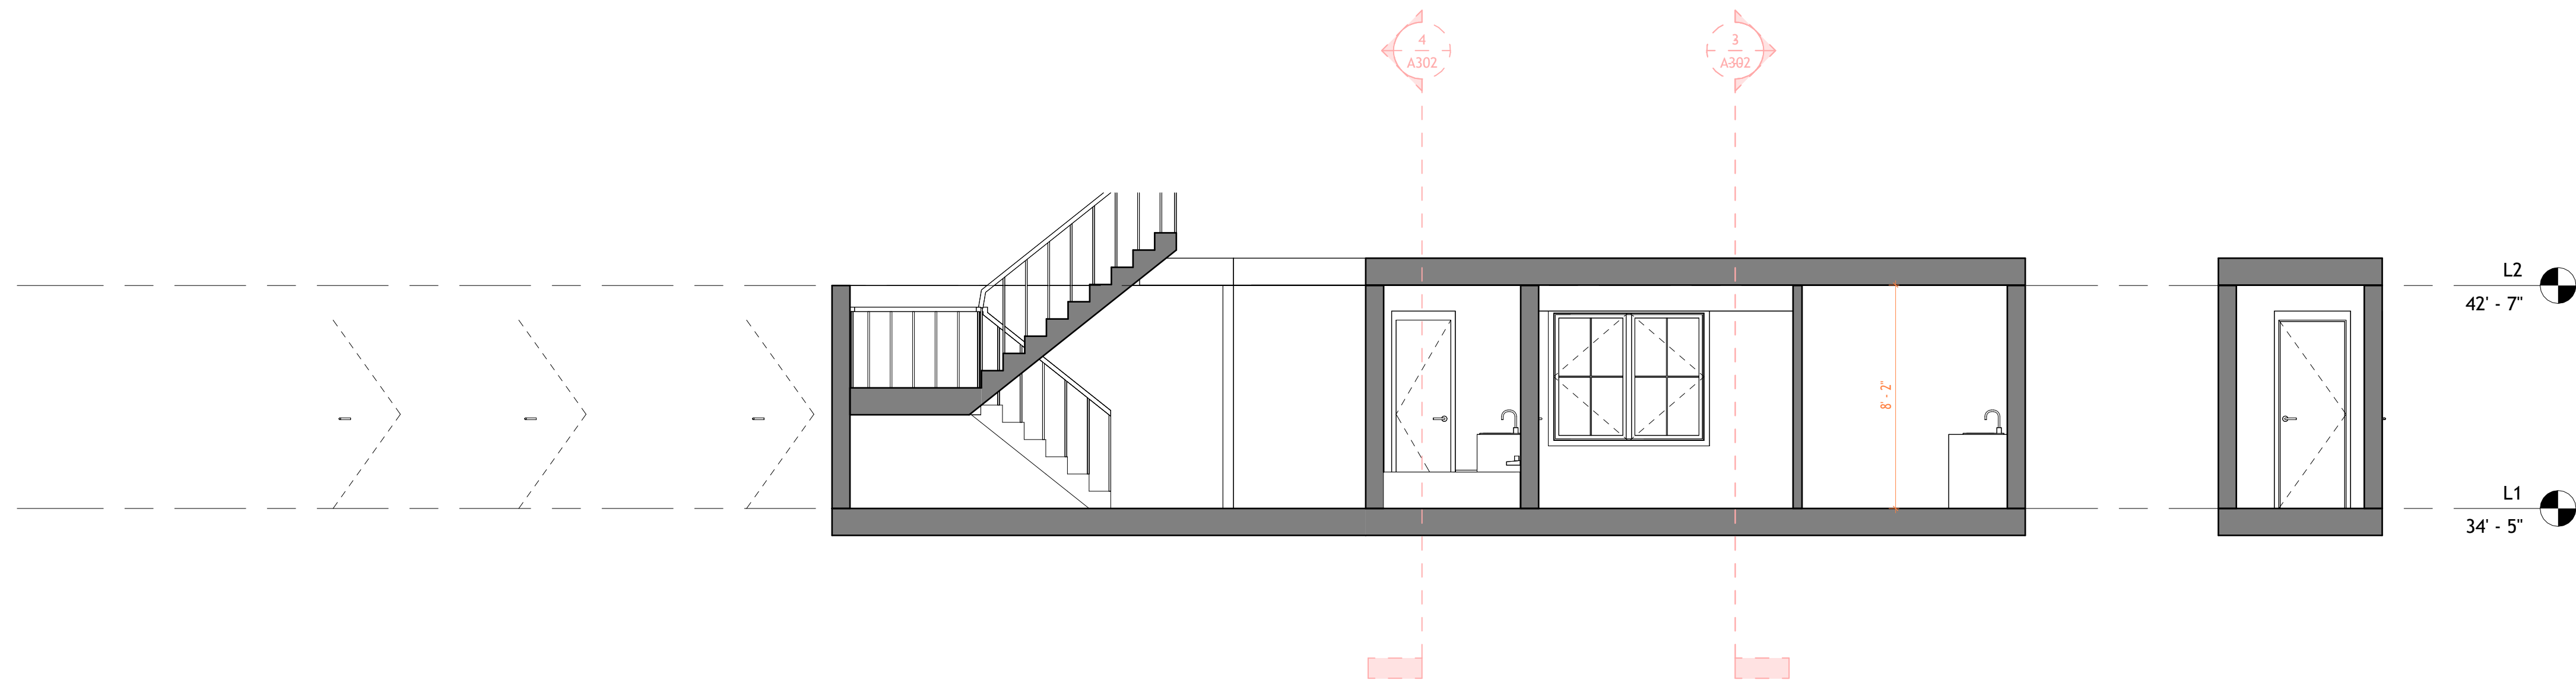

2 Section 1 Copy 2
1 : 50

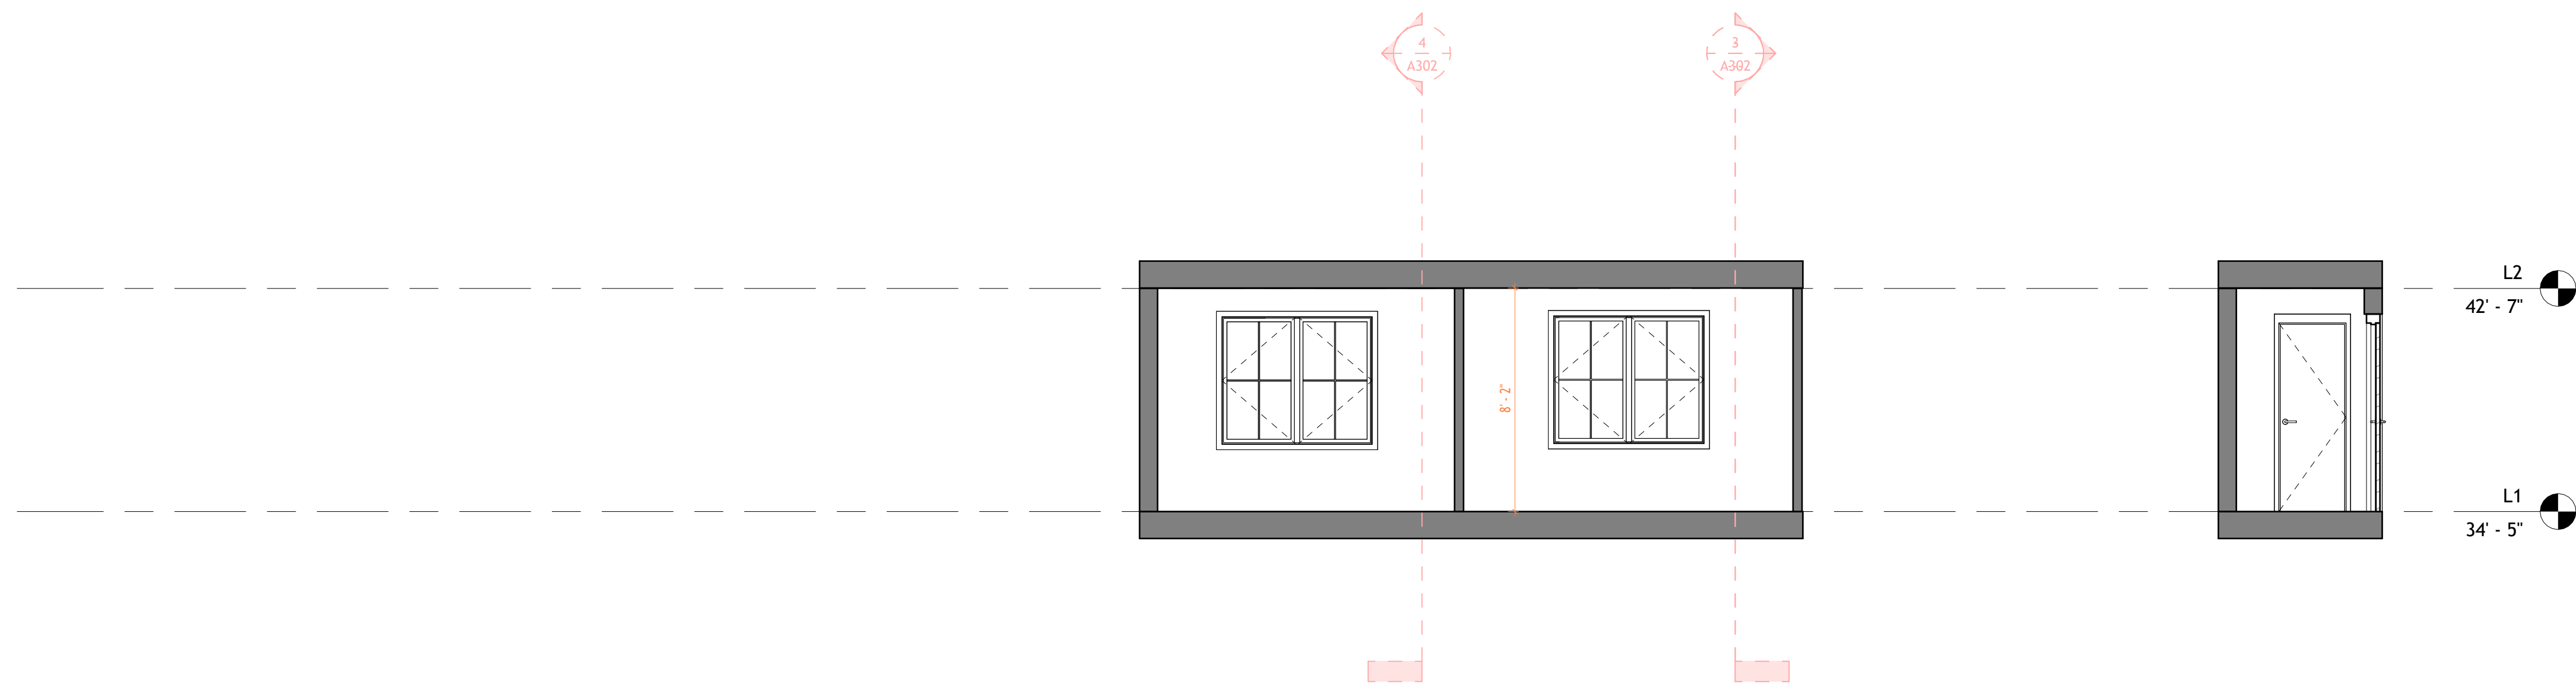

1 Section 1 Copy 3
1 : 50

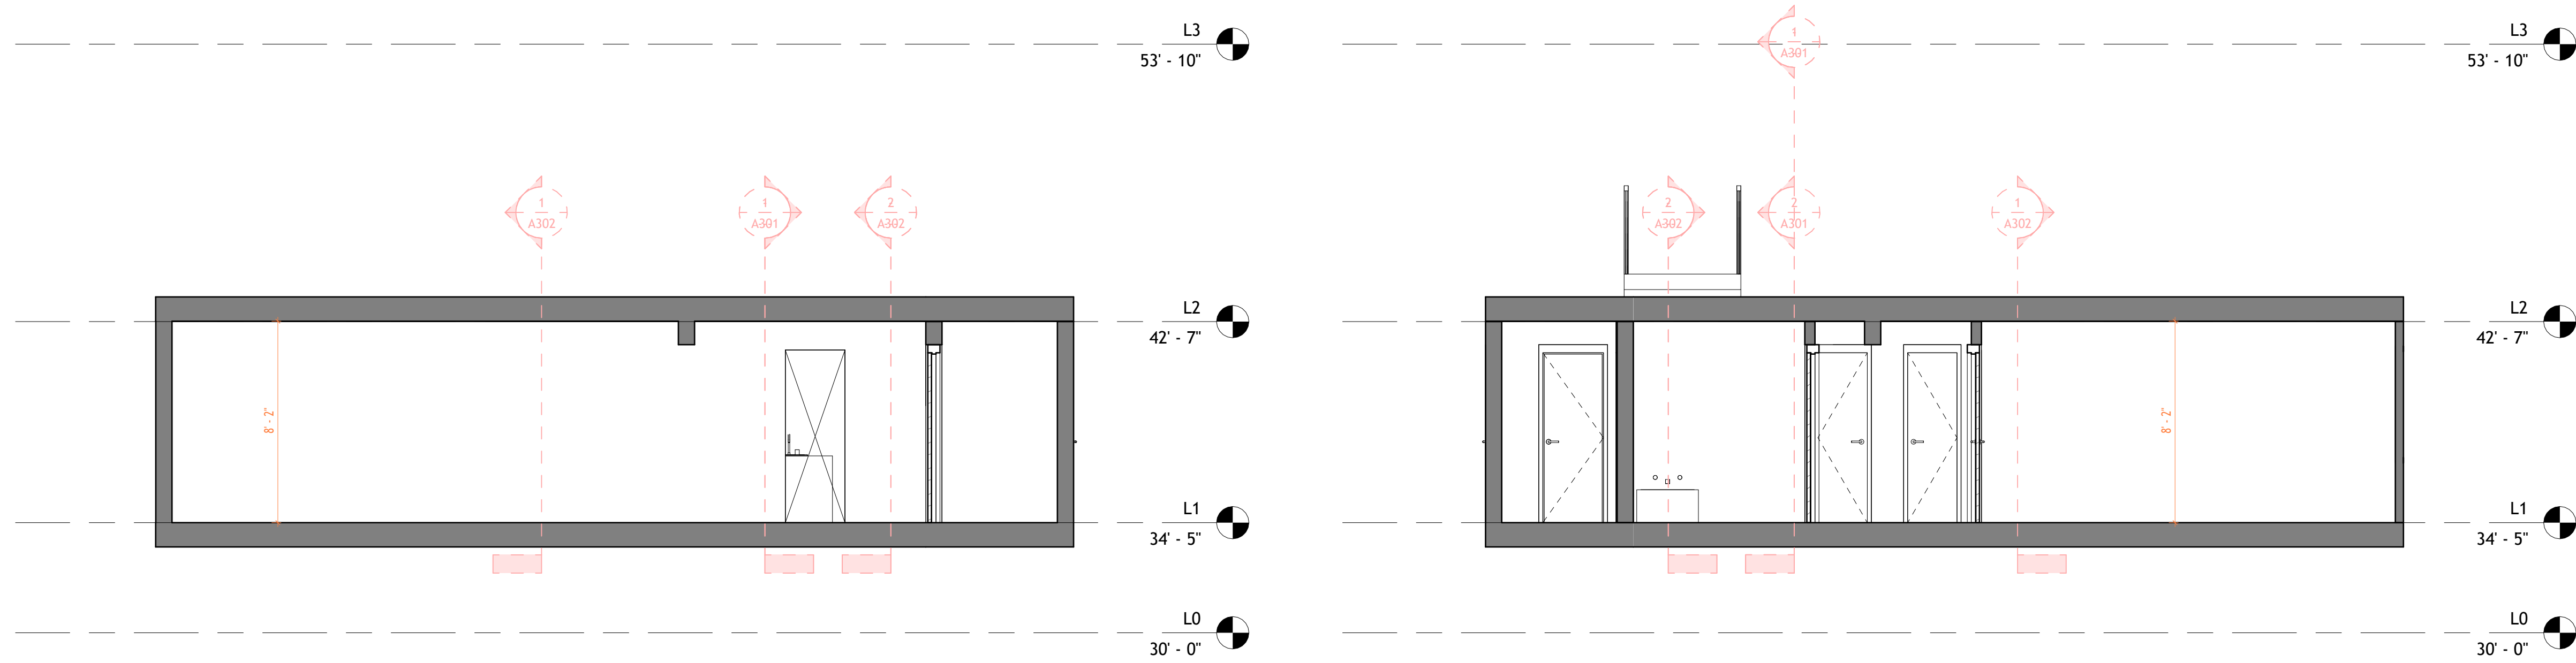

3 Section 2
1 : 50

4 Section 3
1 : 50



TECHSCAN
Surveying As Builds and Geospatial Solutions

89-19 171st St #6m

Architectural Building Sections

Project number 001

Date Issue Date

Checked by Checker

A302

Scale 1 : 50




18 Spencer St, Brooklyn,
NY 11205

info@TechScanusa.com

TechScanusa.com

(929) 486 9091

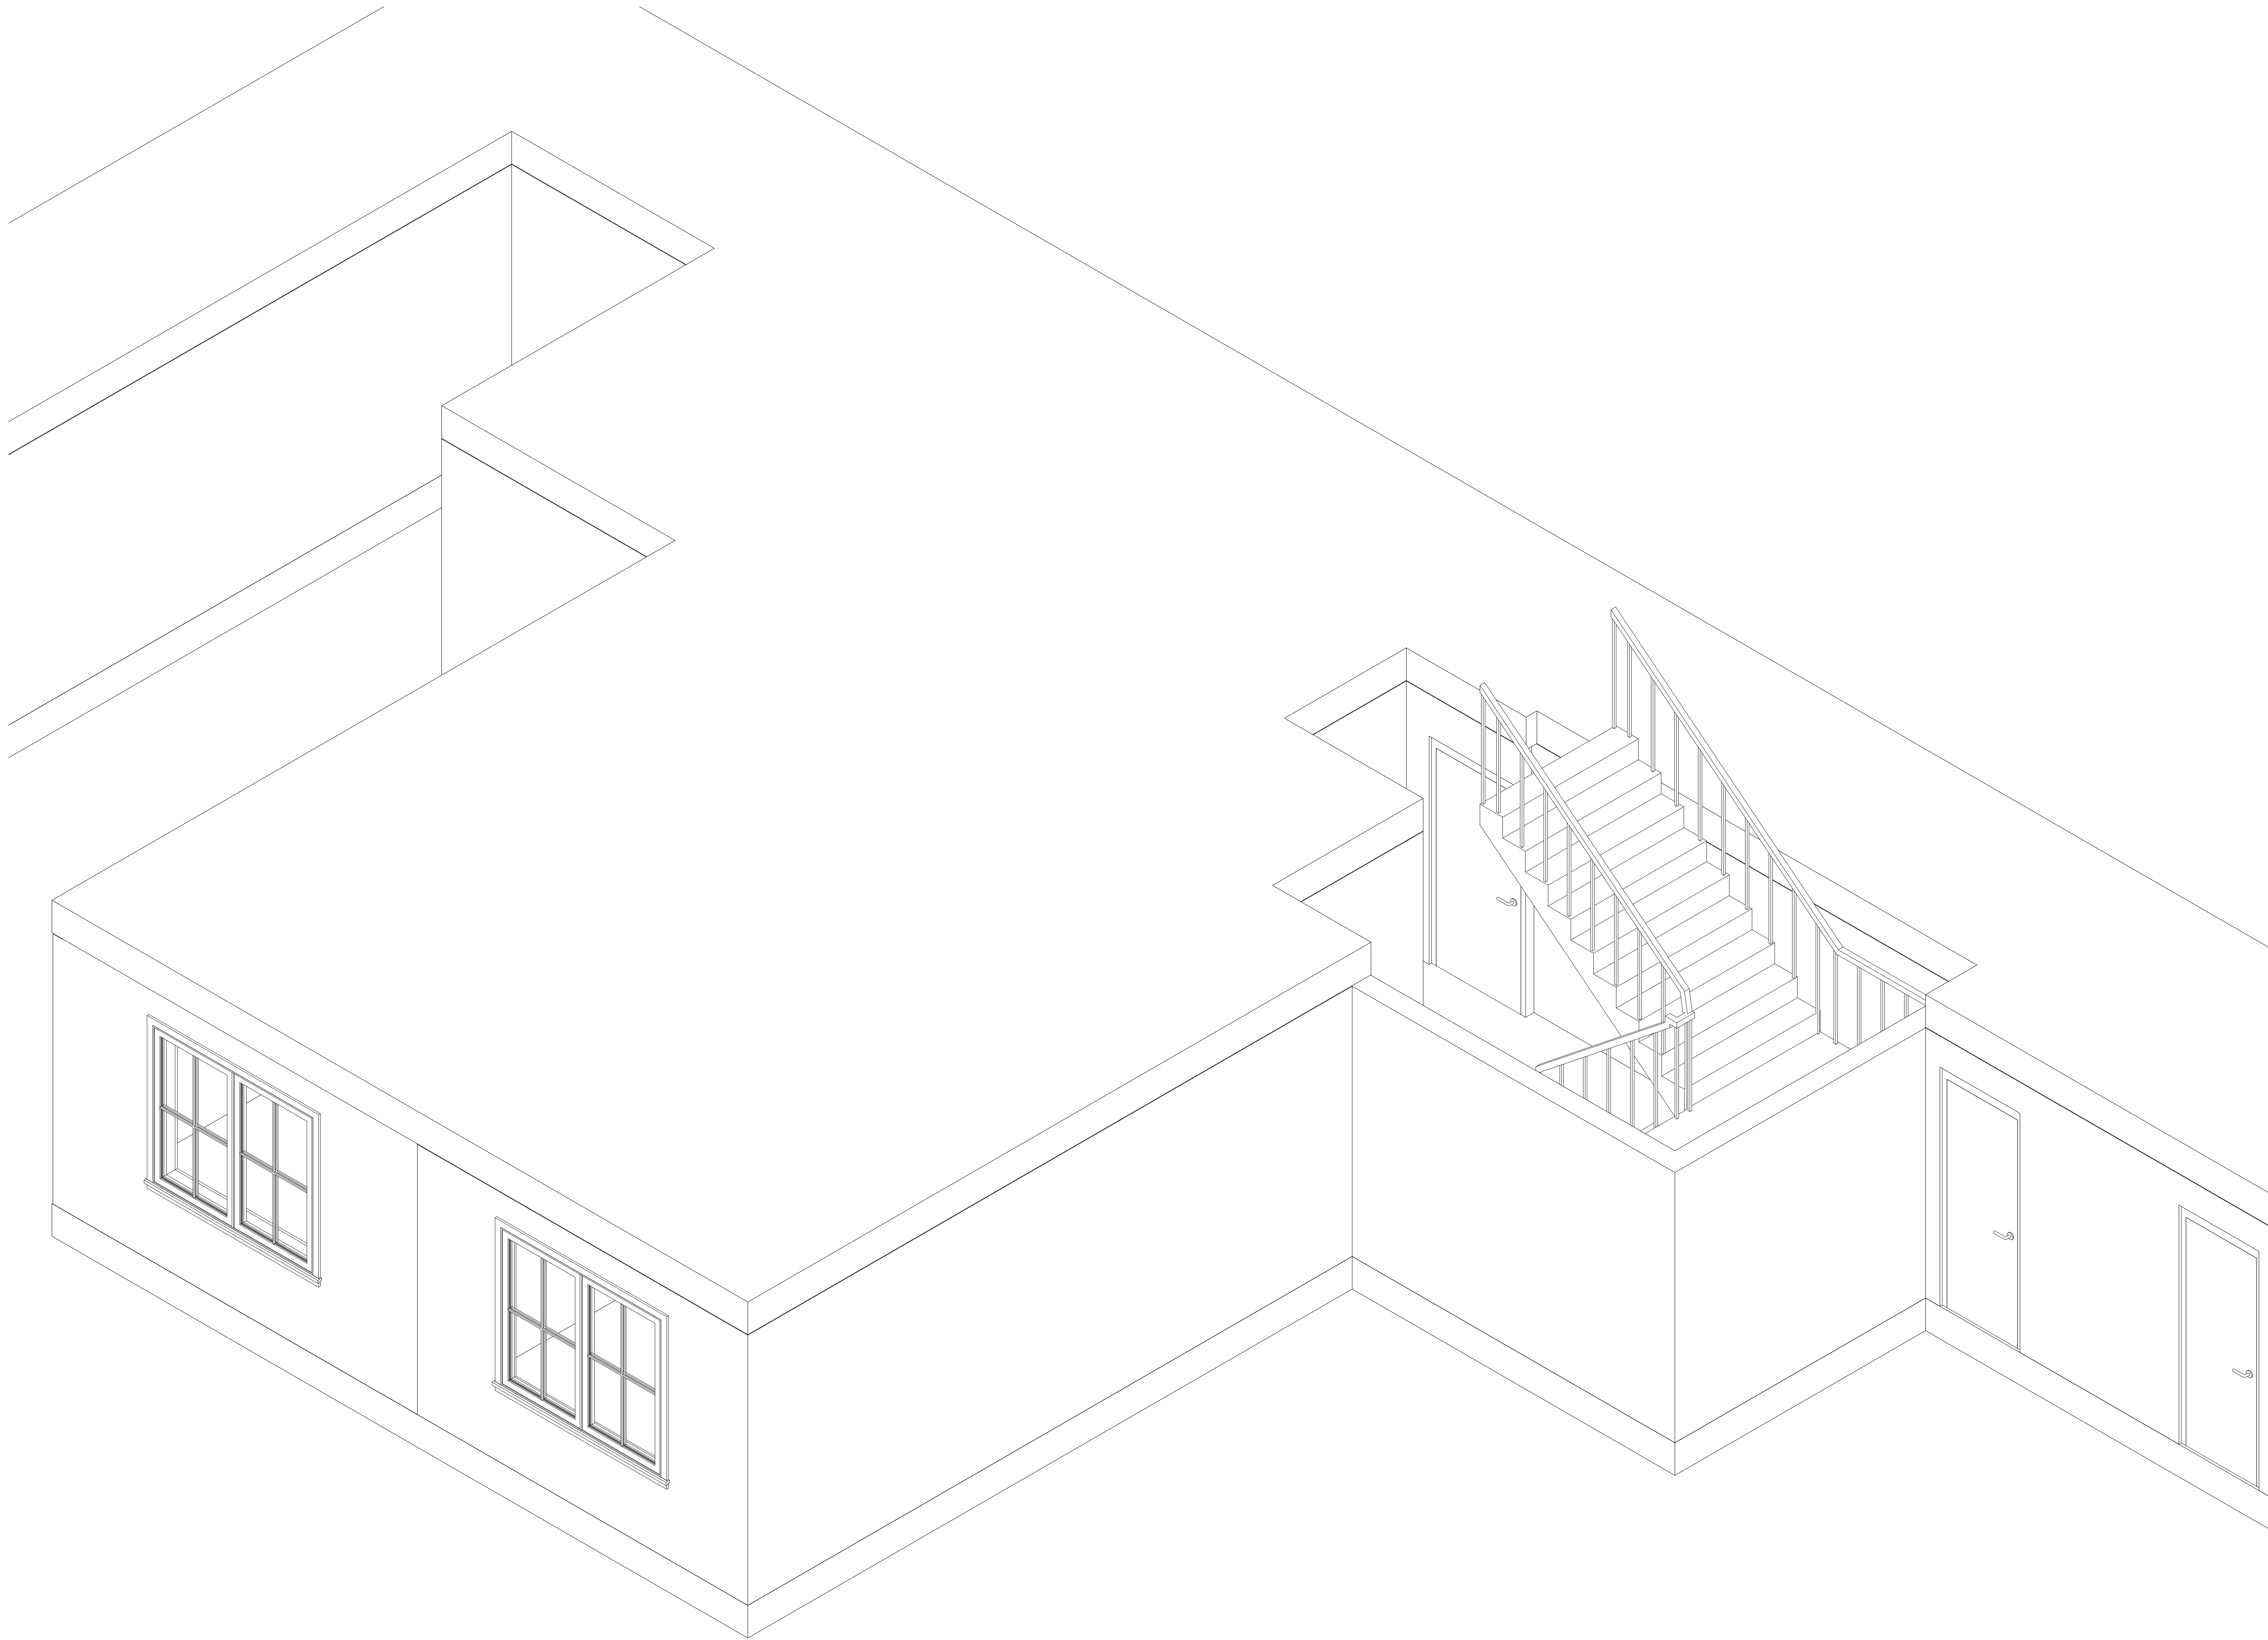

1 {3D}



TECHSCAN
Surveying As Builds and Geospatial Solutions

89-19 171st St #6m

Architectural Enlarged Views

Project number 001

Date Issue Date

Checked by Checker

A401

Scale




18 Spencer St, Brooklyn,
NY 11205

info@TechScanusa.com

TechScanusa.com

(929) 486 9091

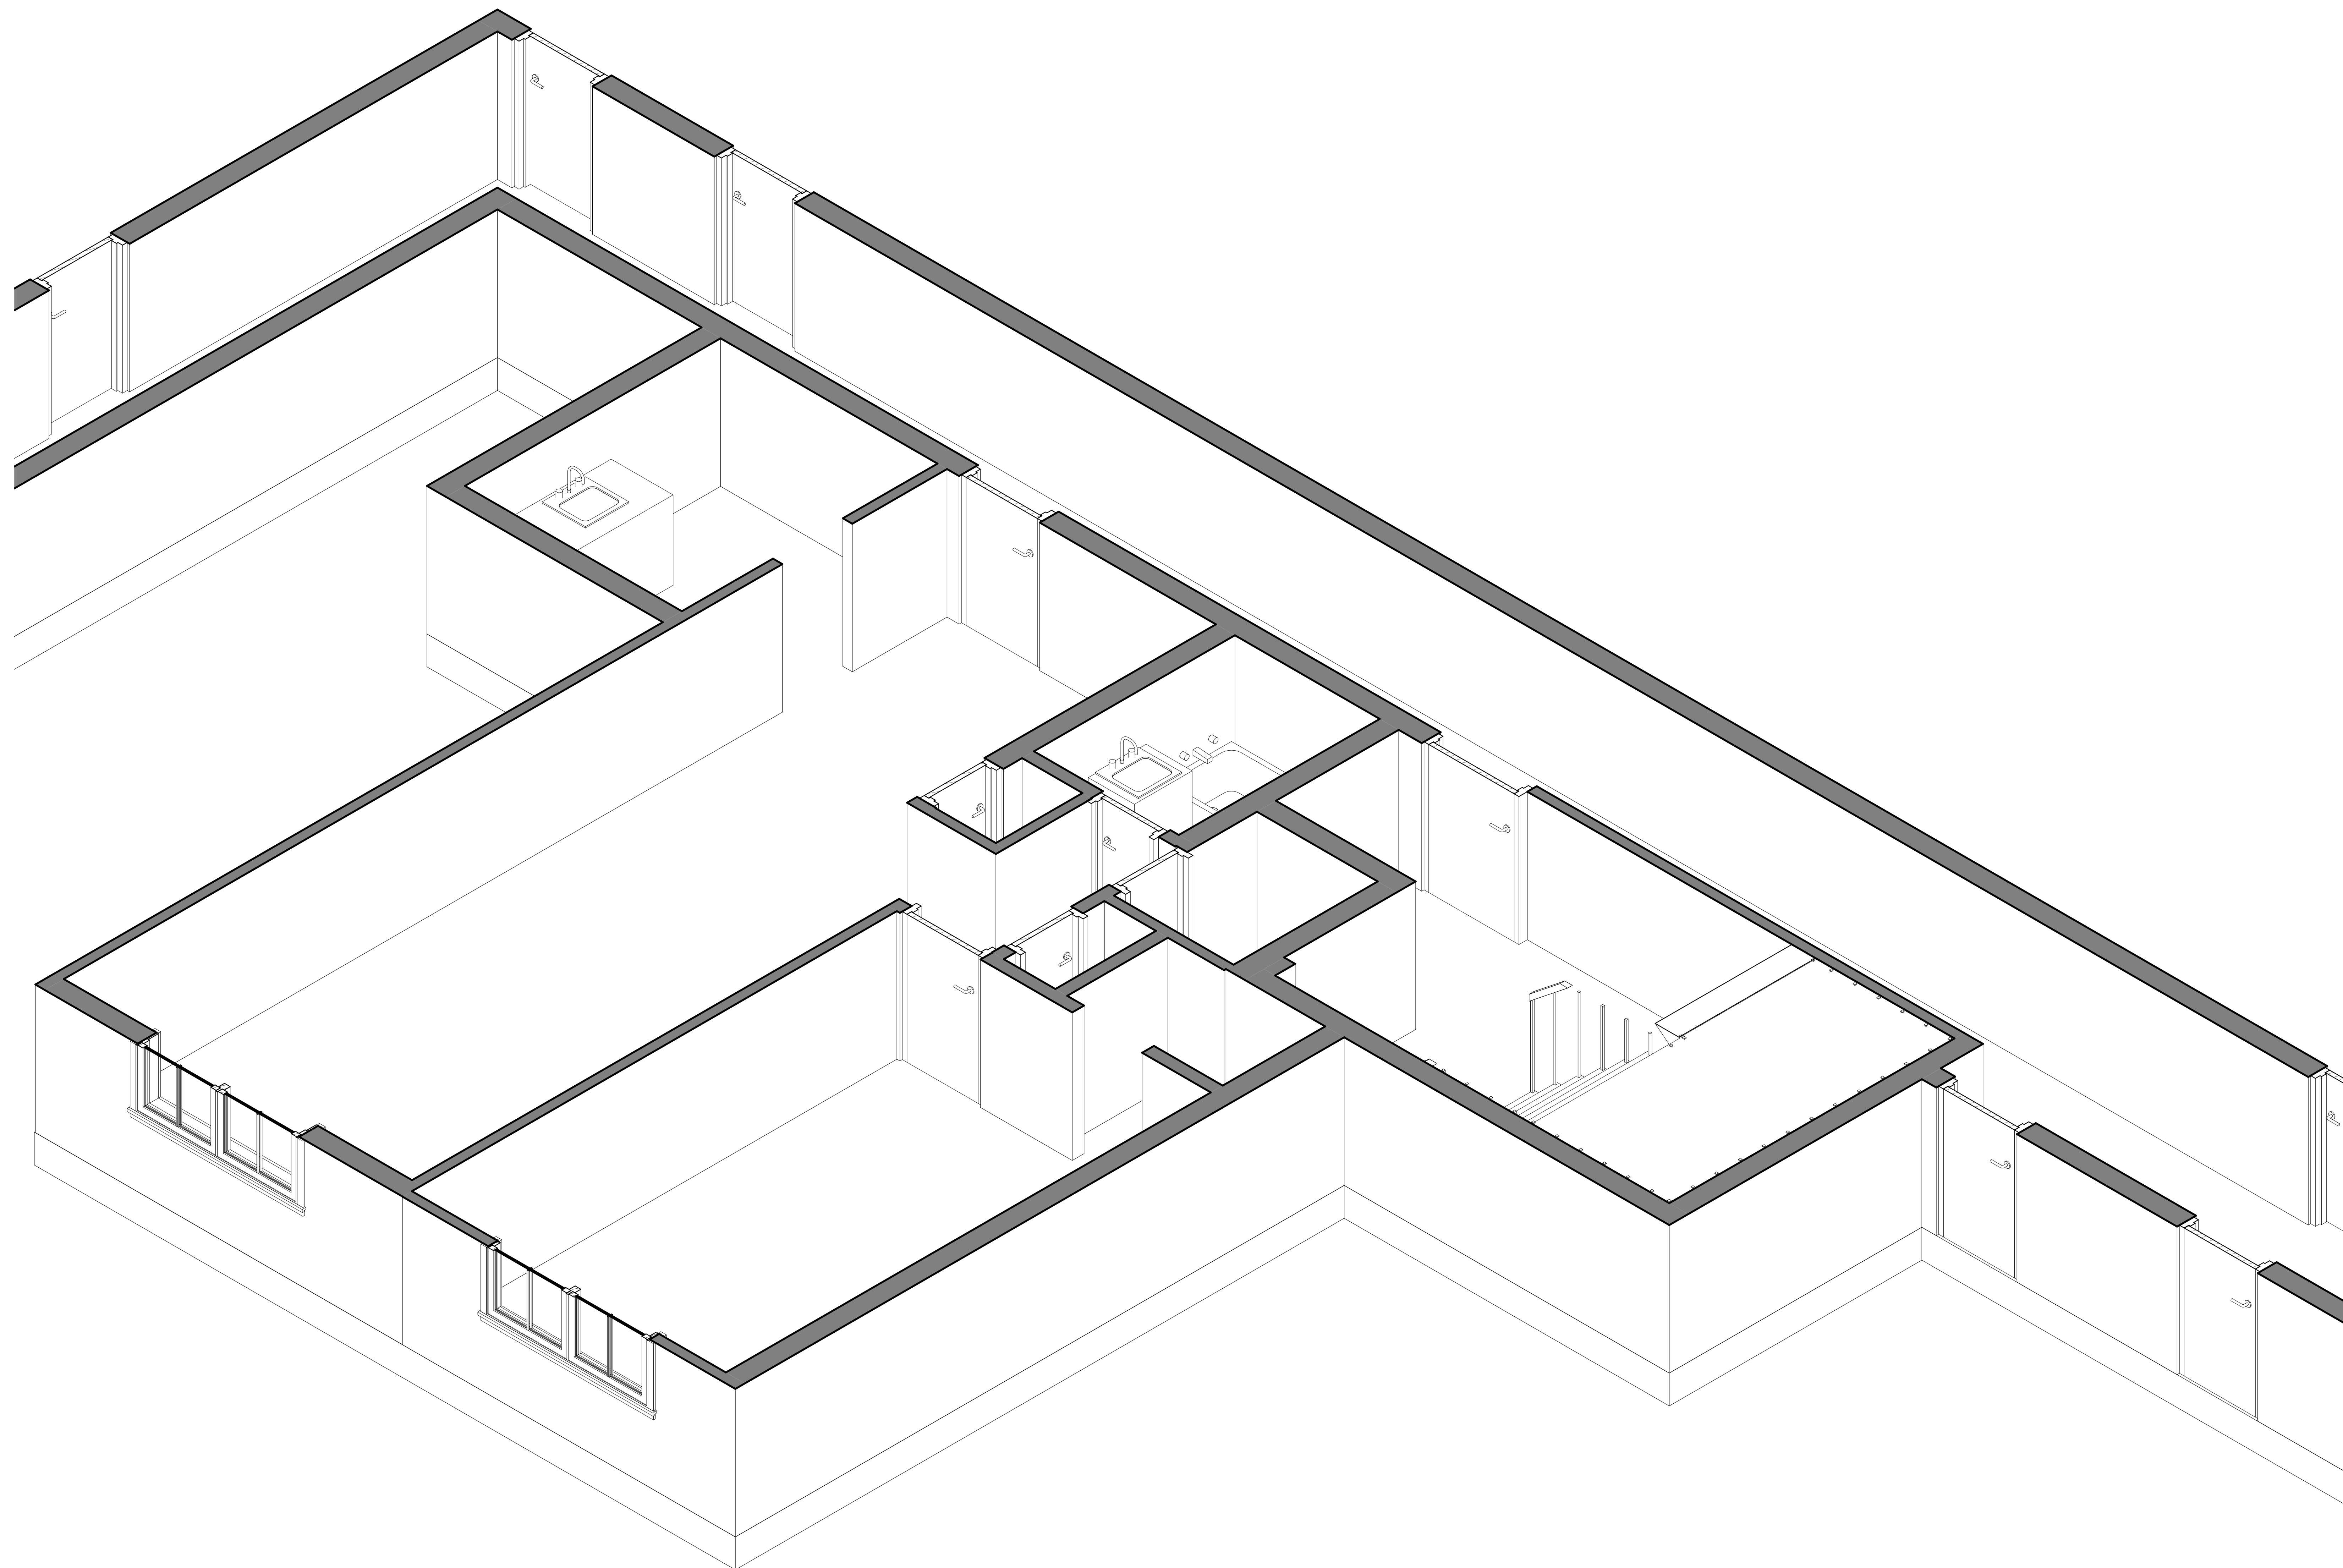

TECHSCAN
Surveying As Builds and Geospatial Solutions

89-19 171st St #6m

Architectural Enlarged Views

Project number 001

Date Issue Date

Checked by Checker

A402

Scale




18 Spencer St, Brooklyn,
NY 11205

info@TechScanusa.com

TechScanusa.com

(929) 486 9091

1 {3D} Copy 1 Copy 1

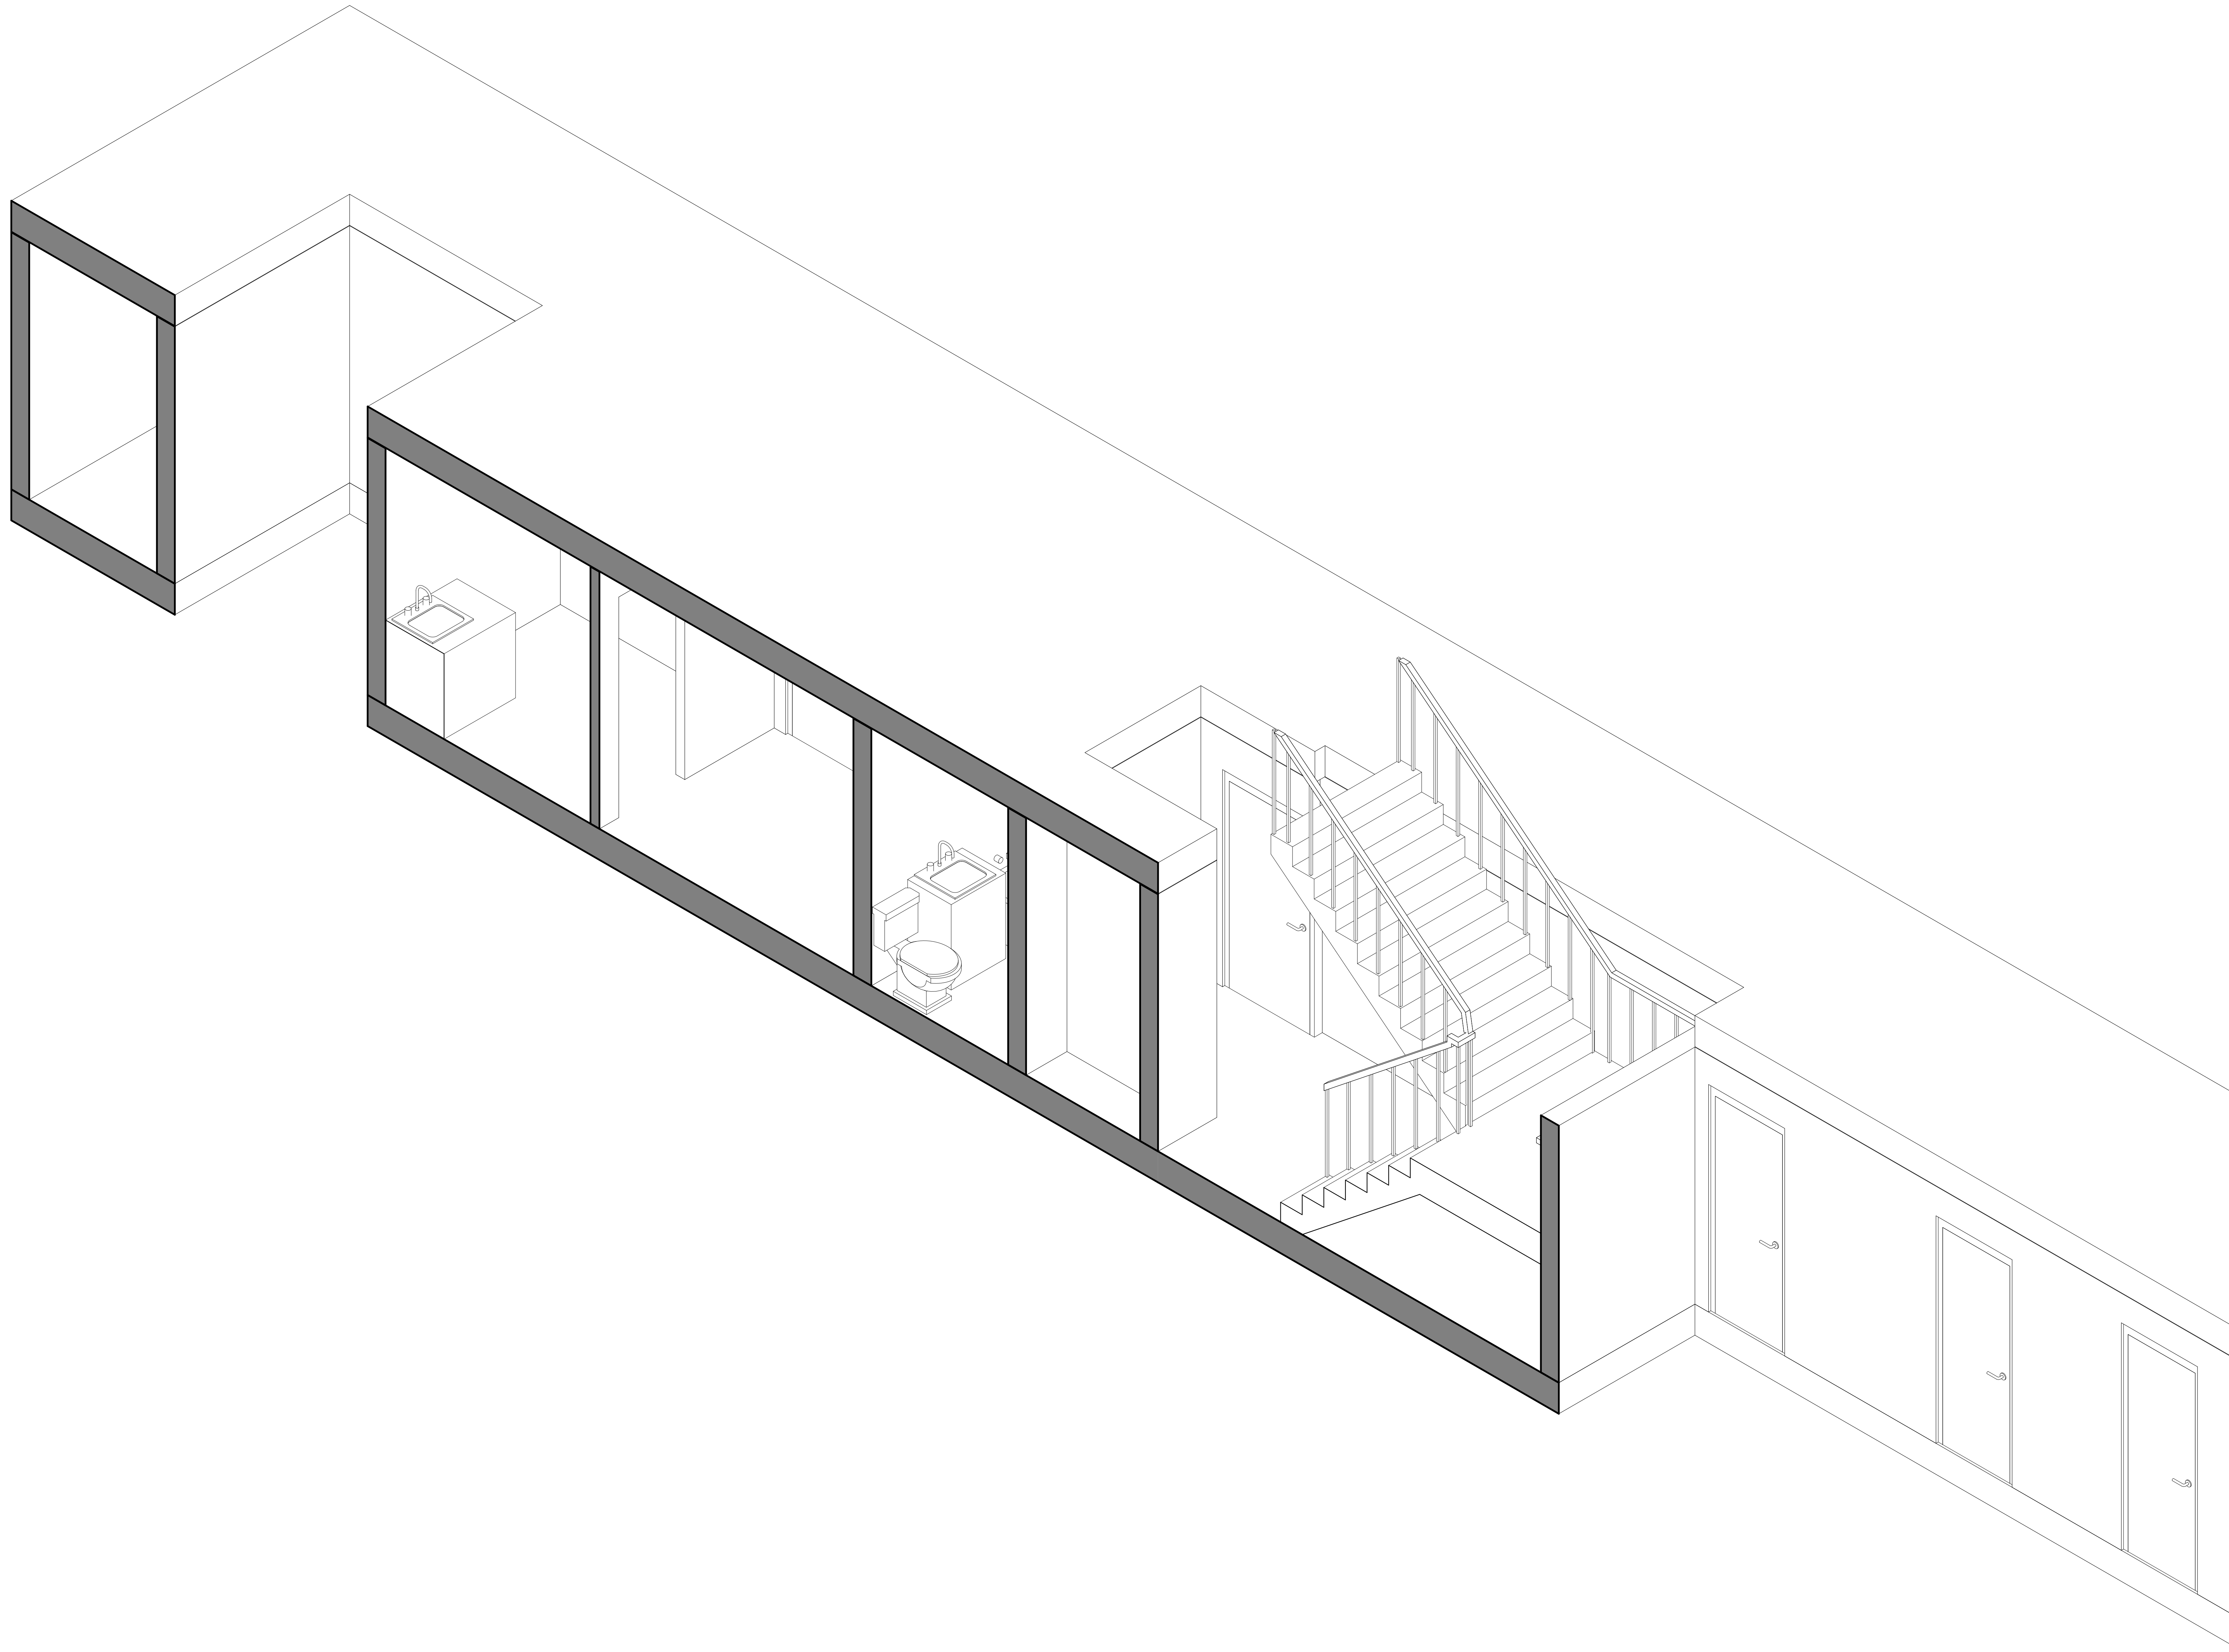

TECHSCAN
Surveying As Builds and Geospatial Solutions

89-19 171st St #6m

Architectural Enlarged Views

Project number 001

Date Issue Date

Checked by Checker

A403

Scale




18 Spencer St, Brooklyn,
NY 11205

info@TechScanusa.com

TechScanusa.com

(929) 486 9091

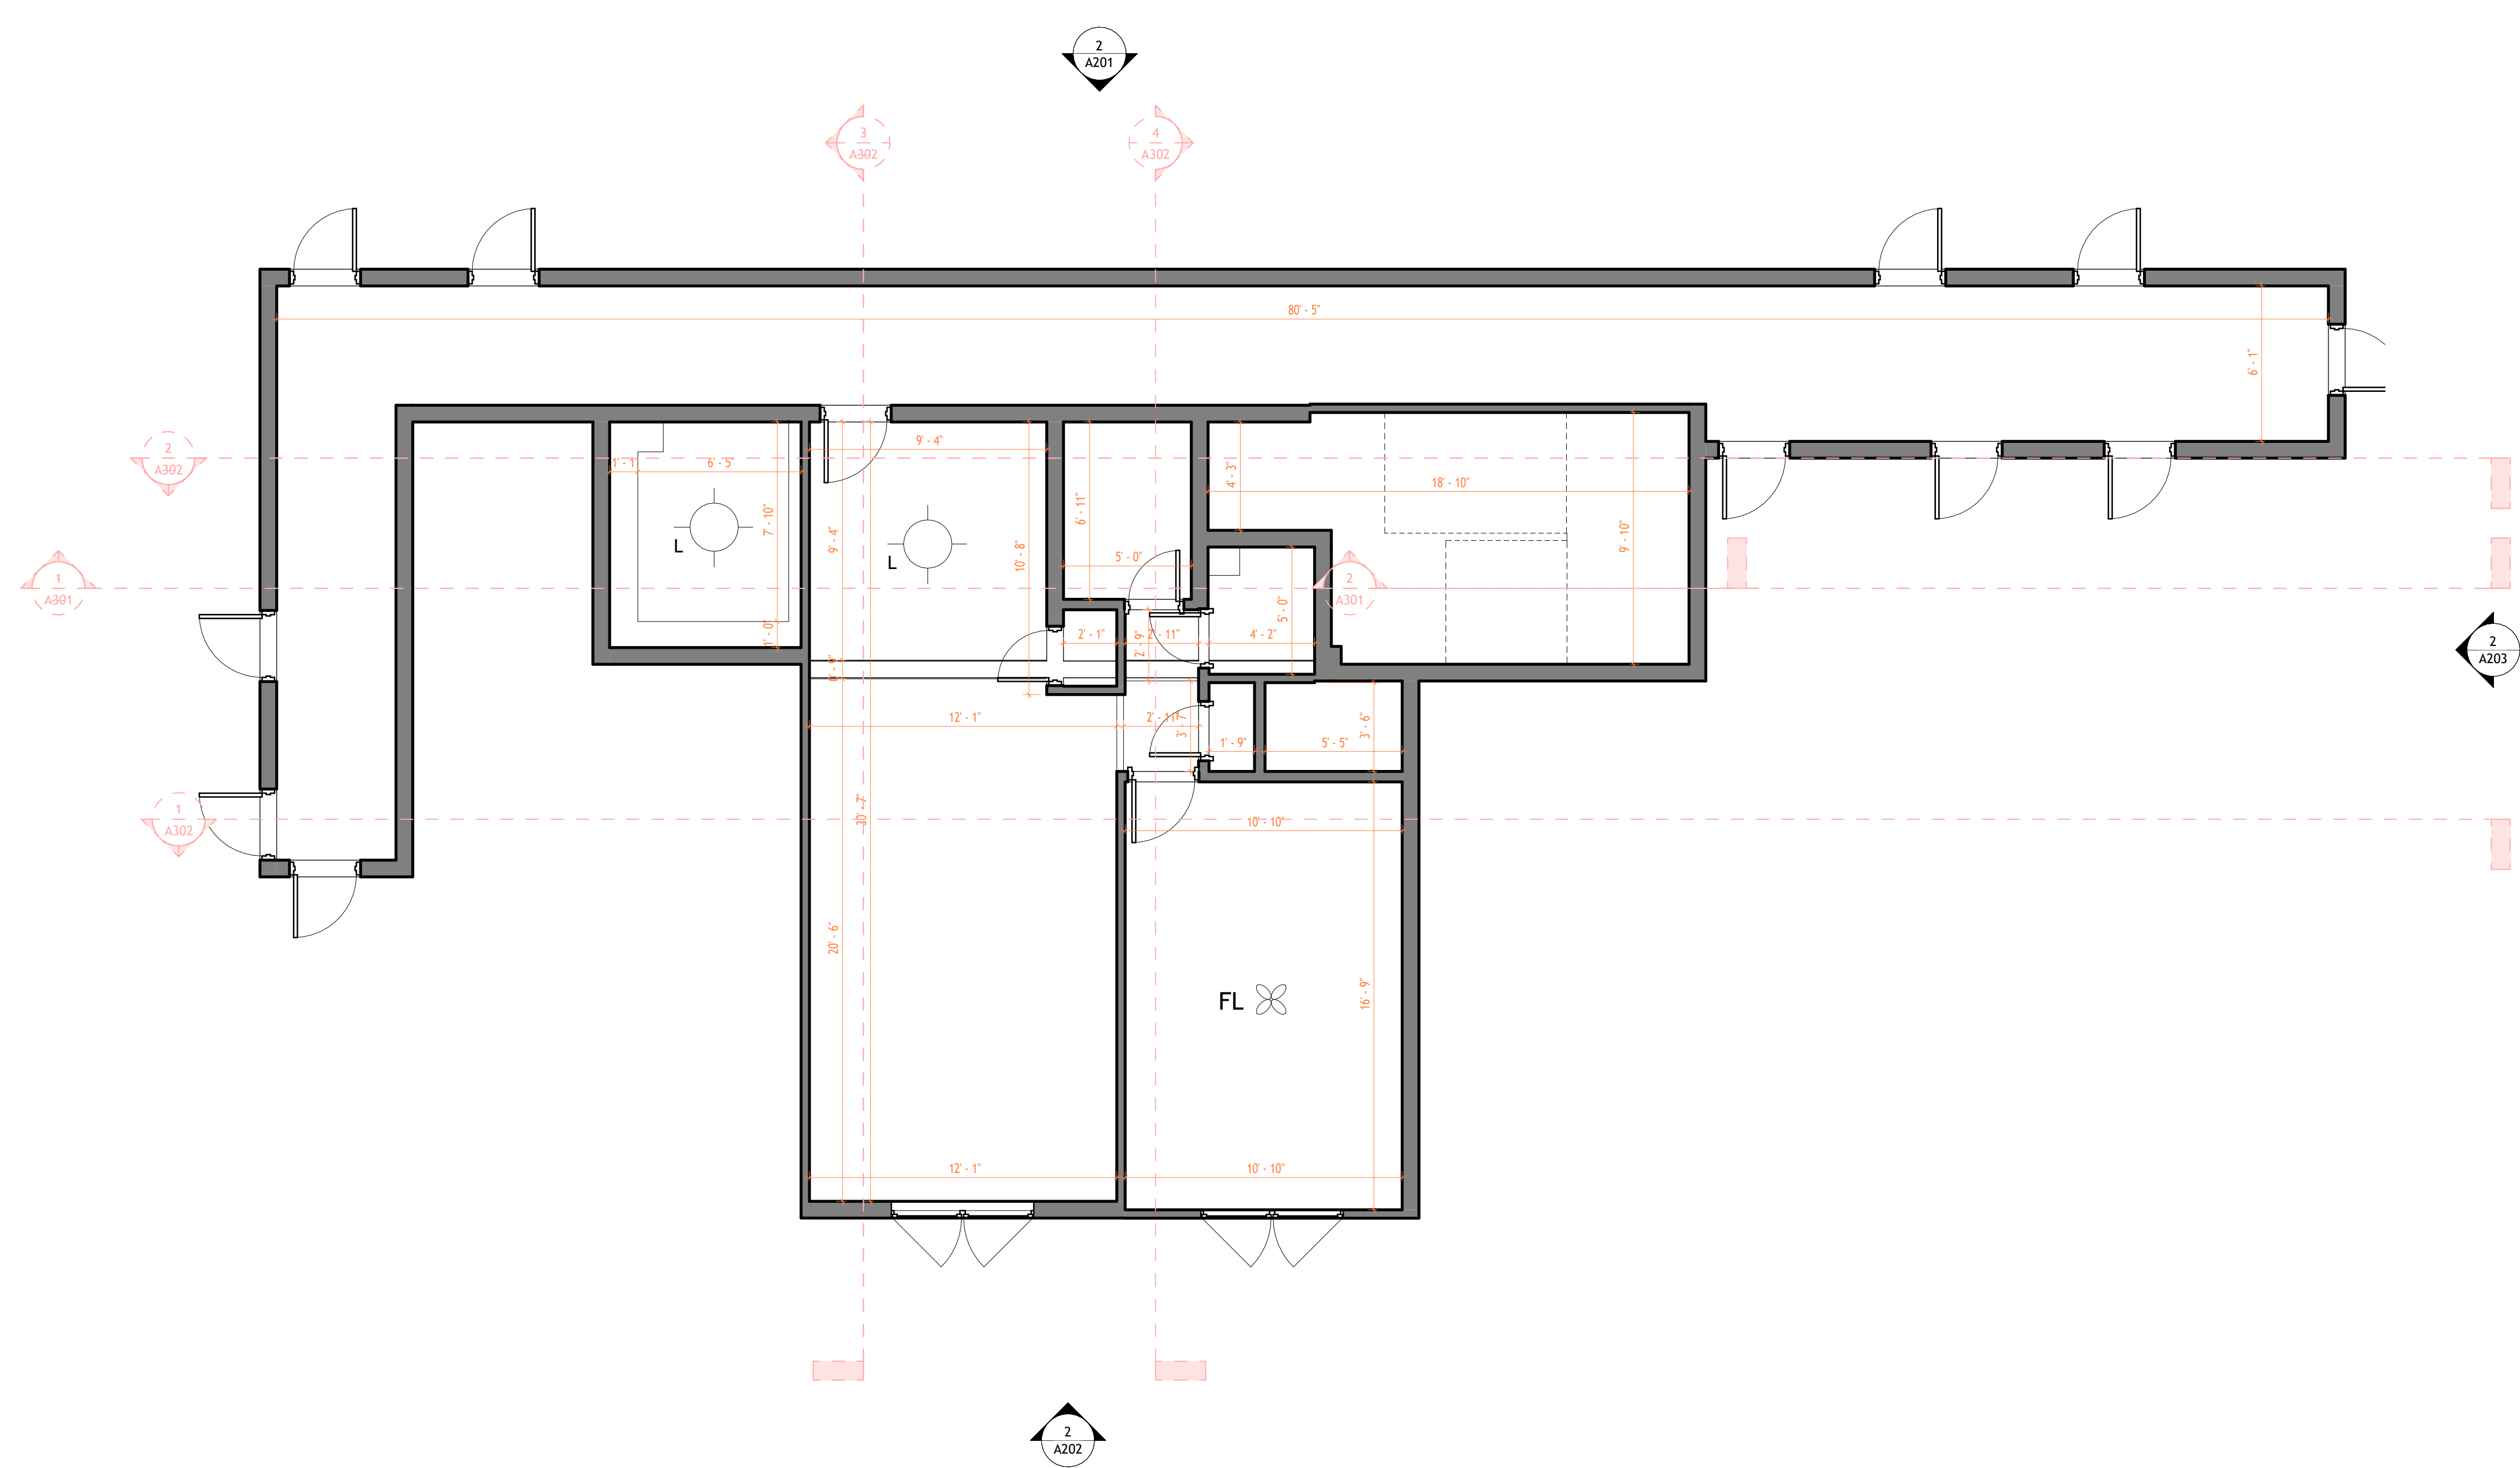

1 First Floor Architectural
Ceiling Plan
1:50




TECHSCAN
Surveying As Builds and Geospatial Solutions


89-19 171st St #6m	
Architectural RCP Plans	
Project number	001
Date	Issue Date
Checked by	Checker
A601	
Scale	1 : 50




18 Spencer St, Brooklyn,
NY 11205
info@TechScanusa.com
TechScanusa.com
(929) 486 9091

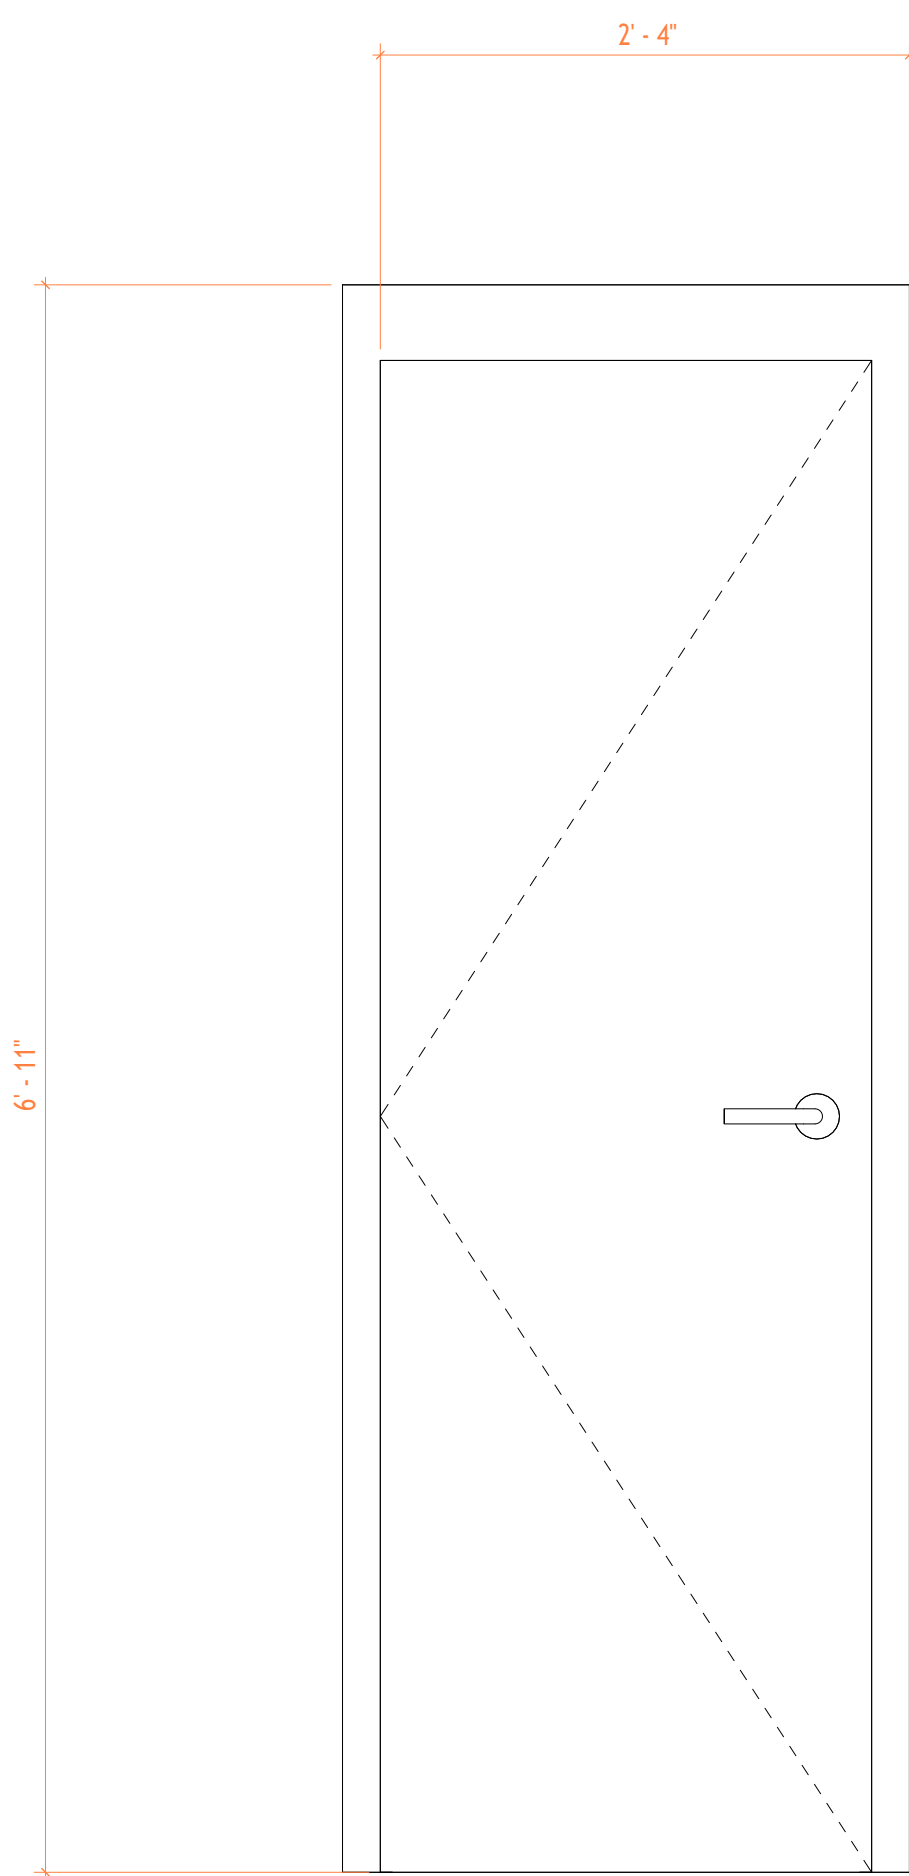


D-01

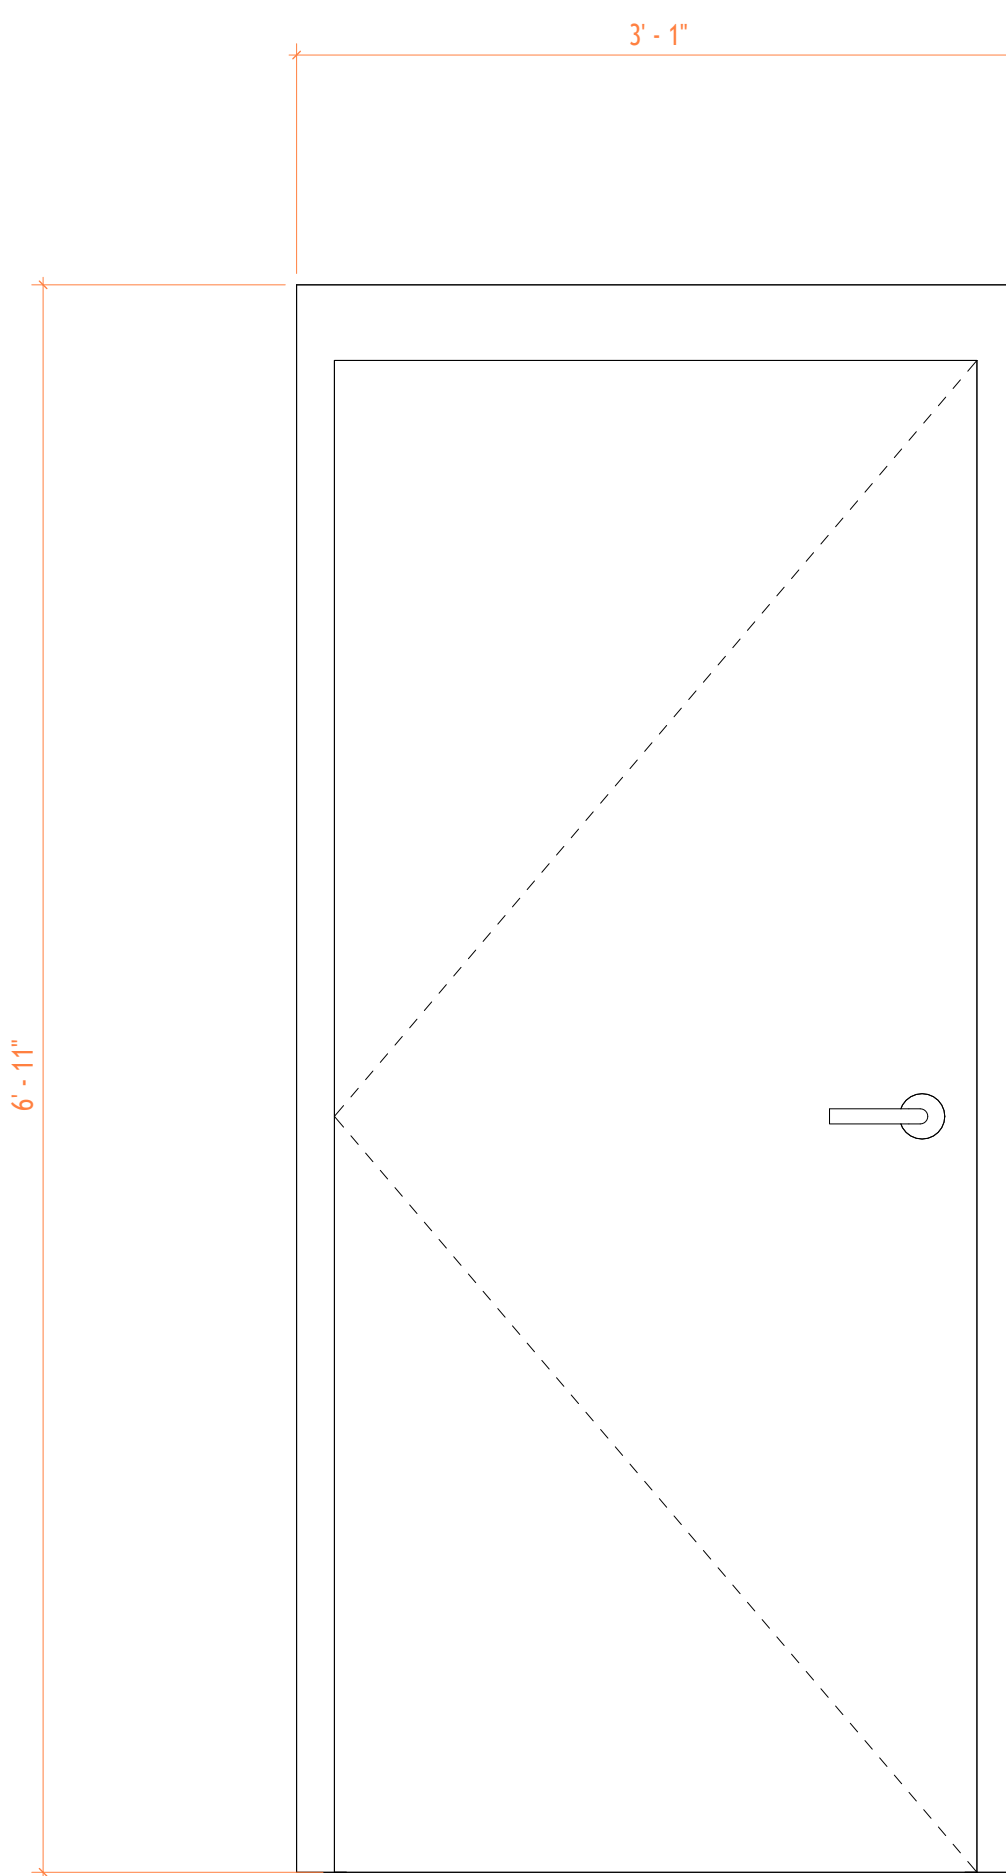


D-02

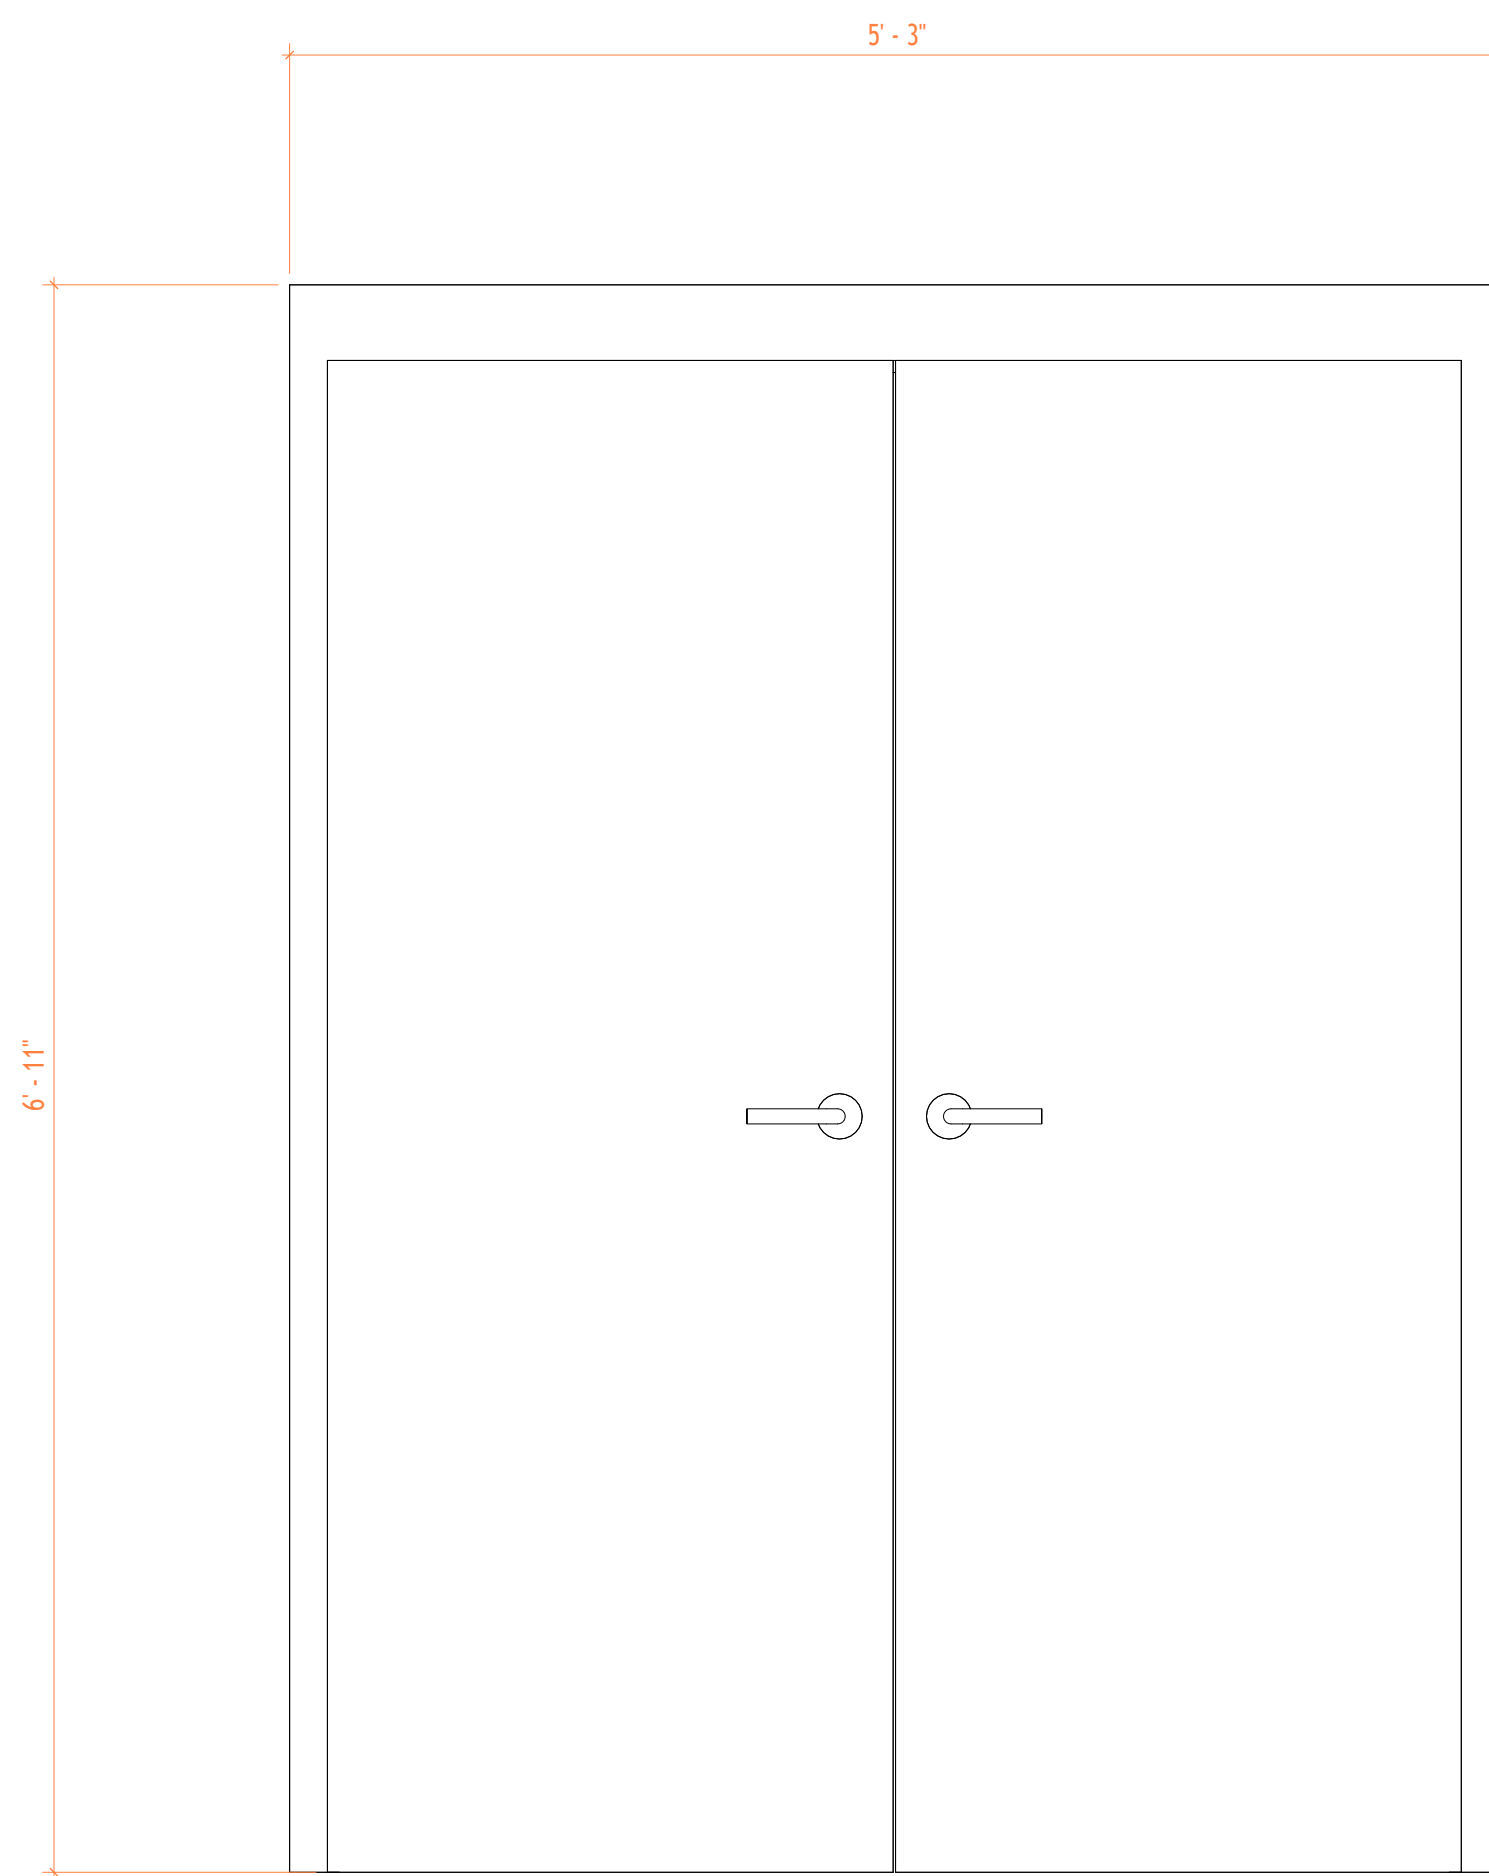







D-03

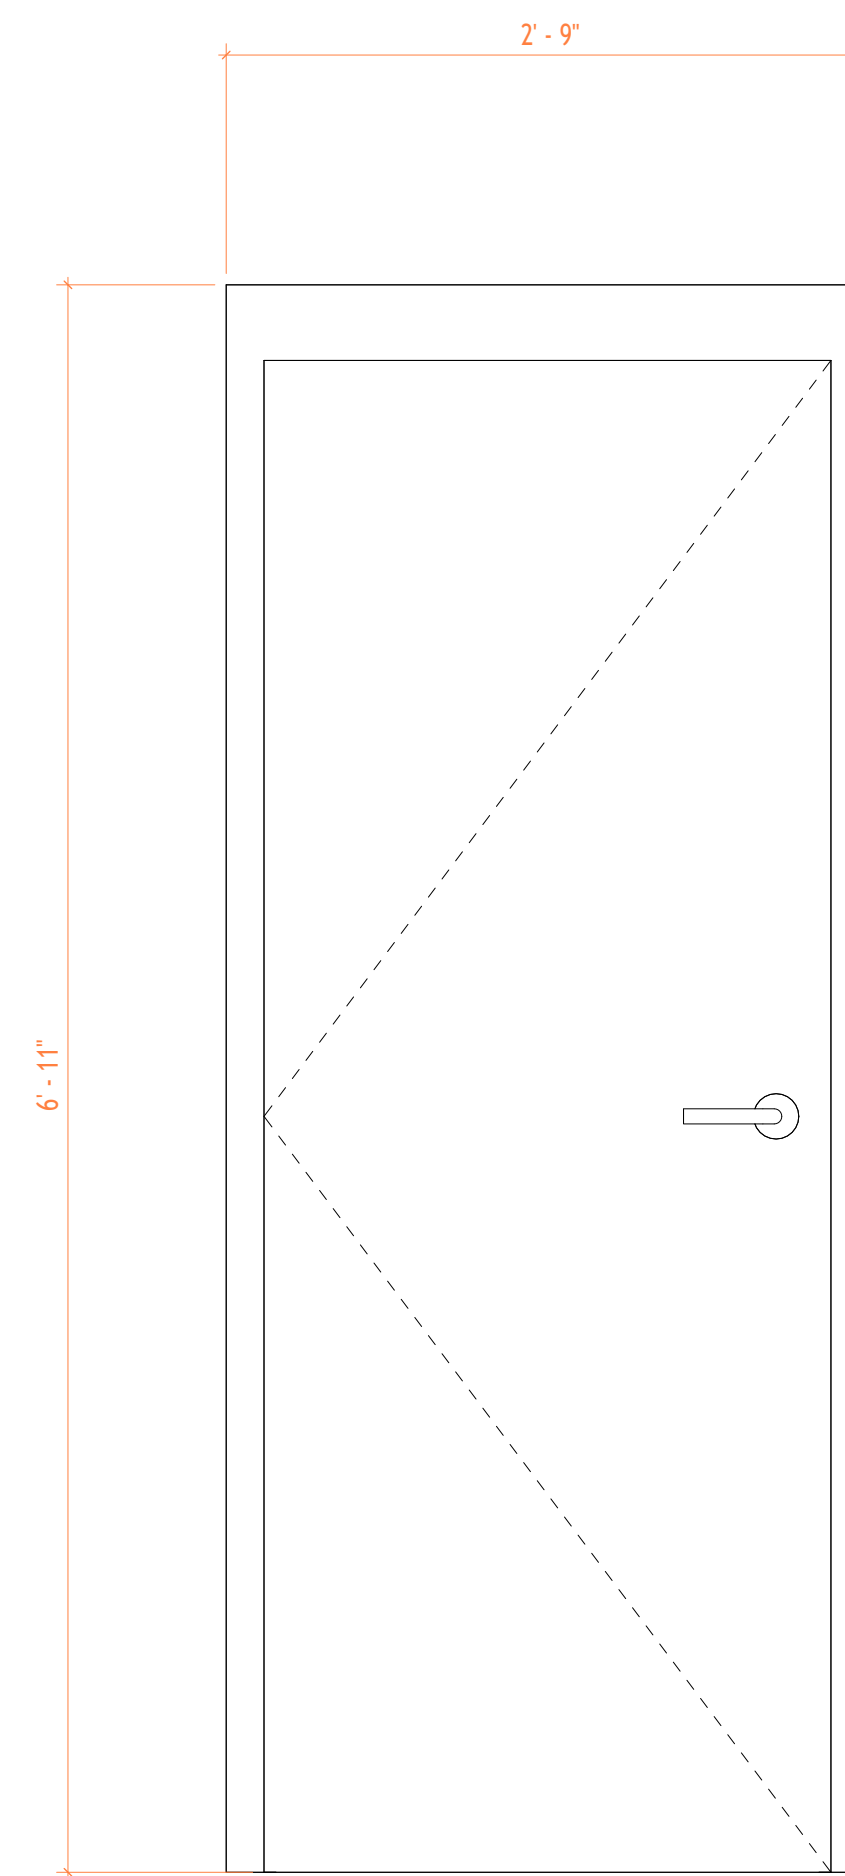


D-04

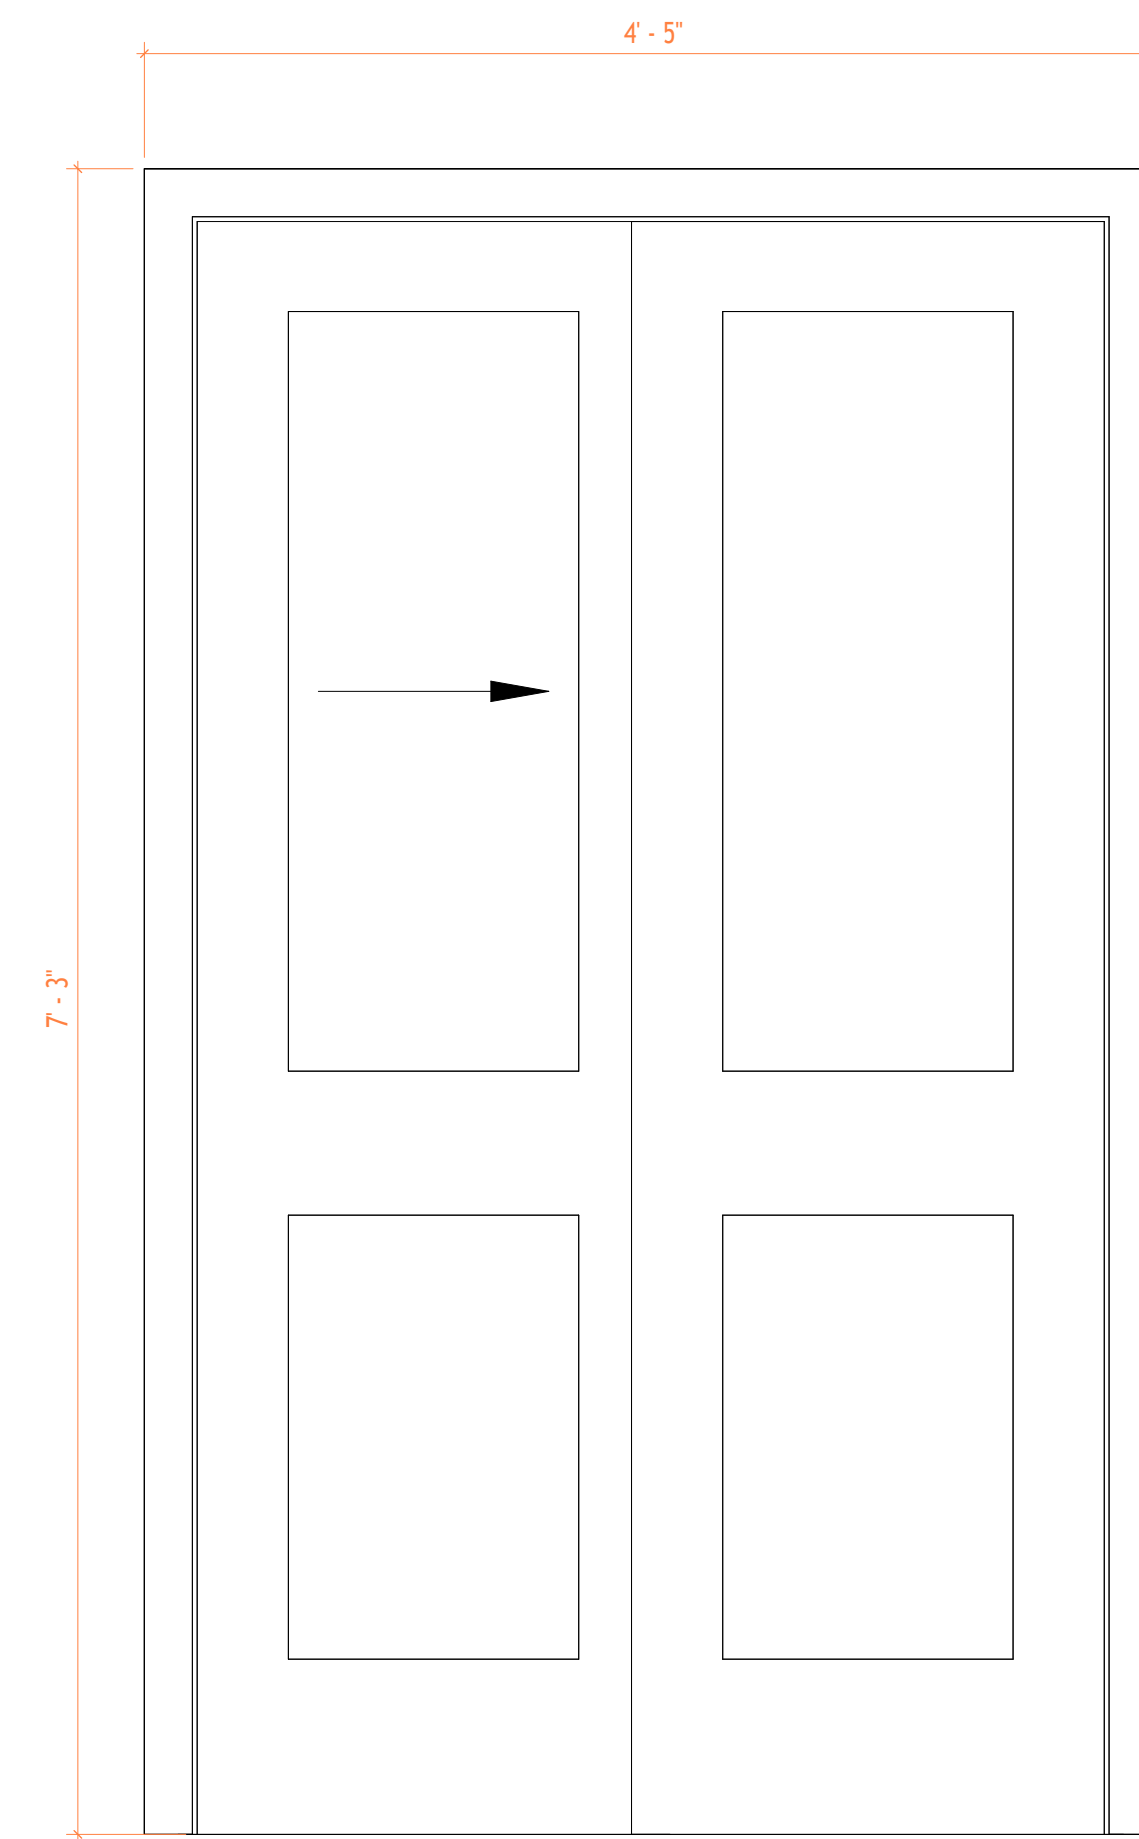


D-05

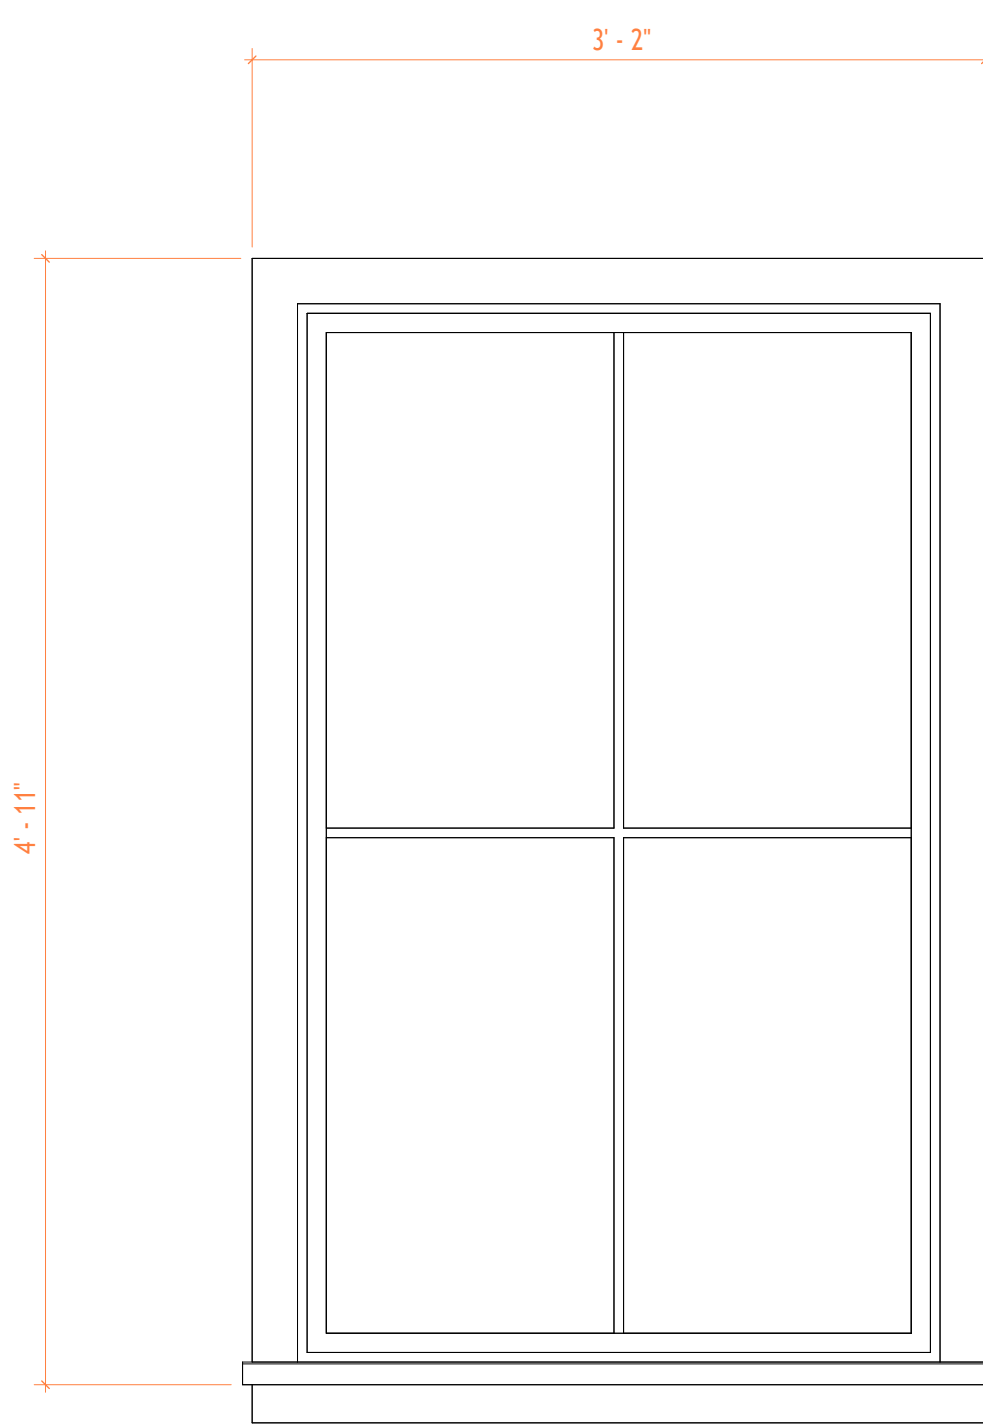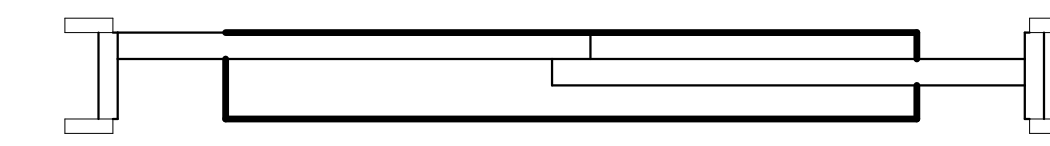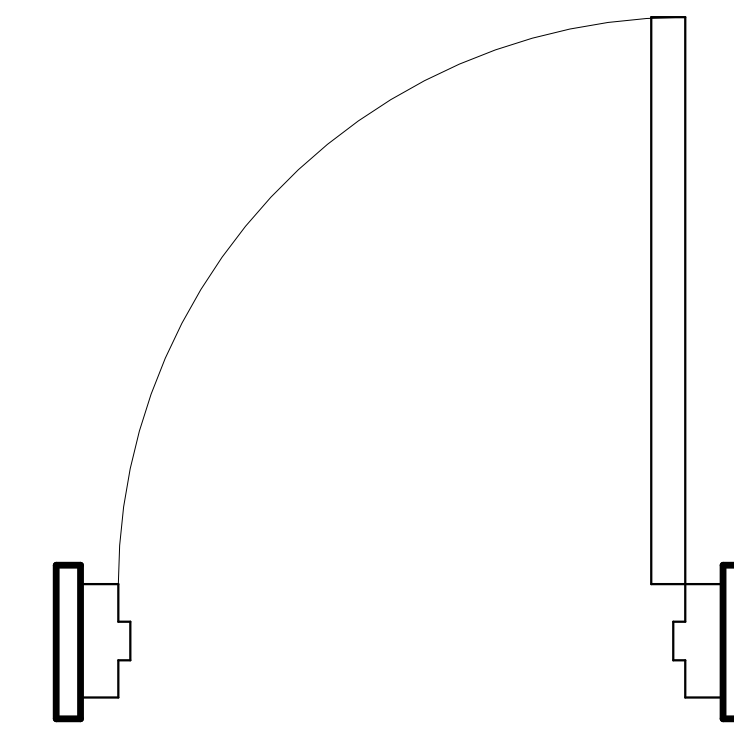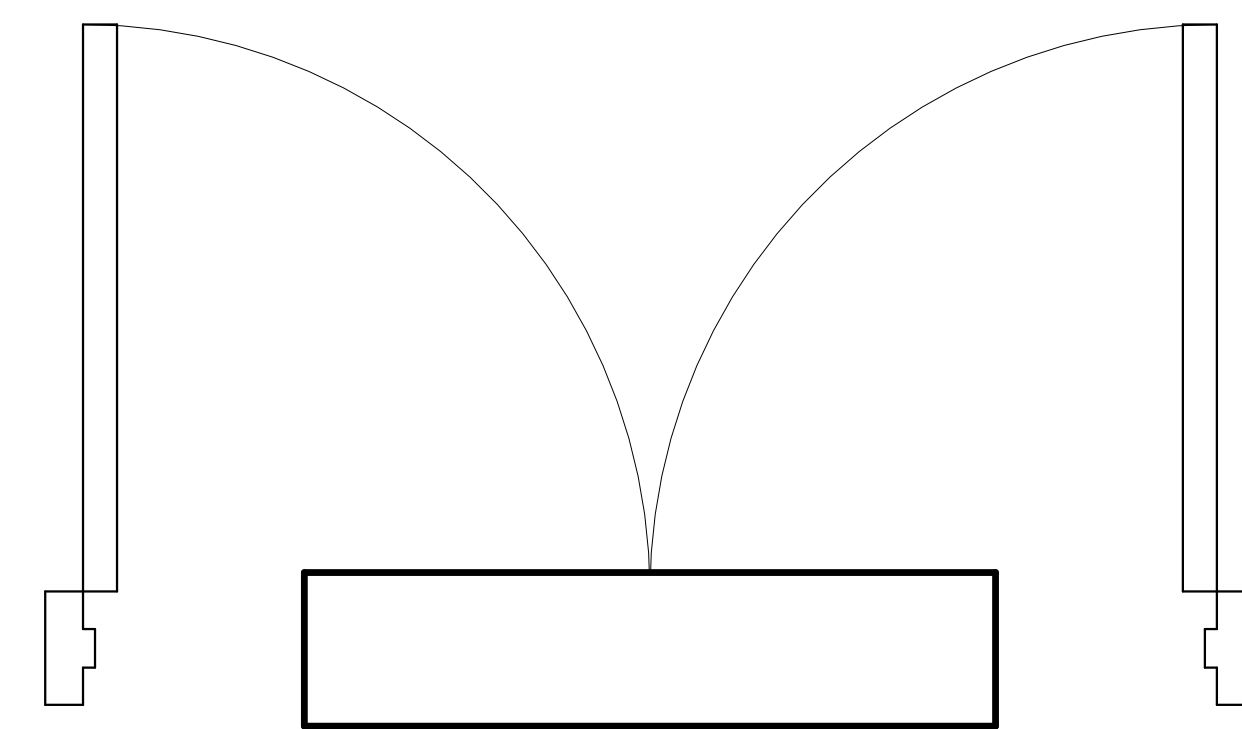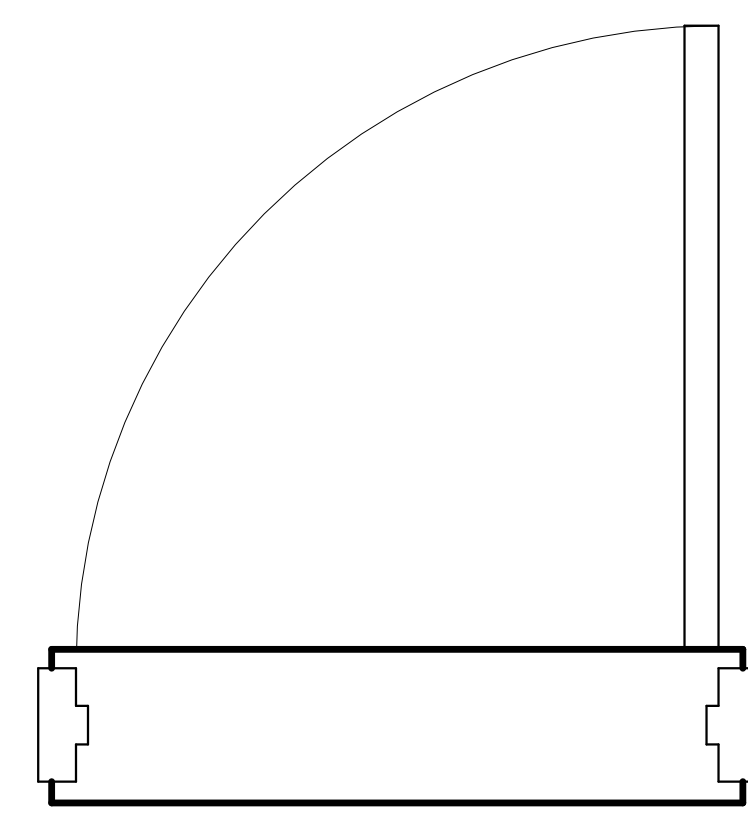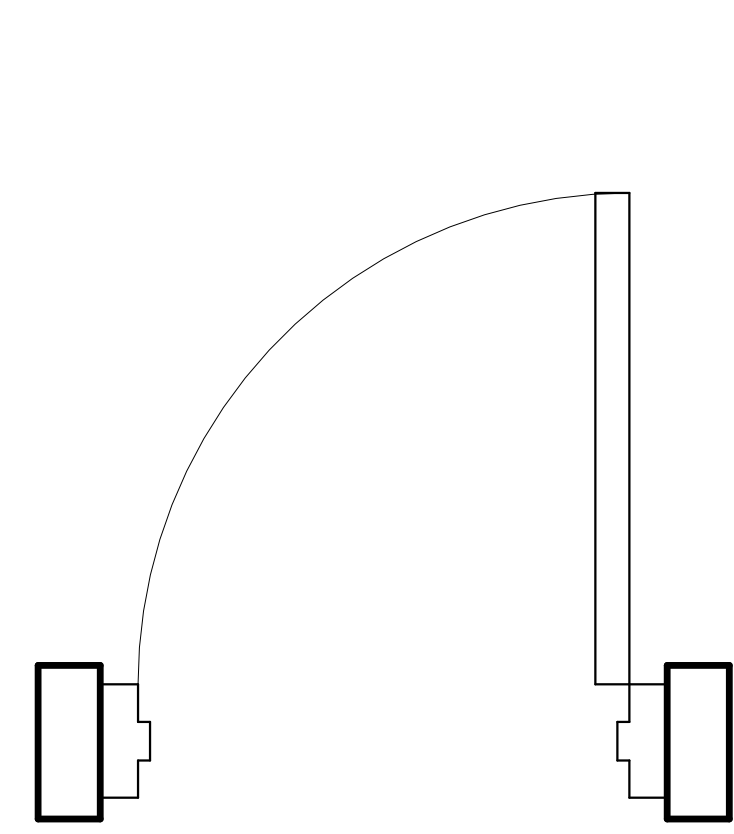

WN-01

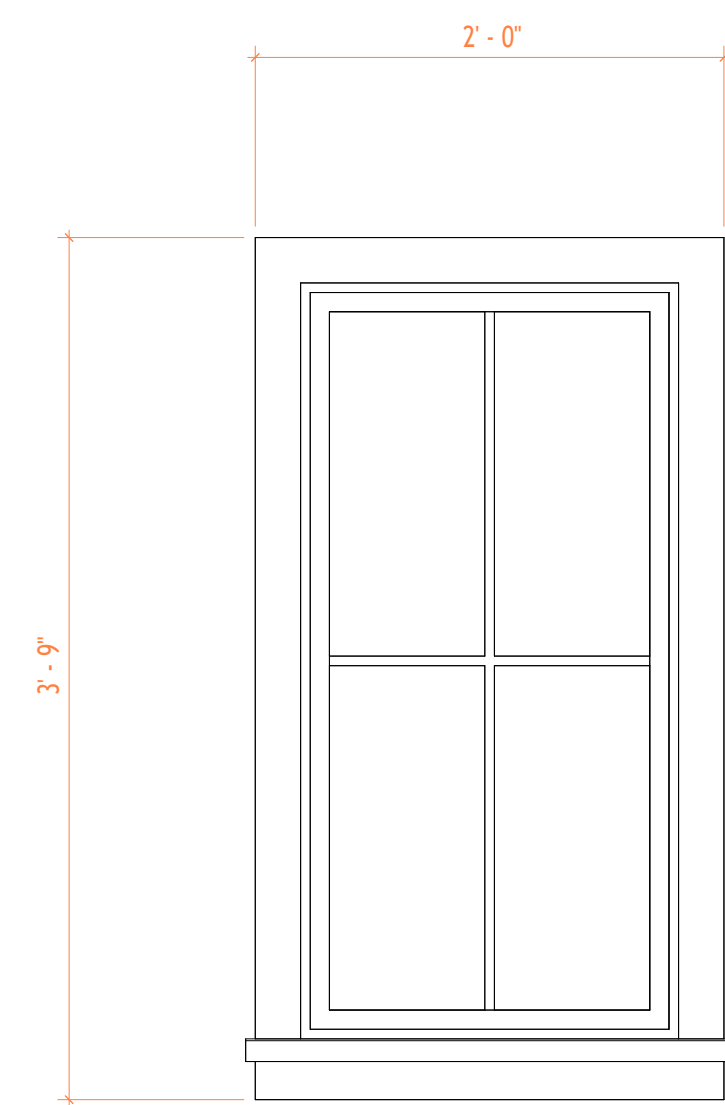

WN-02

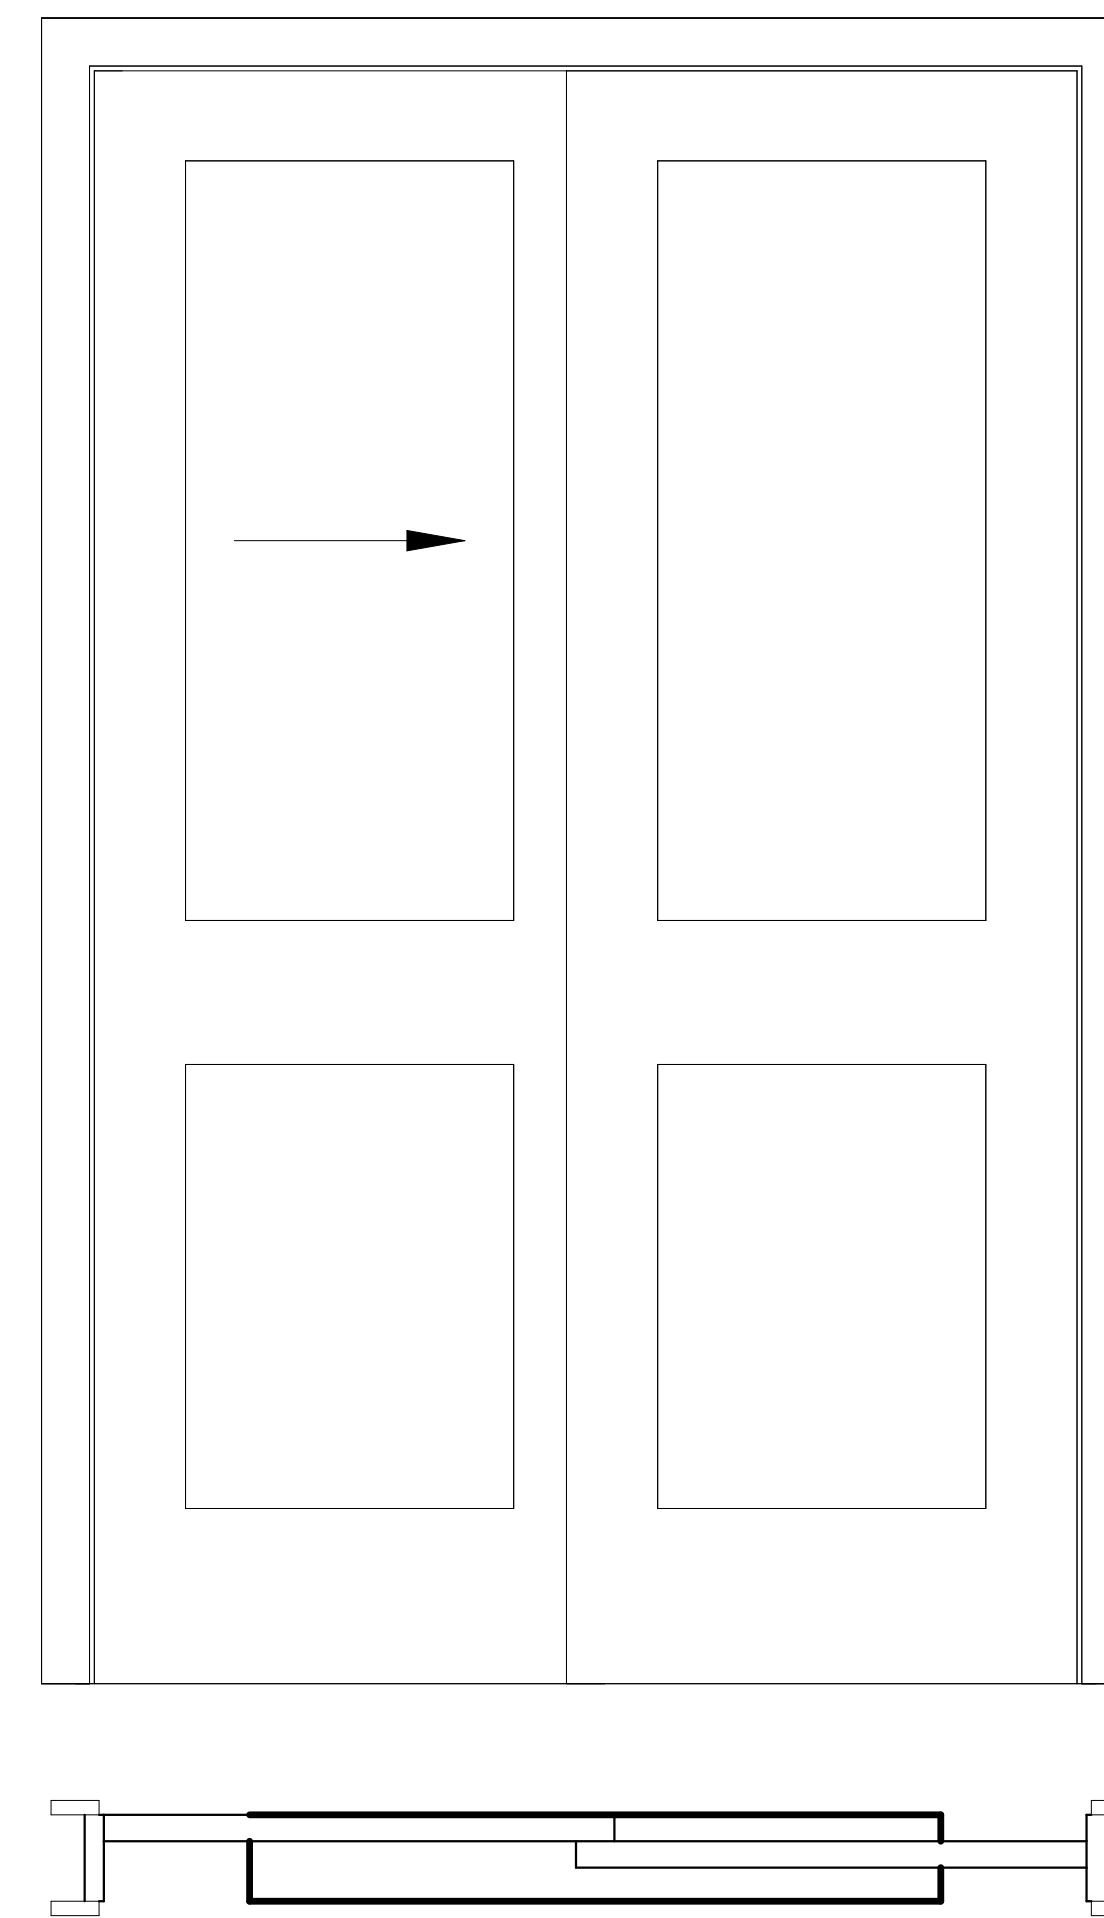

D-06

Mark	Door Size			Hardware From Room: Number
	Width	Height	Thickness	
D-02	2'-9"	6'-7"	0'-2"	134
D-01	2'-2"	6'-7"	0'-2"	108
D-01	2'-2"	6'-7"	0'-2"	108
D-01	2'-2"	6'-7"	0'-2"	110
D-02	2'-9"	6'-7"	0'-2"	134
D-03	4'-11"	6'-7"	0'-2"	
D-01	2'-2"	6'-7"	0'-2"	
D-02	2'-9"	6'-7"	0'-2"	111
D-04	2'-6"	6'-7"	0'-2"	114
D-01	2'-2"	6'-7"	0'-2"	102
111	0'-0"	0'-0"		
112	0'-0"	0'-0"		109
113	0'-0"	0'-0"		102
114	0'-0"	0'-0"		109
D-02	2'-9"	6'-7"	0'-2"	114
116	0'-0"	0'-0"		
117	0'-0"	0'-0"		105
118	0'-0"	0'-0"		107
D-01	2'-2"	6'-7"	0'-2"	112
120	0'-0"	0'-0"		112
121	0'-0"	0'-0"		113
D-02	2'-9"	6'-7"	0'-2"	134
D-02	2'-9"	6'-7"	0'-2"	134
D-02	2'-9"	6'-7"	0'-2"	134
D-01	2'-2"	6'-7"	0'-2"	133
D-17	0'-0"	0'-0"		133
D-18	0'-0"	0'-0"		133
D-01	2'-2"	6'-7"	0'-2"	133
D-06	4'-3"	7'-0"	0'-1"	126
D-01	2'-2"	6'-7"	0'-2"	130
D-01	2'-2"	6'-7"	0'-2"	130
D-05	3'-11"	7'-0"	0'-1"	135
D-14	2'-6"	6'-11"	0'-2"	134
D-15	2'-11"	6'-7"	0'-2"	134
D-23	2'-6"	6'-11"	0'-2"	134
D-24	2'-6"	6'-11"	0'-2"	134
D-25	2'-6"	6'-11"	0'-2"	134
D-26	2'-6"	6'-11"	0'-2"	134
D-27	2'-6"	6'-11"	0'-2"	134
D-28	2'-6"	6'-11"	0'-2"	134
D-29	2'-0"	6'-11"	0'-2"	136
D-30	2'-6"	6'-11"	0'-2"	136
D-31	2'-0"	6'-11"	0'-2"	140
D-32	2'-0"	6'-11"	0'-2"	140
D-33	2'-0"	6'-11"	0'-2"	136
D-35	0'-0"	0'-0"		141
135	0'-0"	0'-0"		138

Type Mark	Window Size			Head Height
	Width	Height	Head	
W-01	2'-9"	4'-7"	8'-0"	
W-01	2'-9"	4'-7"	7'-7"	
W-01	2'-9"	4'-7"	7'-7"	
W-01	2'-9"	4'-7"	7'-7"	
W-01	2'-9"	4'-7"	7'-10"	
W-01	2'-9"	4'-7"	7'-7"	
W-01	2'-9"	4'-7"	7'-10"	
W-01	2'-9"	4'-7"	7'-11"	
W-01	2'-9"	4'-7"	7'-10"	
W-02	1'-8"	3'-3"	7'-7"	
W-01	2'-9"	4'-7"	8'-0"	
W-01	2'-9"	4'-7"	7'-11"	
W-01	2'-9"	4'-7"	7'-10"	
W-01	2'-9"	4'-7"	7'-7"	
W-01	2'-9"	4'-7"	7'-7"	
Z6	3'-11"	4'-11"	7'-4"	
Z6	3'-11"	4'-11"	7'-4"	



TECHSCAN
Surveying As Builds and Geospatial Solutions

Project Name	
Architectural Details	
Project number	Project Number
Date	Issue Date
Checked by	Checker
	A502
Scale	1 : 10



18 Spencer St, Brooklyn, NY 11205
info@techscanusa.com
TechScanusa.com
(929) 486-9031